

ADDENDUM NO. 2

01-11-2024

PROJECT:

Porterville College Sports Complex (PC Baseball/ Softball Field)
100 E College Ave,
Porterville, CA 93257

OWNER:

Kern Community College District
2100 Chester Ave
Bakersfield, CA 93301

ARCHITECT:

DARDEN ARCHITECTS, INC.
Attention: Robert Petithomme
6790 N. West Avenue
Fresno, California 93711
T. (559) 448-8051

DARDEN PROJECT NO. 2118
DSA File Nos. 03-122694
DSA APPL. NO. 15-C1



It will be the responsibility of the General Contractor to submit the information contained in this addendum to all its subcontractors and suppliers. Acknowledge receipt of this Addendum in the space provided on the Bid Form. Failure to do so may subject Bidder to disqualification.

The following additions, deletions, and revisions to the SHEETS and Project Manual are hereby made and do become a part of these Contract Documents.

PROJECT:

ADDENDUM NO. 201-11-2024
PAGE 2

INDEX OF ADDENDA TRANSMITTED HEREWITH

PROJECT MANUAL:

SPECIFICATIONS:

CHANGES TO SPECIFICATIONS AD2-SP01

SHEETS:

CHANGES TO SHEETS:

CIVIL AD2-C01 THRU AD2-C17
LANDSCAPE / IRRIGATION AD2-L01 THRU AD2-L06

ATTACHMENTS:

DOCUMENTS OR SPECIFICATIONS:

13 28 16 - SAFETY NETTING SYSTEM Pages 1 thru 5

SHEETS:

CIVILAD2_-CX01 thru AD2_-CX17
LANDSCAPE / IRRIGATIONAD2_-LX-01 thru AD2_-LX-06

PROJECT:

ADDENDUM NO. 201-11-2024
PAGE 3

PROJECT MANUAL:

SPECIFICATIONS:

CHANGES TO SPECIFICATIONS:

- AD2-SP01 Refer to Attached Specification Section 13 28 16 - SAFETY NETTING SYSTEM:**
1. Add Specification Section 13 28 16 - SAFETY NETTING SYSTEM to the Project Manual

SHEETS:

CHANGES TO SHEETS:

CIVIL:

- AD2-C01 Refer to Sheet SD/C301 and attached Sheet AD2-CX01**
1. Replace Sheet SD/C301 with the attached Sheet AD2-CX01
 2. Refer to clouded changes on Sheet AD2-CX01
- AD2-C02 Refer to Sheet SD/C302 and attached Sheet AD2-CX02**
1. Replace Sheet SD/C302 with the attached Sheet AD2-CX02
 2. Refer to clouded changes on Sheet AD2-CX02
- AD2-C03 Refer to Sheet SD/C400 and attached Sheet AD2-CX03**
1. Replace Sheet SD/C400 with the attached Sheet AD2-CX03
 2. Refer to clouded changes on Sheet AD2-CX03
- AD2-C04 Refer to Sheet SD/C401 and attached Sheet AD2-CX04**
1. Replace Sheet SD/C401 with the attached Sheet AD2-CX04
 2. Refer to clouded changes on Sheet AD2-CX04
- AD2-C05 Refer to Sheet SD/C402 and attached Sheet AD2-CX05**
1. Replace Sheet SD/C402 with the attached Sheet AD2-CX05
 2. Refer to clouded changes on Sheet AD2-CX05
- AD2-C06 Refer to Sheet SD/C501 and attached Sheet AD2-CX06**
1. Replace Sheet SD/C501 with the attached Sheet AD2-CX06
 2. Refer to clouded changes on Sheet AD2-CX06
- AD2-C07 Refer to Sheet SD/C502 and attached Sheet AD2-CX07**
1. Replace Sheet SD/C502 with the attached Sheet AD2-CX07
 2. Refer to clouded changes on Sheet AD2-CX07

PROJECT:

ADDENDUM NO. 2.....**01-11-2024**
PAGE 4

- AD2-C08 Refer to Sheet SD/C601 and attached Sheet AD2-CX08**
 - 1. Replace Sheet SD/C601 with the attached Sheet AD2-CX08
 - 2. Refer to clouded changes on Sheet AD2-CX08

- AD2-C09 Refer to Sheet SD/C602 and attached Sheet AD2-CX09**
 - 1. Replace Sheet SD/C602 with the attached Sheet AD2-CX09
 - 2. Refer to clouded changes on Sheet AD2-CX09

- AD2-C10 Refer to Sheet SD/X201 and attached Sheet AD2-CX10**
 - 1. Replace Sheet SD/X201 with the attached Sheet AD2-CX10
 - 2. Refer to clouded changes on Sheet AD2-CX10

- AD2-C11 Refer to Sheet SD/X202 and attached Sheet AD2-CX11**
 - 1. Replace Sheet SD/X202 with the attached Sheet AD2-CX11
 - 2. Refer to clouded changes on Sheet AD2-CX11

- AD2-C12 Refer to Sheet SD/X401 and attached Sheet AD2-CX12**
 - 1. Replace Sheet SD/X401 with the attached Sheet AD2-CX12
 - 2. Refer to clouded changes on Sheet AD2-CX12

- AD2-C13 Refer to Sheet SD/X402 and attached Sheet AD2-CX13**
 - 1. Replace Sheet SD/X402 with the attached Sheet AD2-CX13
 - 2. Refer to clouded changes on Sheet AD2-CX13

- AD2-C14 Refer to Sheet SD/X403 and attached Sheet AD2-CX14**
 - 1. Replace Sheet SD/X403 with the attached Sheet AD2-CX14
 - 2. Refer to clouded changes on Sheet AD2-CX14

- AD2-C15 Refer to Sheet SD/X404 and attached Sheet AD2-CX15**
 - 1. Replace Sheet SD/X404 with the attached Sheet AD2-CX15
 - 2. Refer to clouded changes on Sheet AD2-CX15

- AD2-C16 Refer to Sheet SD/X501 and attached Sheet AD2-CX16**
 - 1. Replace Sheet SD/X501 with the attached Sheet AD2-CX16
 - 2. Refer to clouded changes on Sheet AD2-CX16

- AD2-C17 Refer to Sheet SD/X601 and attached Sheet AD2-CX17**
 - 1. Replace Sheet SD/X601 with the attached Sheet AD2-CX17
 - 2. Refer to clouded changes on Sheet AD2-CX17

PROJECT:

ADDENDUM NO. 2.....**01-11-2024**
PAGE 5

LANDSCAPE / IRRIGATION:

AD2-L01 Refer to Sheet SD/L100 and Attached Sheet AD2-LX-01 dated January 10, 2024

1. Replace Sheet SD/L100 with the attached Sheet AD2-LX-01
2. Revise the irrigation legend and the irrigation notes, clarify gate valves, plan notes.
3. Revise the irrigation plan notes at point of connection to existing domestic and reclaimed water lines.

AD2-L02 Refer to Sheet SD/L300 and Attached Sheet AD2-LX-02 dated January 10, 2024

1. Replace Sheet SD/L300 with the attached Sheet AD2-LX-02
2. Revised text to clarify pipe sizes and revised text at infield quick coupling valve. Refer to attached drawing AD2-LX-02, dated January 10, 2024..

AD2-L03 Refer to Sheet SD/L301 and Attached Sheet AD2-LX-03 dated January 10, 2024

1. Replace Sheet SD/L301 with the attached Sheet AD2-LX-03
2. Revised text to clarify pipe sizes and added irrigation gate valves, mainline and quick coupling valve.

AD2-L04 Refer to Sheet SD/L302 and Attached Sheet AD2-LX-04 dated January 10, 2024

1. Replace Sheet SD/L302 with the attached Sheet AD2-LX-04
2. Revised text at point of connection and clarified route of master valve, flow sensor and spare pump start wires.

AD2-L05 Refer to Sheet SD/L500 and Attached Sheet AD2-LX-05 dated January 10, 2024

1. Replace Sheet SD/L500 with the attached Sheet AD2-LX-05
2. Refer to Irrigation Details, Detail A/SD/L500. Revised text for clarity. Added requirement for box extensions.
3. Refer to Irrigation Details, Detail B, N & R/SD/L500. Revised text for clarity.
4. Refer to Irrigation Details, Detail U/SD/L500. Revised pump station specifications and added conduit and wires for future pump start.

PROJECT:

ADDENDUM NO. 2.....01-11-2024
PAGE 6

AD2-L06 Refer to Sheet SD/L501 and Attached Sheet AD2-LX-06 , dated January 10, 2024

1. Replace Sheet SD/L501 with the attached Sheet AD2-LX-06
2. Refer to Planting Details, Detail 'D/SD/L501. Revised text for clarity. Added painting requirement for reclaimed water pipe above grade.
3. Refer to Planting Details, F/SD/L501. Revised compacted subgrade to 95% relative density for compaction under mowstrip.
4. Refer to Planting Details, G/SD/L501. Added City of Porterville Water Connection, Detail G/SDL501.

END OF ADDENDUM NO. 2

SECTION 13 28 16 - SAFETY NETTING SYSTEM

PART 1 - GENERAL

1.1 SECTION INCLUDES

- A. Furnish and install backstop netting, steel support poles, cables and wires, correctors, attachments and miscellaneous items at softball and baseball backstops as shown and specified for a complete system.
- B. Prepare structural drawings and calculations for the safety netting systems compliant with California Building Codes. Drawings and calculations shall be stamped and signed by a currently registered structural engineer experienced with netting systems. The design plans and calculations shall be submitted to the project engineer of record as a project submittal. Because these backstops are less than thirty-five (35) feet tall and consist of cantilevered poles, they are excluded from review by a DSA structural reviewer.

1.2 RELATED SECTIONS

- A. Section 03 30 00 – Concrete
- B. Section 05 12 00 – Steel and Fabrications

1.3 QUALITY ASSURANCE

- A. The Netting System Contractor shall have a minimum of five years, current from this date, proven experience constructing sport netting systems of the size, scope, and nature of the work in this specification. Contractor shall be a CA state licensed contractor, minimum C-13 classification, with bonding capacity by an A+ rated surety or better for the value of the contract.
- B. This is a highly specialized trade. Non-prequalified Subcontractor's will be considered for this project, but non-prequalified subcontractor qualifications for this scope of work shall be submitted no later than fourteen (14) days prior to Bid opening as a substitution request.
- C. Prequalified netting contractor for this project is:

Judge Netting, Garden Grove, CA
Contact: Brian O'Leary
Email: brian@judgenetting.com
Phone: 800-955-6788

1.4 SUBMITTALS

- A. Submit in compliance with Section 01 33 00.
- B. Structural plans and calculations for the backstop and tall barrier netting systems, signed and stamped by a CA licensed structural engineer.
- C. Product information for Safety Netting System(s) including steel support poles, hardware, wire, netting, attachments and materials for a complete installation per the plans and specifications.

- D. Insurance and bonding certificates.
- E. Warranty documents on Contractor's letterhead.

1.5 WARRANTIES

- A. Netting: Full replacement warranty for three years. Pro-rated warranty from three to five years. Warranty covers defects, damage or degradation of materials or workmanship under normal use.
- B. Wire, hardware and steel poles: per component manufacturer.
- C. Steel pole finish: per paint coating manufacturer.

PART 2 - PRODUCTS

2.1 MATERIALS

A. NETTING & ROPE

1. Softball and Baseball Backstop Netting:
#36 x 1-3/4" (3-1/2" Stretch Mesh) Baseball Barrier Netting 100% DuPont Type 66-728 Knotted Nylon; 381 lb per strand break strength; Dyed Black, Stabilized, and bonded for UV and weather resistance; Netting hung on square and manufactured in one "sheet" allowing no escapement with rope borders hand sewn to netting around entire perimeter, vertical riblines @ all poles, and one center horizontal wind line centered between top and bottom wire. Netting panels attached with 5/16" Electro-Galvanized Snap Hooks; Custom manufactured to as built dimensions and tailored for tight fit on framing wires.
2. Rope / Twine:
ROPE:
Black 5/16" Twisted Nylon Rope for netting borders / perimeters, horizontal wind lines, & vertical rib lines at each pole; 3,600 lb break strength; All rope locations on the net panels shall correspond to the as built net panel suspension and support cables constructed to pole structures.
TWINE:
#42 Twisted Nylon Twine 100% DuPont Type 66-728 Nylon; Dyed Black, stabilized, and bonded for UV and weather resistance; minimum 470 lb break strength; The attachment twine shall continually encompass the netting component and be tied to the rope component via a clove and one half hitch knot +/- 6 inches on center, never to exceed 8 inches on center.

B. ATTACHMENTS & WIRES

1. Netting Attachment – Backstop Netting System:
Finished net panels shall be suspended to all support cables by the rope component via a 5/16” Electro-Galvanized Steel Carabineer with minimum 1,140 lb break strength . The interior of the snap shall encompass the netting / rope and cable components when suspension is completed; The interval between snap to cable attachment points shall not exceed 30” O.C. along all perimeter, horizontal, and vertical rib line ropes.
2. Framing / Support wires– Backstop Netting System:
5/16” EHS (Extra High Strength) Guy Strand 1x7 wire with minimum 11,200 lb break strength on Home Run System for horizontal wires and down guys only;

C. POLE LINE HARDWARE

1. All pole line hardware to be galvanized, meet ANSI Standards and / or be RUS Listed; Manufactured by Chance / Hubble or approved equal; Sized Typ. 5/8” Bolts and Fittings; All fittings at top only Backstop Screens.
2. End / Termination and Corner Poles:
5/8” DAFTB (Double Arming Full Thread Bolt), top and bottom only on Backstop netting with 5/8” thimble eye nut; Top & Bottom with Angle Thimble Eye behind standard thimble eye fitting for attachment of vertical wires; Angle Thimble Eyes on outside of pole tops.
3. Mid Span Poles:
5/8” DAFTB (Double Arming Full Thread Bolt) top and bottom only on Backstop netting with 3-Bolt Suspension clamps and bottom; 5/8” 1-Bolt Clamp at for securing vertical wire; 5/8” square curved and spring locking washers typical each side of fitting / bolt.
4. All cable attachment points using thimble eye type hardware to minimize pinching and / or kinking of cable; All bolts are through bolt and rated; Pre-Formed Grips used to form all eyes.

D. STEEL POLE SPECIFICATIONS:

1. General:

Structurally engineered steel poles and foundations to exceed wind load, exposure class, and soil conditions for project site location; All structural welding and steel fabrication to be performed by an approved certified fabricator; All poles finished with black STRYK© 5388 FACS Flexible Anti-Corrosion System applied in three coats as provided by Coastal Netting Systems (or approved equal); Specifications on coating attached below.

E. STEEL POLE FINISH

1. STRYK 5388 FACS, manufactured by Environmental Chemical Composites, is a single component; corrosion retardant coating that imparts flexibility, impact resistance and excellent weatherability. It also demonstrates a high degree of impermeability to moisture and will adhere to difficult substrates. STRYK 5388 FACS will not support fungal growth, making it suitable for high humidity and water-immersed environments. Unlike epoxy coatings, STRYK 5388 FACS will not crack due to extreme cyclic expansion and contraction, cryogenic temperatures or deteriorate due to ozone and ultraviolet attack.

2. When applied on metallic substrates, it forms an impermeable coating that prevents moisture and oxygen from producing corrosion or oxidation. As a secondary mechanism, STRYK 5388 FACS utilizes a novel anticorrosion filler that interfaces with the substrate in the molecular level thus inhibiting metals from corroding even when the coating has been breached or damaged. It has been successfully used in numerous surface treatment applications such as metal pipes, structural steel, exterior tank coatings and cryogenic applications. A single coat (roller applied) will yield approximately 5 mils dry film thickness.

a. Physical Properties:

Form	Milky Liquid (Or Custom Color)
Viscosity	23,000 +/- 1,000 cPs (spindle 6, 20 rpm)
Solids Content	60%
Solvent	Chlorinated Aliphatic - complies with San Francisco/Bay Area Rule 3 and Los Angeles Rule 102 Clean Air Act.
Density	11 pounds per gallon
Flash Point	Greater than 200oC (ASTM D-1310)
DOT Shipping	Non-RED LABEL

b. Mechanical Properties:

Tensile Strength	900 PSI
100% modulus	320 PSI
Hardness	50 Shore A
Elongation at break	300%
Electrical Properties	
Volume Resistance	1015 Ohms-cm
Dielectric strength	780 Volts/mil

c. Outdoor Weatherability:

QUV	>4000 hours
-----	-------------

100% Ozone Chamber	>1000 hours
Cold Flex 90o at -100oC	No Cracking

- d. Packaging and Storage:
STRYK 5388 FACS is available in 5 gallon, and 55-gallon kits. Use size kits and special packaging requests are also available. STRYK 5388 FACS should be stored in a cool dry place. Do not store above 30oC for prolonged period. STRYK 5388 FACS has a shelf life of one year from the date of shipment.

PART 3 - EXECUTION

3.1 EXAMINATION & PREPARATION

- A. General: Verify that existing site conditions are as specified and indicated before beginning this work. Coordinate the layout and installation of anchor attachments and other embedded items with other related trades.
- B. Examine the area and conditions under which the work in this section is to be performed. Do not proceed until unsatisfactory conditions have been corrected. Commencement of the work signifies acceptance of the existing conditions.
- D. Protection:
1. Locate sewer, water, irrigation, gas, electric, phone and other pipelines or conduits and equipment within the area of work prior to commencing work.
 2. Protect in place any improvements adjacent to the work area.

3.2 INSTALLATION

- A. Backstop Netting Systems:
Install all hardware, wire, steel support poles, and netting; steel poles as shown on the project drawings. Bottom of netting panel secured to bottom wire coordinated with top of HDPE backstop boards and structural support to prevent passage of sports equipment and balls between the bottom of the netting system and the top of the HDPE backstop boards.


3.3 PROTECTION

- A. Protect the Work of this section until Substantial Completion. Repair and/or replace at the Contractor's expense any damage to existing or newly constructed improvements to the satisfaction of the Owner.

3.4 CLEANUP

- A. Remove rubbish, debris, and waste materials and legally dispose of off the Project site.

END OF SECTION

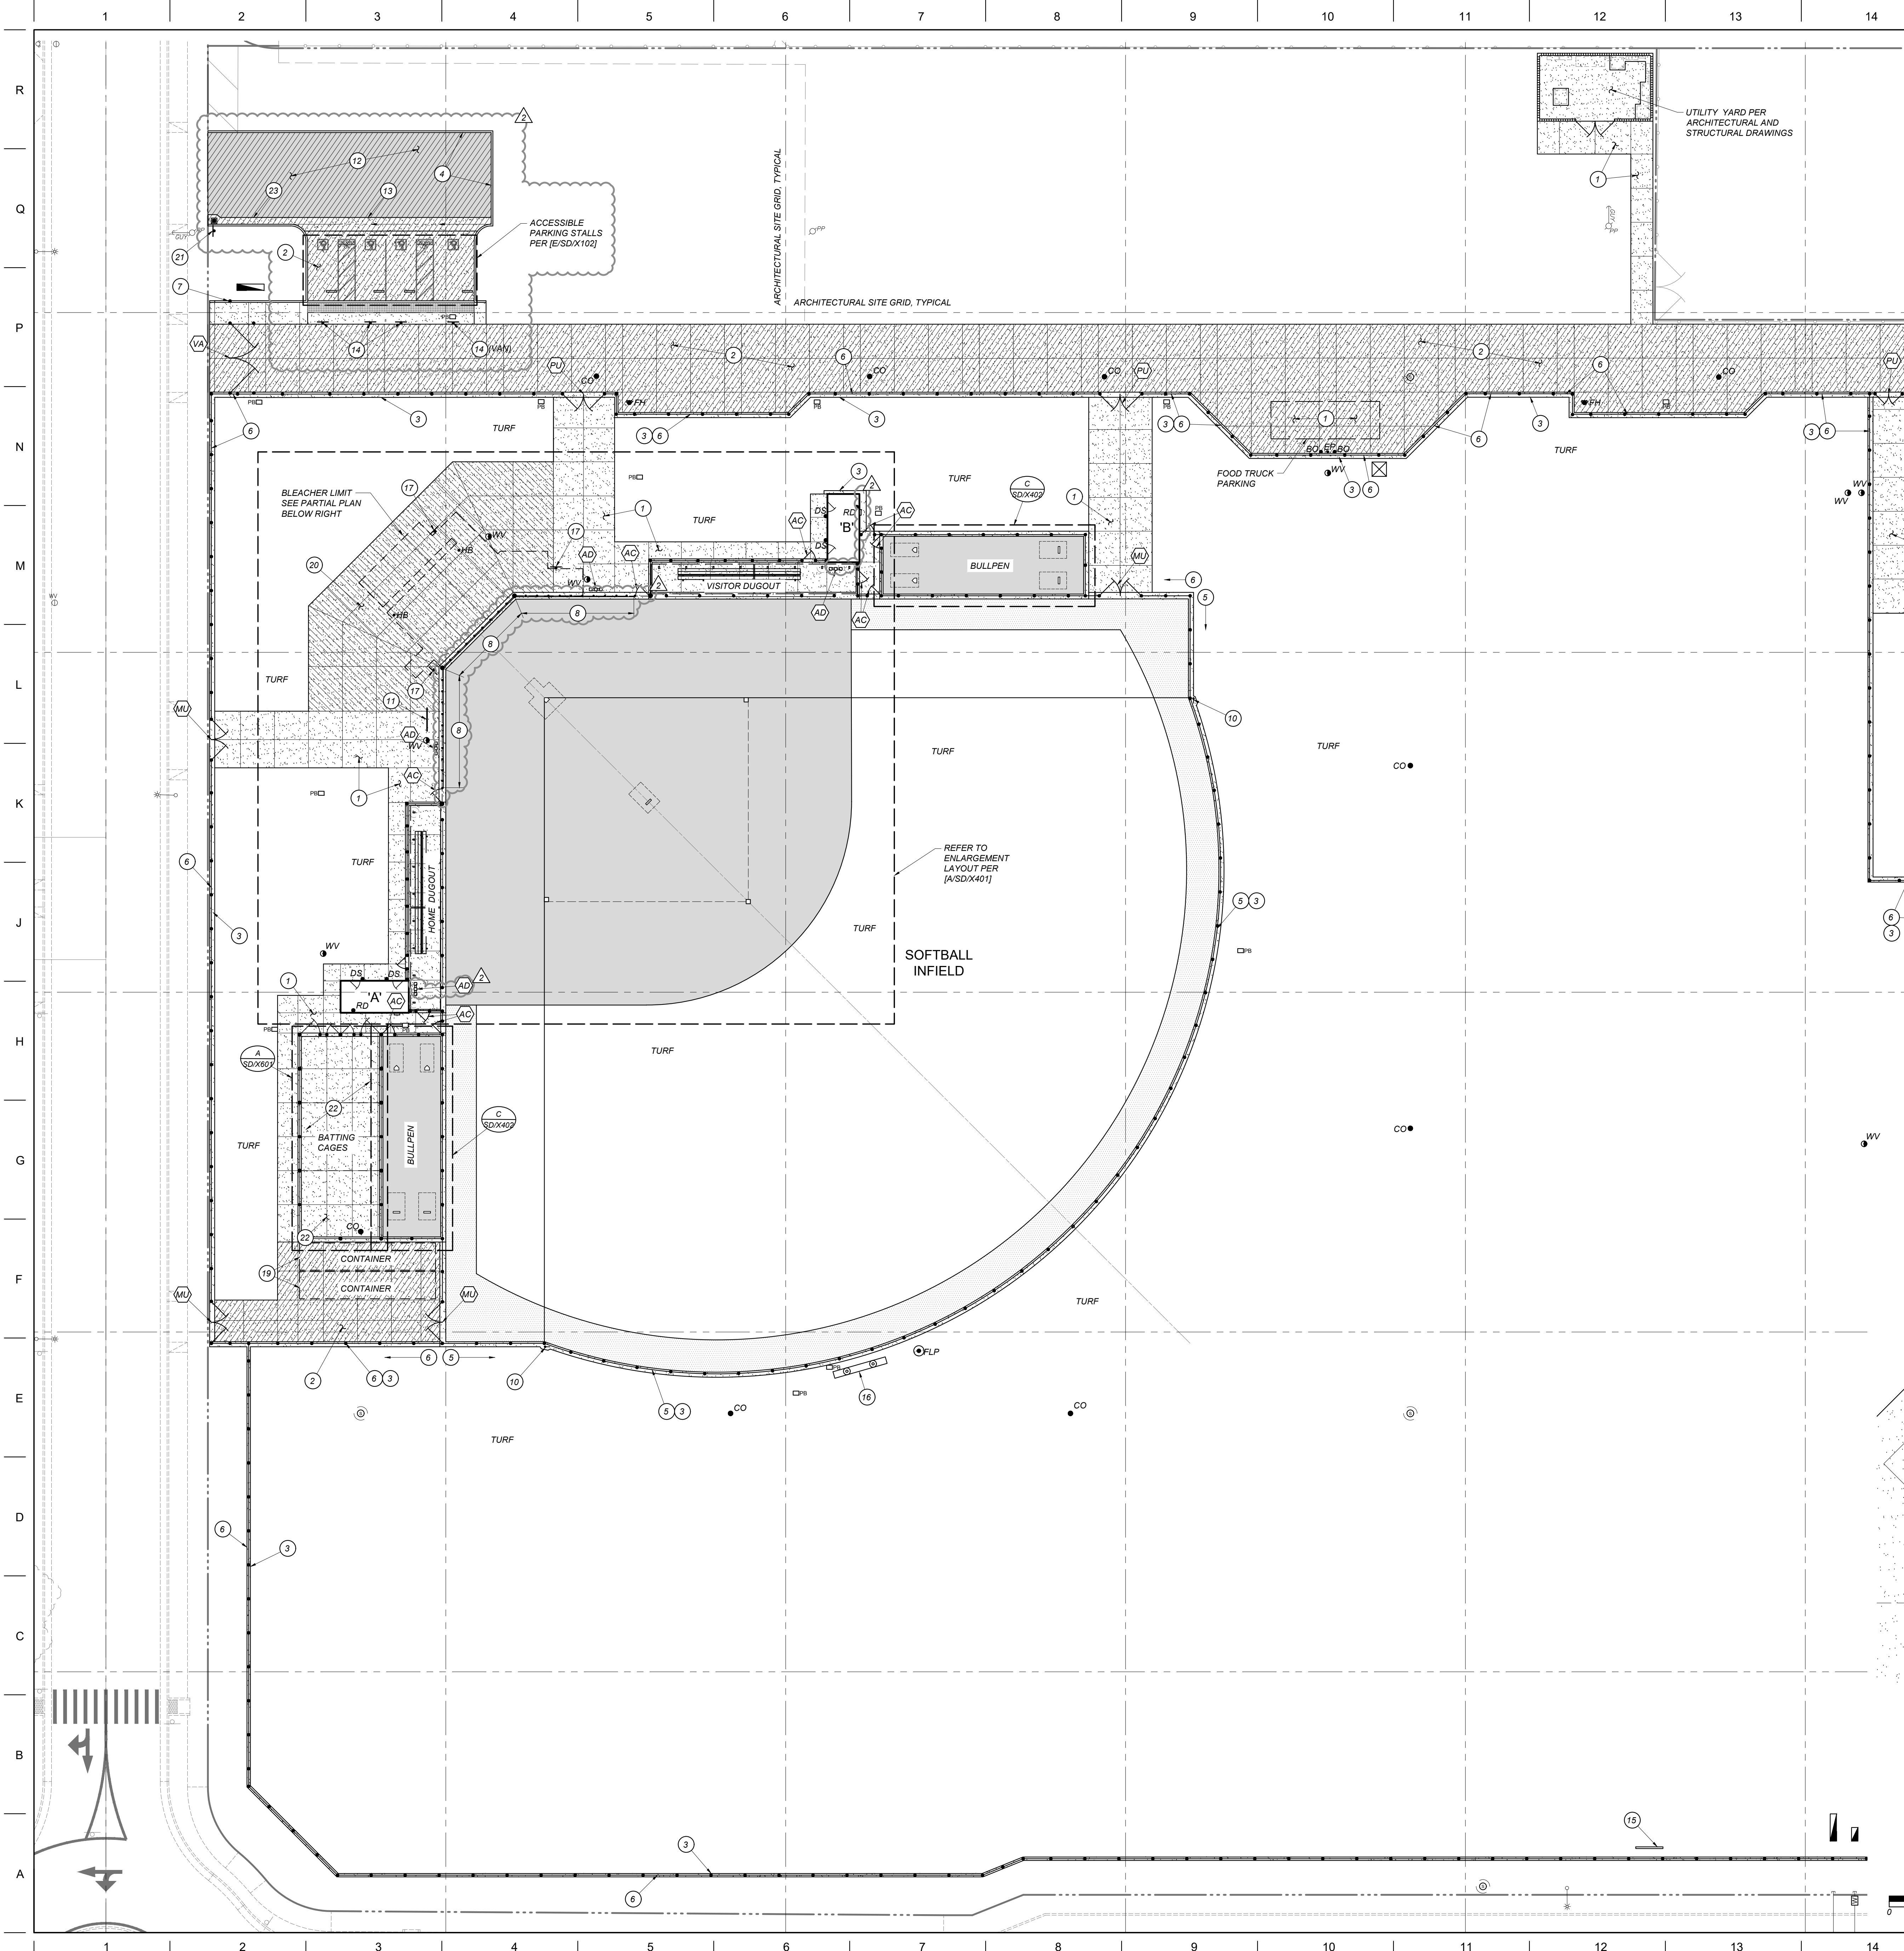

SITE LEGEND:

- DETAIL DESIGNATION
- DETAIL REFERENCE SHEET LOCATION
- [DETAIL DESIGNATION / SHEET LOCATION]
- LIMITS OF ASPHALTIC CONCRETE IMPROVEMENTS
- LIMITS OF CONCRETE IMPROVEMENTS
- LIMITS OF HEAVY DUTY CONCRETE IMPROVEMENTS
- LIMITS OF BLEACHER PAD
- LIMITS OF WARNING TRACK SURFACING PER [P/SD/X101]
- LIMITS OF SKINNED INFIELD SURFACING PER [H/SD/X101]
- DETECTABLE WARNINGS PER [A/SD/X102]
- CHAIN LINK FENCE
- NEW CHAIN LINK GATES. SEE HORIZONTAL CONTROL PLAN FOR WIDTH. HEIGHT TO MATCH ADJACENT FENCE
- CHAIN LINK ROLL GATE PER [A/SD/X302]
- SEWER CLEANOUT PER THE UTILITY PLAN
- DRYWELL PER THE UTILITY PLAN
- FIRE DEPARTMENT CONNECTION PER THE UTILITY PLAN
- FIRE HYDRANT ASSEMBLY PER THE UTILITY PLAN
- HOSE BIBB PER THE UTILITY PLAN
- WATER VALVE PER THE UTILITY PLAN
- PROTECTION BOLLARD PER DETAIL [G/SD/X101]
- EATON POWERSLIDE RV PEDESTAL WITH INTEGRAL HOSE BIBB FOR FOOD TRUCK CONNECTION. SEE ARCHITECTURAL AND ELECTRICAL PLANS FOR COORDINATION.
- FLAGPOLE AND FOOTING PER DETAIL [C/SD/X601]
- PLANTING AREA. SEE PLANTING PLANS
- TURF AREA. SEE PLANTING PLANS
- ACCESSIBLE DRINKING FOUNTAIN AND BOTTLE FILLING STATION PER [A/SD/X202]
- CONCRETE WALK PER [B/SD/X101]
- 1
- 2
- 3
SEE SHEET SD/ C302 FOR CONTINUATION

DSA File No.: 15-C1

DSA Application No.: 03-122694

Agency Approval

GENERAL SITE NOTES:


1. ALL CONCRETE MOWSTRIPS, RAMPS AND SIDEWALKS SHALL HAVE WEAKENED PLANE JOINTS AT 10 FEET MAXIMUM ON CENTER AND EXPANSION JOINTS AT 30 FEET MAXIMUM ON CENTER PER [B/SD/X101]
2. NO CONCRETE MAY BE POURED UNTIL THE FORMS HAVE BEEN REVIEWED AND APPROVED BY THE PROJECT INSPECTOR
3. ALL BURIED METALLIC OBJECTS SHALL HAVE A PROTECTIVE COATING OR BE WRAPPED WITH APPROVED PROTECTIVE WRAP.
4. 2 WORKING DAYS BEFORE COMMENCING EXCAVATION OPERATIONS WITHIN THE STREET RIGHT-OF-WAY AND/OR UTILITY EASEMENTS. ALL EXISTING UNDERGROUND FACILITIES SHALL HAVE BEEN LOCATED BY UNDERGROUND SERVICES ALERT (USA). CALL 1-800-642-2444
5. ANY SURVEY MONUMENTS WITHIN THE AREA OF CONSTRUCTION SHALL BE PRESERVED OR RESET BY A PERSON LICENSED TO PRACTICE LAND SURVEYING IN THE STATE OF CALIFORNIA. REPLACEMENT TO BE AT CONTRACTOR'S SOLE EXPENSE.
6. OBTAIN ALL REQUIRED PERMITS AND APPROVALS FROM AGENCY HAVING JURISDICTION FOR WORK WITHIN THE PUBLIC RIGHT OF WAY
7. ADJUST UTILITY LIDS WITHIN NEW CONSTRUCTION AREA TO FINISHED GRADE PER [D/SD/X201]
8. REPLACE ALL BROKEN LIDS WITH NEW. PROVIDE TRAFFIC RATED LIDS WITHIN VEHICLE LOADING AREAS.
9. SEE IRRIGATION PLANS FOR LOCATIONS AND SIZES OF REQUIRED SLEEVES.
10. ALL SOFTBALL AND BASEBALL FENCES 8' HIGH OR LESS, AND DIRECTLY ADJACENT TO THE FIELD OF PLAY SHALL RECEIVE FENCE TOP PROTECTION.
11. GATES SHALL MATCH THE HEIGHT OF THE ADJACENT FENCE EXCEPT WHERE NOTED OR SHOWN OTHERWISE.

GATE HARDWARE LEGEND:


- PEDESTRIAN ACCESSIBLE WALK GATE. NON-KEYED PASSAGE TYPE LATCH. PROVIDE APPROPRIATE HARDWARE PER [A/SD/X301]
- MAINTENANCE USE GATE - LOCKABLE FORK LATCH
- PUBLIC USE GATE - LOCKABLE FORK LATCH. GATE SHALL BE SECURED IN AN OPEN POSITION DURING PUBLIC USE PER [A/SD/X301]
- VEHICLE ACCESS PIPE GATE PER [A/SD/X302]

FENCING BID ALTERNATE:

1. BASE BID FOR DUGOUTS SHALL INCLUDE OPEN MESH CHAIN LINK FENCING ON THE BACK AND SIDES PER DETAIL [A/SD/X301]
2. BASE BID FOR HOME RUN FENCE SHALL INCLUDE OPEN MESH CHAIN LINK FENCING PER DETAIL [A/SD/X301]
3. BID ALTERNATE FOR DUGOUTS SHALL INCLUDE SLATTED CHAIN LINK FENCING ON THE BACK AND SIDES PER DETAIL [C/SD/X301]
4. BID ALTERNATE FOR HOME RUN FENCE SHALL INCLUDE SLATTED MESH CHAIN LINK FENCING PER DETAIL [C/SD/X301]

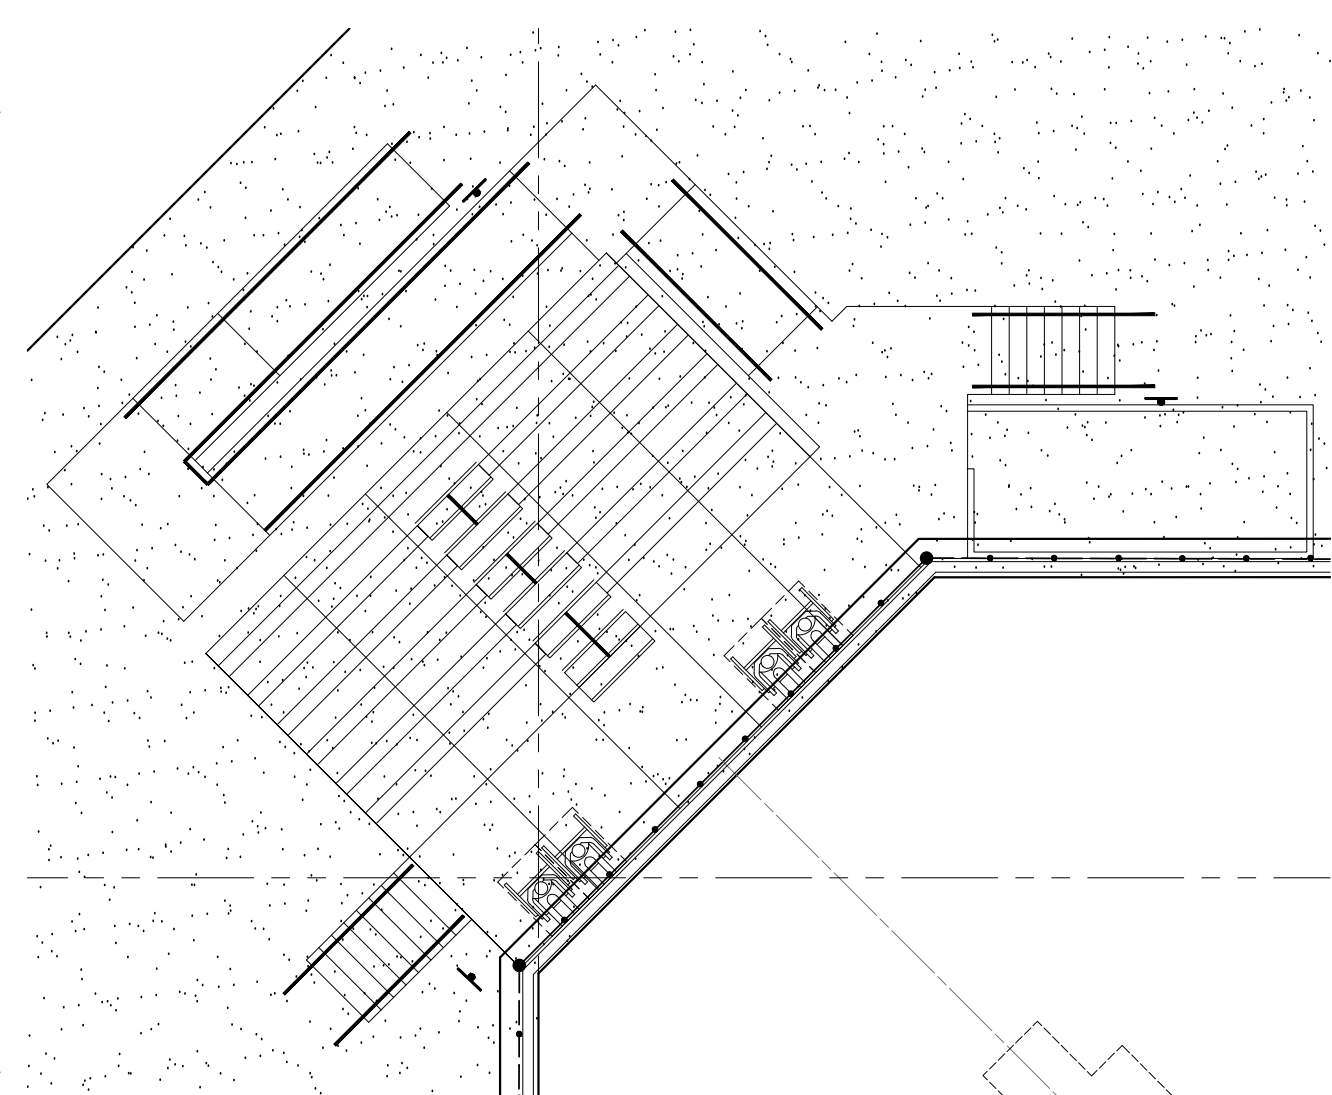

ELEVATED BLEACHER LAYOUT
SCALE 1" = 10'

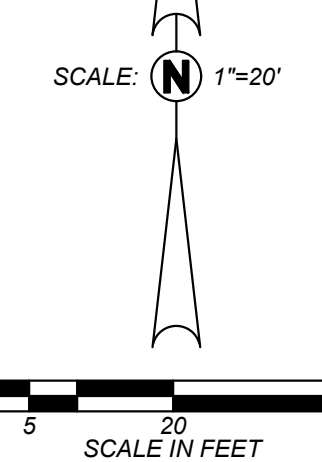

General Notes

Blair, Church & Flynn Consulting Engineers
461 Clovis Avenue, Suite 200
Clovis, California 93612
Tel (559) 326-1400 Fax (559) 326-1500

Consultant

PORTERVILLE COLLEGE ATHLETIC COMPLEX
PHASE I
100 E COLLEGE AVE.
PORTERVILLE, CA 93257

Project

SITE PLAN

Drawing


darden architects
ARCHITECTURE PLANNING INTERIORS
www.dardenarchitects.com
6790 N. West Ave. • Fresno, CA 93711 • T. 559.448.8051

Architect

No.	Revision/Submission	Date
1	ADDENDUM 02	01/11/2024

Revision		
Designed By:	ZH	Copyright 2024 Darden Architects
Scale:	AS NOTED	Drawn By: AH
Project Number:	2118	Checked By: JF
Date:	12/28/2023	Reviewed By: ZH

SD/C301
AD2-CX01

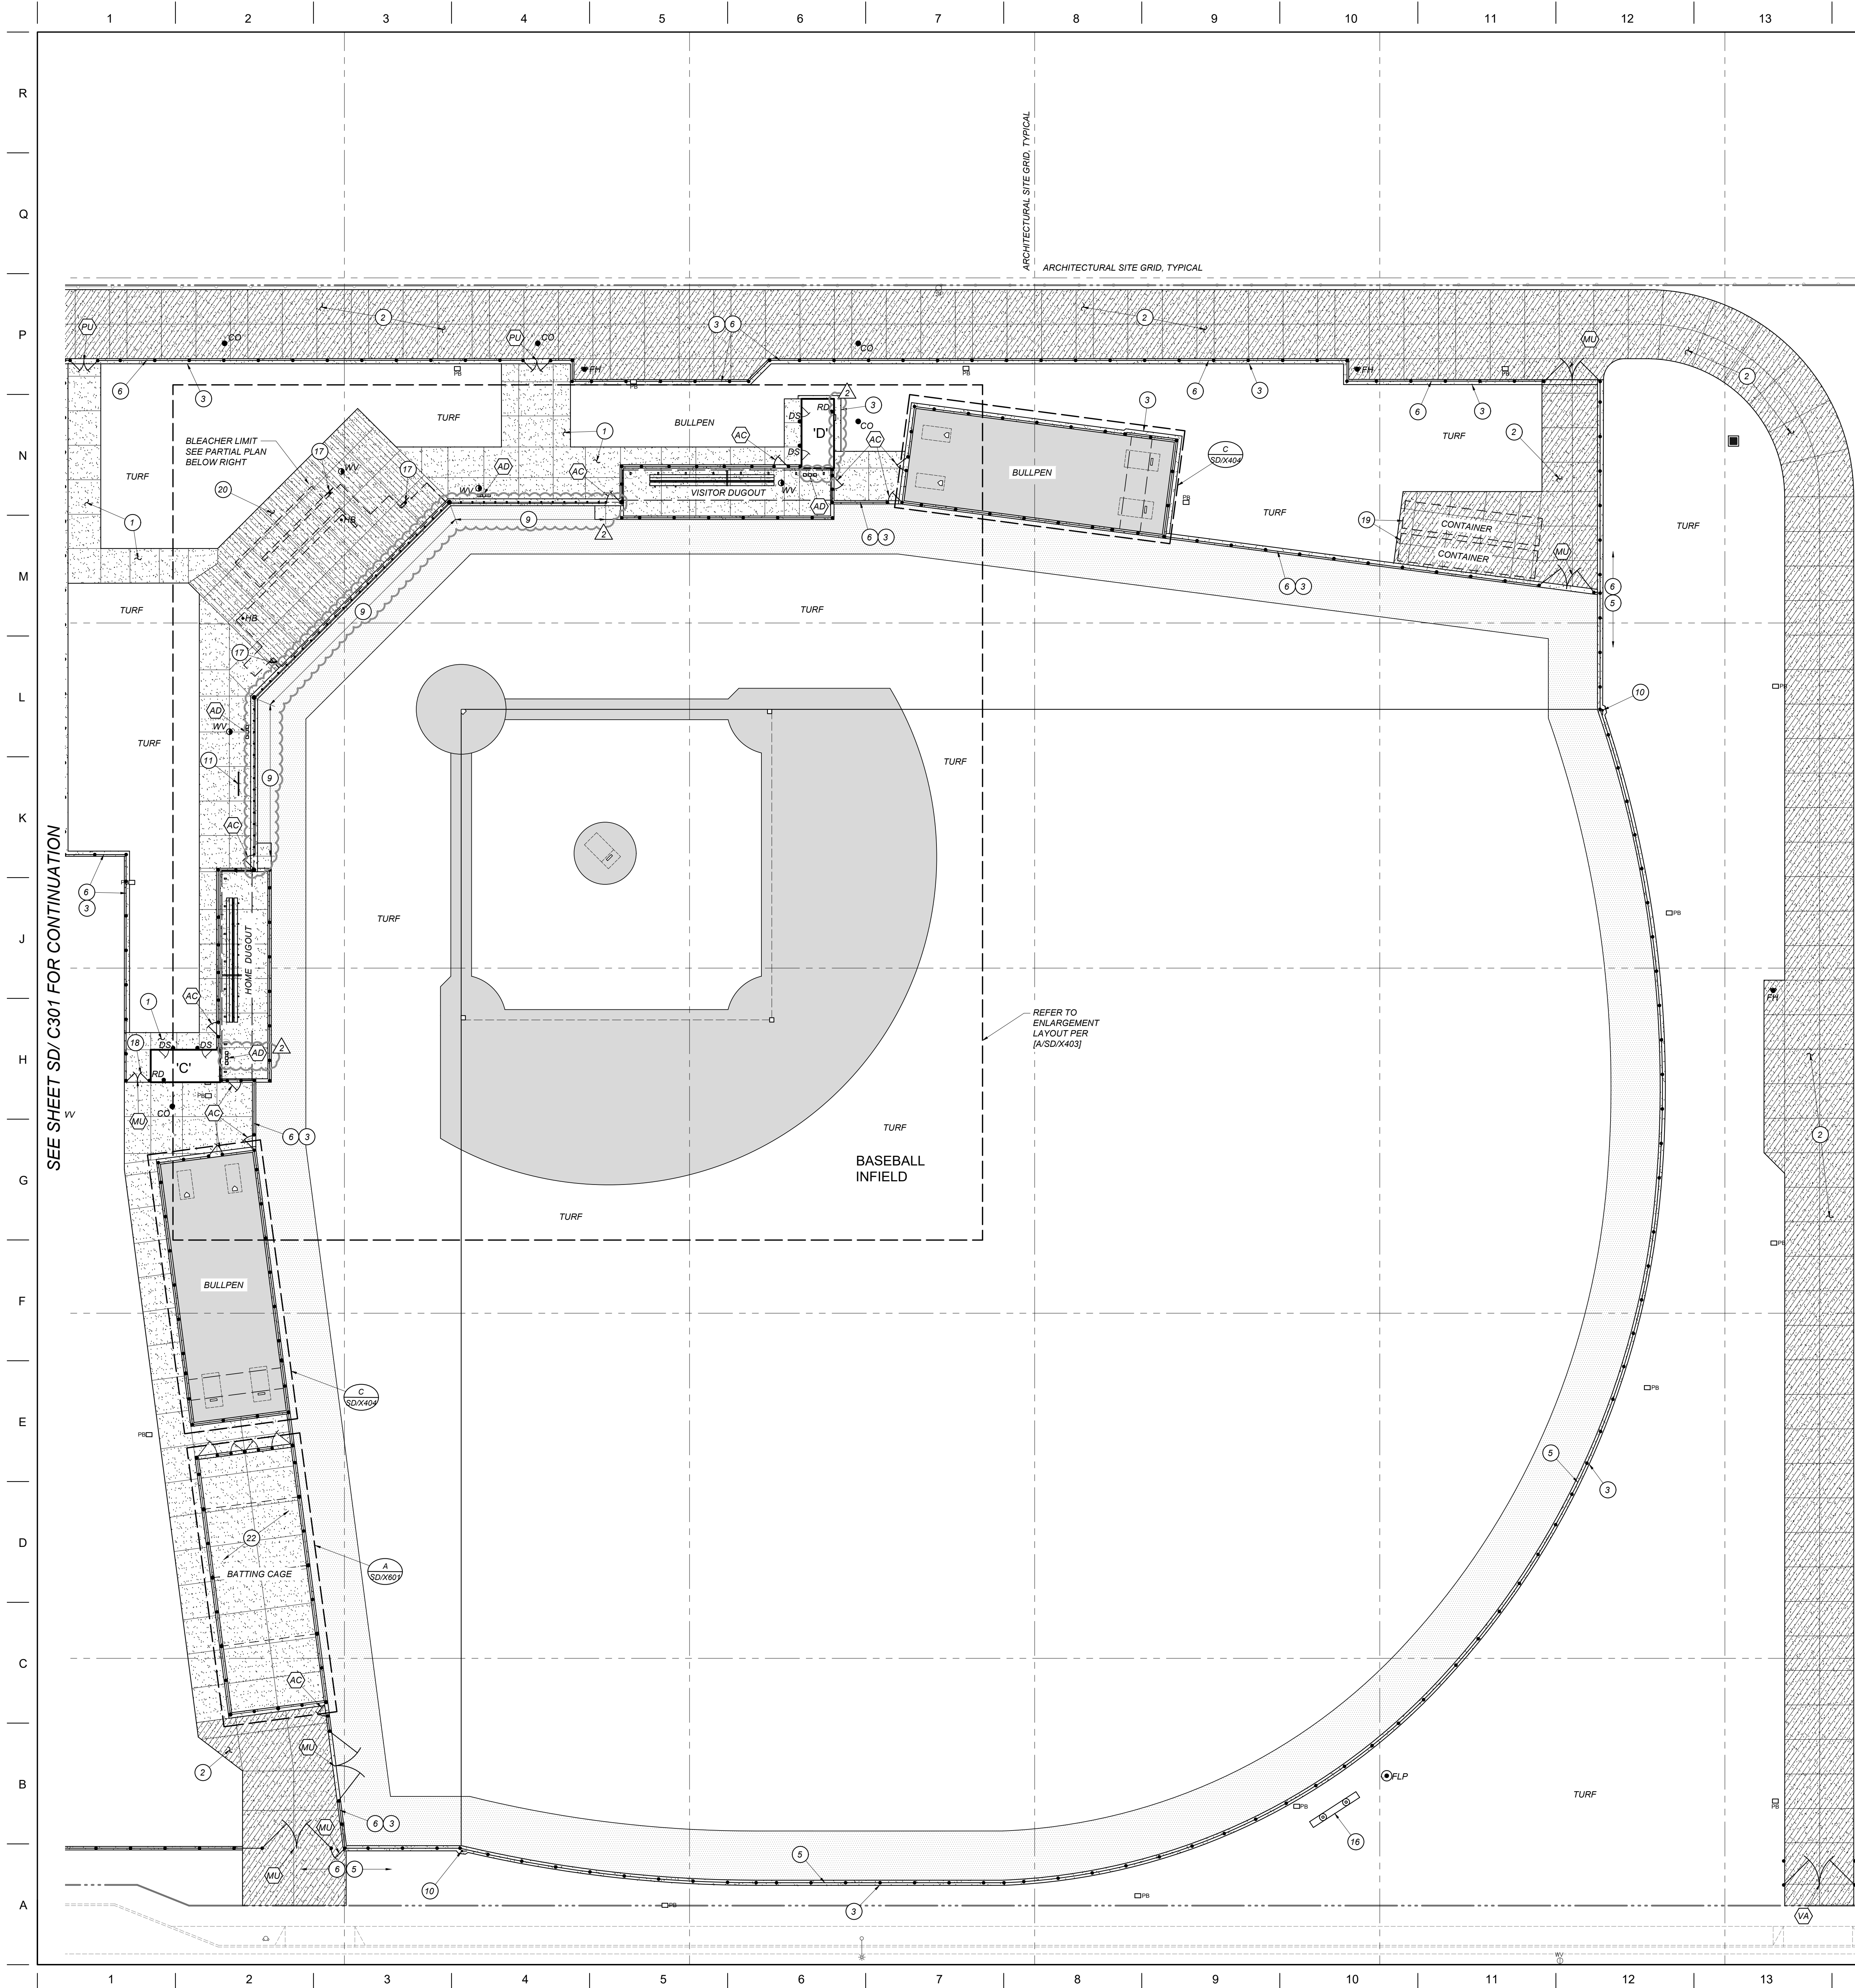

- ### SITE LEGEND:
- DETAIL DESIGNATION
 - DETAIL REFERENCE
 - SHEET LOCATION
 - [DETAIL DESIGNATION / SHEET LOCATION]
 - LIMITS OF ASPHALTIC CONCRETE IMPROVEMENTS
 - LIMITS OF CONCRETE IMPROVEMENTS
 - LIMITS OF HEAVY DUTY CONCRETE IMPROVEMENTS
 - LIMITS OF BLEACHER PAD
 - LIMITS OF WARNING TRACK SURFACING PER [P/SD/X101]
 - LIMITS OF SKINNED INFIELD SURFACING PER [H/SD/X101]
 - DETECTABLE WARNINGS PER [A/SD/X102]
 - CHAIN LINK FENCE
 - NEW CHAIN LINK GATES. SEE HORIZONTAL CONTROL PLAN FOR WIDTH. HEIGHT TO MATCH ADJACENT FENCE
 - CHAIN LINK ROLL GATE PER [A/SD/X302]
 - SEWER CLEANOUT PER THE UTILITY PLAN
 - DRYWELL PER THE UTILITY PLAN
 - FIRE DEPARTMENT CONNECTION PER THE UTILITY PLAN
 - FIRE HYDRANT ASSEMBLY PER THE UTILITY PLAN
 - HOSE BIBB PER THE UTILITY PLAN
 - WATER VALVE PER THE UTILITY PLAN
 - PROTECTION BOLLARD PER DETAIL [G/SD/X101]
 - EATON POWERSLIDE RV PEDESTAL WITH INTEGRAL HOSE BIBB FOR FOOD TRUCK CONNECTION. SEE ARCHITECTURAL AND ELECTRICAL PLANS FOR COORDINATION.
 - FLAGPOLE AND FOOTING PER DETAIL [C/SD/X601]
 - PLANTING AREA. SEE PLANTING PLANS
 - TURF AREA. SEE PLANTING PLANS
 - ACCESSIBLE DRINKING FOUNTAIN AND BOTTLE FILLING STATION PER [A/SD/X202]
 - CONCRETE WALK PER [B/SD/X101]
 - CONCRETE MOWSTRIP PER [D/SD/X101]. SEE HORIZONTAL CONTROL FOR WIDTH.
 - CONCRETE CURB PER [E/SD/X101]
 - 6' HIGH CHAIN LINK HOME RUN FENCE PER [A/SD/X301] WITH FENCE TOP PROTECTION. SEE FENCING BID ALTERNATE NOTES ON THIS SHEET.
 - 6' HIGH CHAIN LINK FENCE PER [A/SD/X301]
 - KNOX BOX ON PEDESTAL PER ARCHITECTURAL DRAWINGS.
 - 30' HIGH SOFTBALL BACKSTOP NETTING BARRIER. SEE [A/SD/X401] AND [B/SD/X401].
 - 30' HIGH BASEBALL BACKSTOP NETTING BARRIER. SEE [A/SD/X403] AND [B/SD/X403].
 - FOUL LINE POLE PER [D/SD/X601]
 - BICYCLE RACK. SEE ARCHITECTURAL PLANS
 - ASPHALT CONCRETE PAVEMENT PER [A/SD/X101]
 - CONCRETE VALLEY GUTTER PER [H/SD/X102]
 - ACCESSIBLE PARKING STALL SIGN PER [C/SD/X102]
 - ROUGH CARPENTRY SIGN. SEE ARCHITECTURAL PLANS
 - SCOREBOARD. SEE ARCHITECTURAL PLANS
 - ASSISTIVE LISTENING SYSTEM SIGN PER [B/SD/X302]
 - CHAIN LINK SWING GATE PER [A/SD/X301]
 - OWNER FURNISHED STORAGE CONTAINERS. INSTALL PER DSA IR A-27 REQUIREMENTS. THE MAXIMUM DIMENSIONS ARE 10'W X 50'L X 10'H.
 - BLEACHER PAD THICKNESS AND FOOTINGS ARE PART OF A DEFERRED SUBMITTAL.
 - TOW-AWAY SIGN PER [G/SD/X102]
 - BATTING CAGE SURFACING - SEE NOTES ON DETAIL [A/SD/X601] FOR BASE BID AND BID ALTERNATE SURFACING.
 - CONCRETE CURB AND GUTTER PER [I/SD/X102]




DSA File No.: 15-C1

Agency Approval

- ### GENERAL SITE NOTES:
- ALL CONCRETE MOWSTRIPS, RAMPS AND SIDEWALKS SHALL HAVE WEAKENED PLANE JOINTS AT 10 FEET MAXIMUM ON CENTER AND EXPANSION JOINTS AT 30 FEET MAXIMUM ON CENTER PER [B/SD/X101]
 - NO CONCRETE MAY BE POURED UNTIL THE FORMS HAVE BEEN REVIEWED AND APPROVED BY THE PROJECT INSPECTOR
 - ALL BURIED METALLIC OBJECTS SHALL HAVE A PROTECTIVE COATING OR BE WRAPPED WITH APPROVED PROTECTIVE WRAP.
 - 2 WORKING DAYS BEFORE COMMENCING EXCAVATION OPERATIONS WITHIN THE STREET RIGHT-OF-WAY AND/OR UTILITY EASEMENTS. ALL EXISTING UNDERGROUND FACILITIES SHALL HAVE BEEN LOCATED BY UNDERGROUND SERVICES ALERT (USA). CALL 1-800-642-2444
 - ANY SURVEY MONUMENTS WITHIN THE AREA OF CONSTRUCTION SHALL BE PRESERVED OR RESET BY A PERSON LICENSED TO PRACTICE LAND SURVEYING IN THE STATE OF CALIFORNIA. REPLACEMENT TO BE AT CONTRACTOR'S SOLE EXPENSE.
 - OBTAIN ALL REQUIRED PERMITS AND APPROVALS FROM AGENCY HAVING JURISDICTION FOR WORK WITHIN THE PUBLIC RIGHT OF WAY
 - ADJUST UTILITY LIDS WITHIN NEW CONSTRUCTION AREA TO FINISHED GRADE PER [D/SD/X201]
 - REPLACE ALL BROKEN LIDS WITH NEW. PROVIDE TRAFFIC RATED LIDS WITHIN VEHICLE LOADING AREAS.
 - SEE IRRIGATION PLANS FOR LOCATIONS AND SIZES OF REQUIRED SLEEVES.
 - ALL SOFTBALL AND BASEBALL FENCES 6' HIGH OR LESS, AND DIRECTLY ADJACENT TO THE FIELD OF PLAY SHALL RECEIVE FENCE TOP PROTECTION.
 - GATES SHALL MATCH THE HEIGHT OF THE ADJACENT FENCE EXCEPT WHERE NOTED OR SHOWN OTHERWISE.

- ### GATE HARDWARE LEGEND:
- PEDESTRIAN ACCESSIBLE WALK GATE, NON-KEYED PASSAGE TYPE LATCH. PROVIDE APPROPRIATE HARDWARE PER [A/SD/X301]
 - MAINTENANCE USE GATE - LOCKABLE FORK LATCH
 - PUBLIC USE GATE - LOCKABLE FORK LATCH. GATE SHALL BE SECURED IN AN OPEN POSITION DURING PUBLIC USE PER [A/SD/X301]
 - VEHICLE ACCESS PIPE GATE PER [A/SD/X302]

- ### FENCING BID ALTERNATE:
- BASE BID FOR DUGOUTS SHALL INCLUDE OPEN MESH CHAIN LINK FENCING ON THE BACK AND SIDES PER DETAIL [A/SD/X301]
 - BASE BID FOR HOME RUN FENCE SHALL INCLUDE OPEN MESH CHAIN LINK FENCING PER DETAIL [A/SD/X301]
 - BID ALTERNATE FOR DUGOUTS SHALL INCLUDE SLATTED CHAIN LINK FENCING ON THE BACK AND SIDES PER DETAIL [C/SD/X301]
 - BID ALTERNATE FOR HOME RUN FENCE SHALL INCLUDE SLATTED MESH CHAIN LINK FENCING PER DETAIL [C/SD/X301]

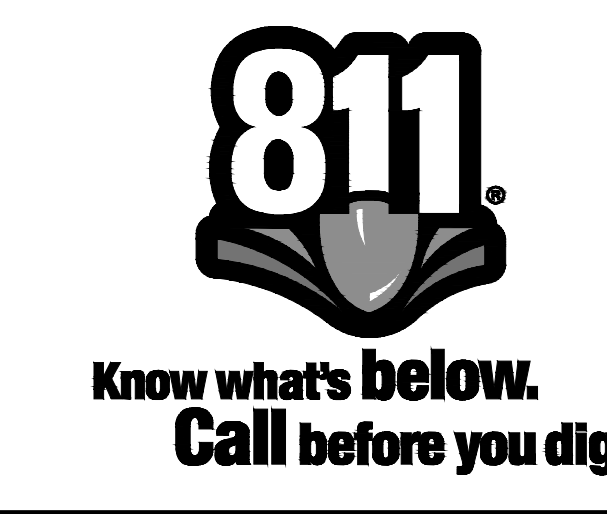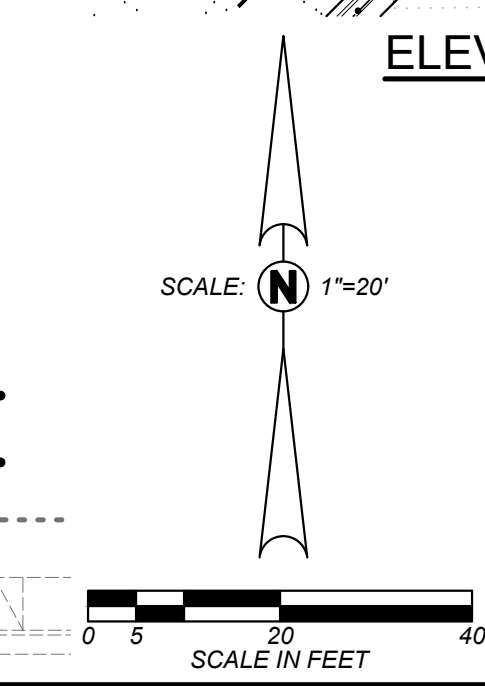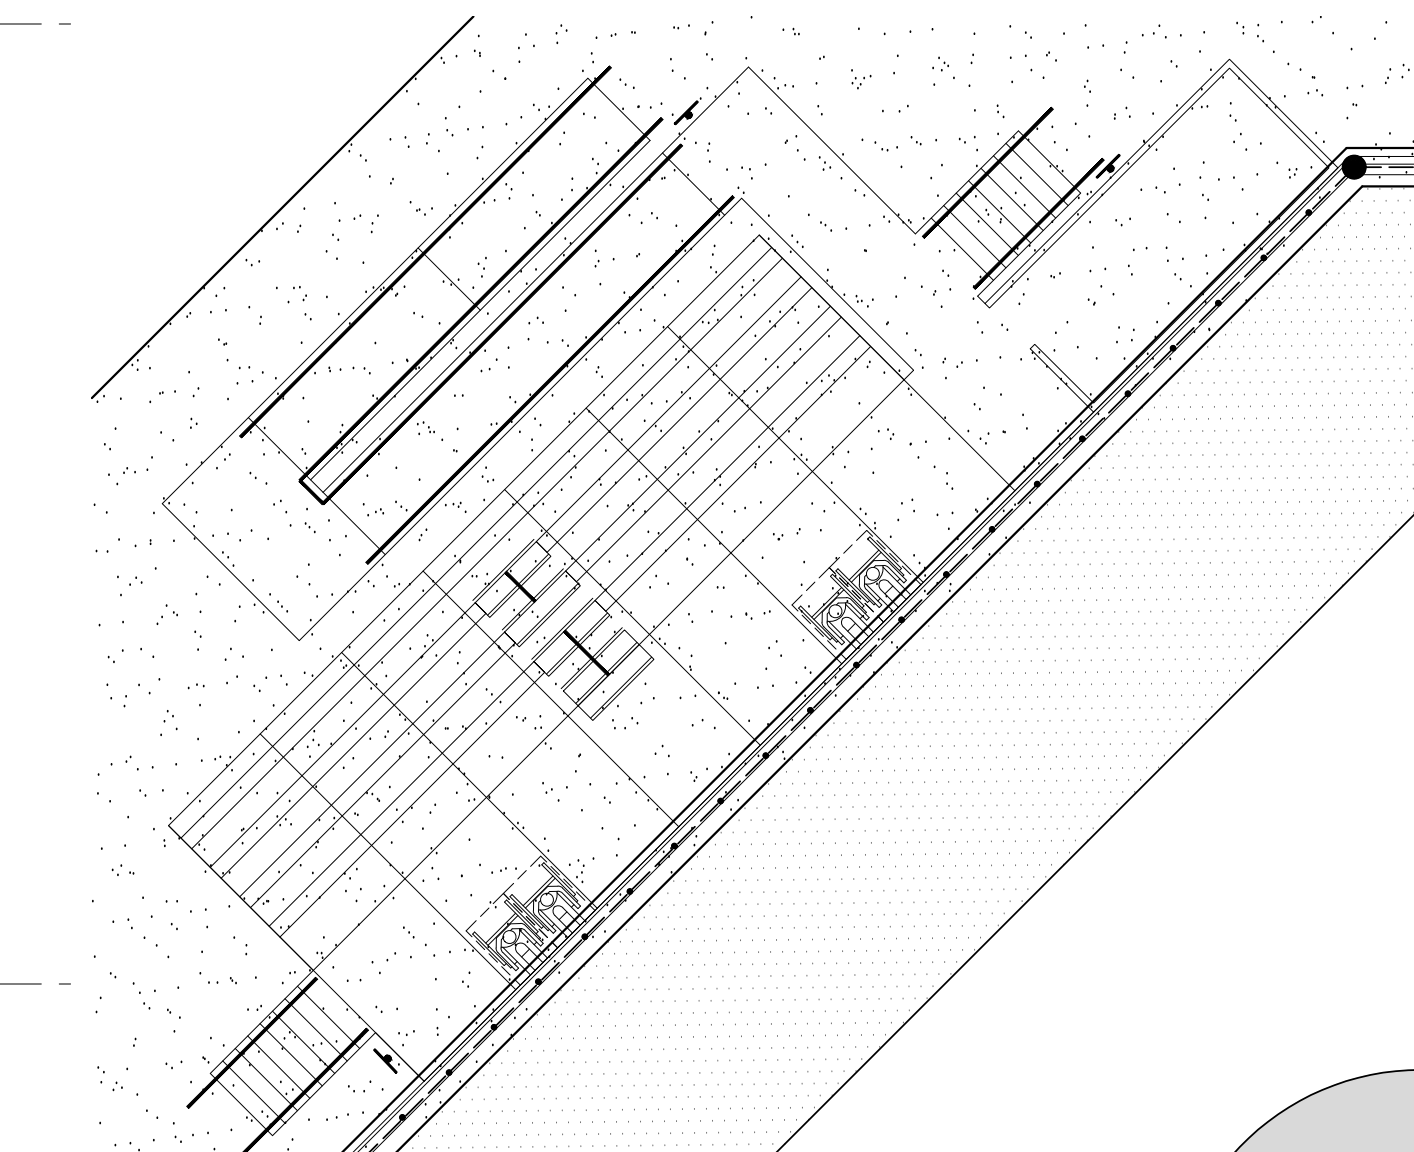

General Notes

Blair, Church & Flynn Consulting Engineers
461 Clovis Avenue, Suite 200
Clovis, California 93612
Tel (559) 326-1400 Fax (559) 326-1500

Consultant

PORTERVILLE COLLEGE ATHLETIC COMPLEX
PHASE I
100 E COLLEGE AVE.
PORTERVILLE, CA 93257

Project

SITE PLAN

Drawing

darden architects
ARCHITECTURE PLANNING INTERIORS
www.dardenarchitects.com
6790 N. West Ave. • Fresno, CA 93711 • T. 559.448.8051

Architect

No.	Revision/Submission	Date
1	ADDENDUM 02	01/11/2024

Revision		
Designed By:	ZH	Copyright 2024 Darden Architects
Scale:	AS NOTED	Drawn By: AH
Project Number:	2118	Checked By: JF
Date:	12/28/2023	Reviewed By: ZH

**SD/C302
AD2-CX02**

DSA File No.: 15-C1

DSA Application No.: 03-122694

Agency Approval


HORIZONTAL CONTROL LEGEND:

- 100 SLP SITE LAYOUT POINT
100 BLP BUILDING LAYOUT POINT
100 LCP LAYOUT COORDINATE POINT
BC BEGIN OF CURVE
CC CORNER CONCRETE
EC END OF CURVE
FP FENCE POST
GR DRAIN INLET GRATE
MN MANHOLE
PL BASEBALL/ SOFTBALL PLATE
PP CENTER OF PITCHER'S PLATE
RP RADIUS POINT
SP SPORT POST

GENERAL HORIZONTAL CONTROL NOTES:

- 1. REFERENCE GRID LINES ARE SPACED 40' ON CENTERLINE TO CENTERLINE AND ARE BASED ON THE ARCHITECT'S DESIGN GRID FOR THE PROJECT
2. DIMENSIONS AND POINTS ARE TO CENTER OF FENCE POSTS, FACE OF BUILDINGS, TOP FACE OF CURB, OR EDGE OF CONCRETE, UNLESS SHOWN OTHERWISE
3. HORIZONTAL CONTROL POINTS PROVIDED ARE BASED ON AN ASSUMED COORDINATE SYSTEM GOVERNED BY THE CONTROL POINTS FOR THE PROJECT
4. SITE LAYOUT POINT 100 IS A BENCHMARK FOR THIS PROJECT IS THE TOP OF CURB ELEVATION AT THE NORTH END OF THE SOUTHWEST RETURN AT HIGHWAY 190 AND PLANO ROAD INTERSECTION
5. SITE LAYOUT POINT 101 IS A BENCHMARK TO BE USED FOR CONSTRUCTION IT IS A PARKER-KALON (PK) NAIL ON THE SOUTH SIDE OF EAST COLLEGE AVENUE APPROXIMATELY 380' SOUTH EAST OF THE INTERSECTION BETWEEN EAST COLLEGE AVENUE AND SOUTH MAIN STREET
6. SITE LAYOUT POINT 102 IS A PARKER-KALON (PK) NAIL AT THE SOUTHWEST PARKING LOT APPROXIMATELY 63' SOUTH WEST OF THE SOUTHWEST CORNER OF THE EXISTING TENNIS COURT FENCING.

REFERENCE ONLY

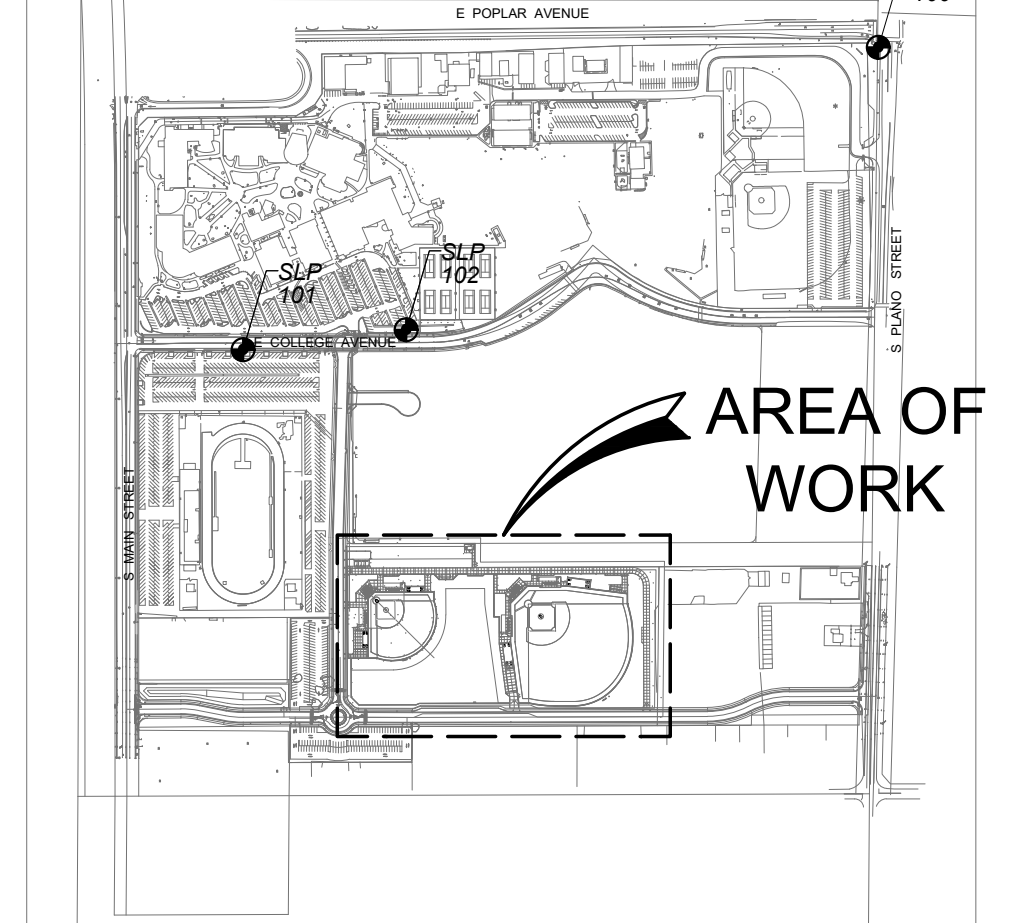

KEYMAP

General Notes

Blair, Church & Flynn Consulting Engineers logo and contact information.

PORTERVILLE COLLEGE ATHLETIC COMPLEX PHASE I 100 E COLLEGE AVE. PORTERVILLE, CA 93257

HORIZONTAL CONTROL LEGEND

Darden Architects logo and contact information.

Revision table with columns for No., Revision/Submission, and Date. Includes entry for ADDENDUM 02 dated 01/11/2024.


NORTHING EASTING TABLE

Table with columns: POINT, NORTHING, EASTING, ABV, DESCRIPTION. Contains 107 rows of coordinate data.

Table with columns: POINT, NORTHING, EASTING, ABV, DESCRIPTION. Contains 107 rows of coordinate data.

Table with columns: POINT, NORTHING, EASTING, ABV, DESCRIPTION. Contains 107 rows of coordinate data.

Table with columns: POINT, NORTHING, EASTING, ABV, DESCRIPTION. Contains 107 rows of coordinate data.

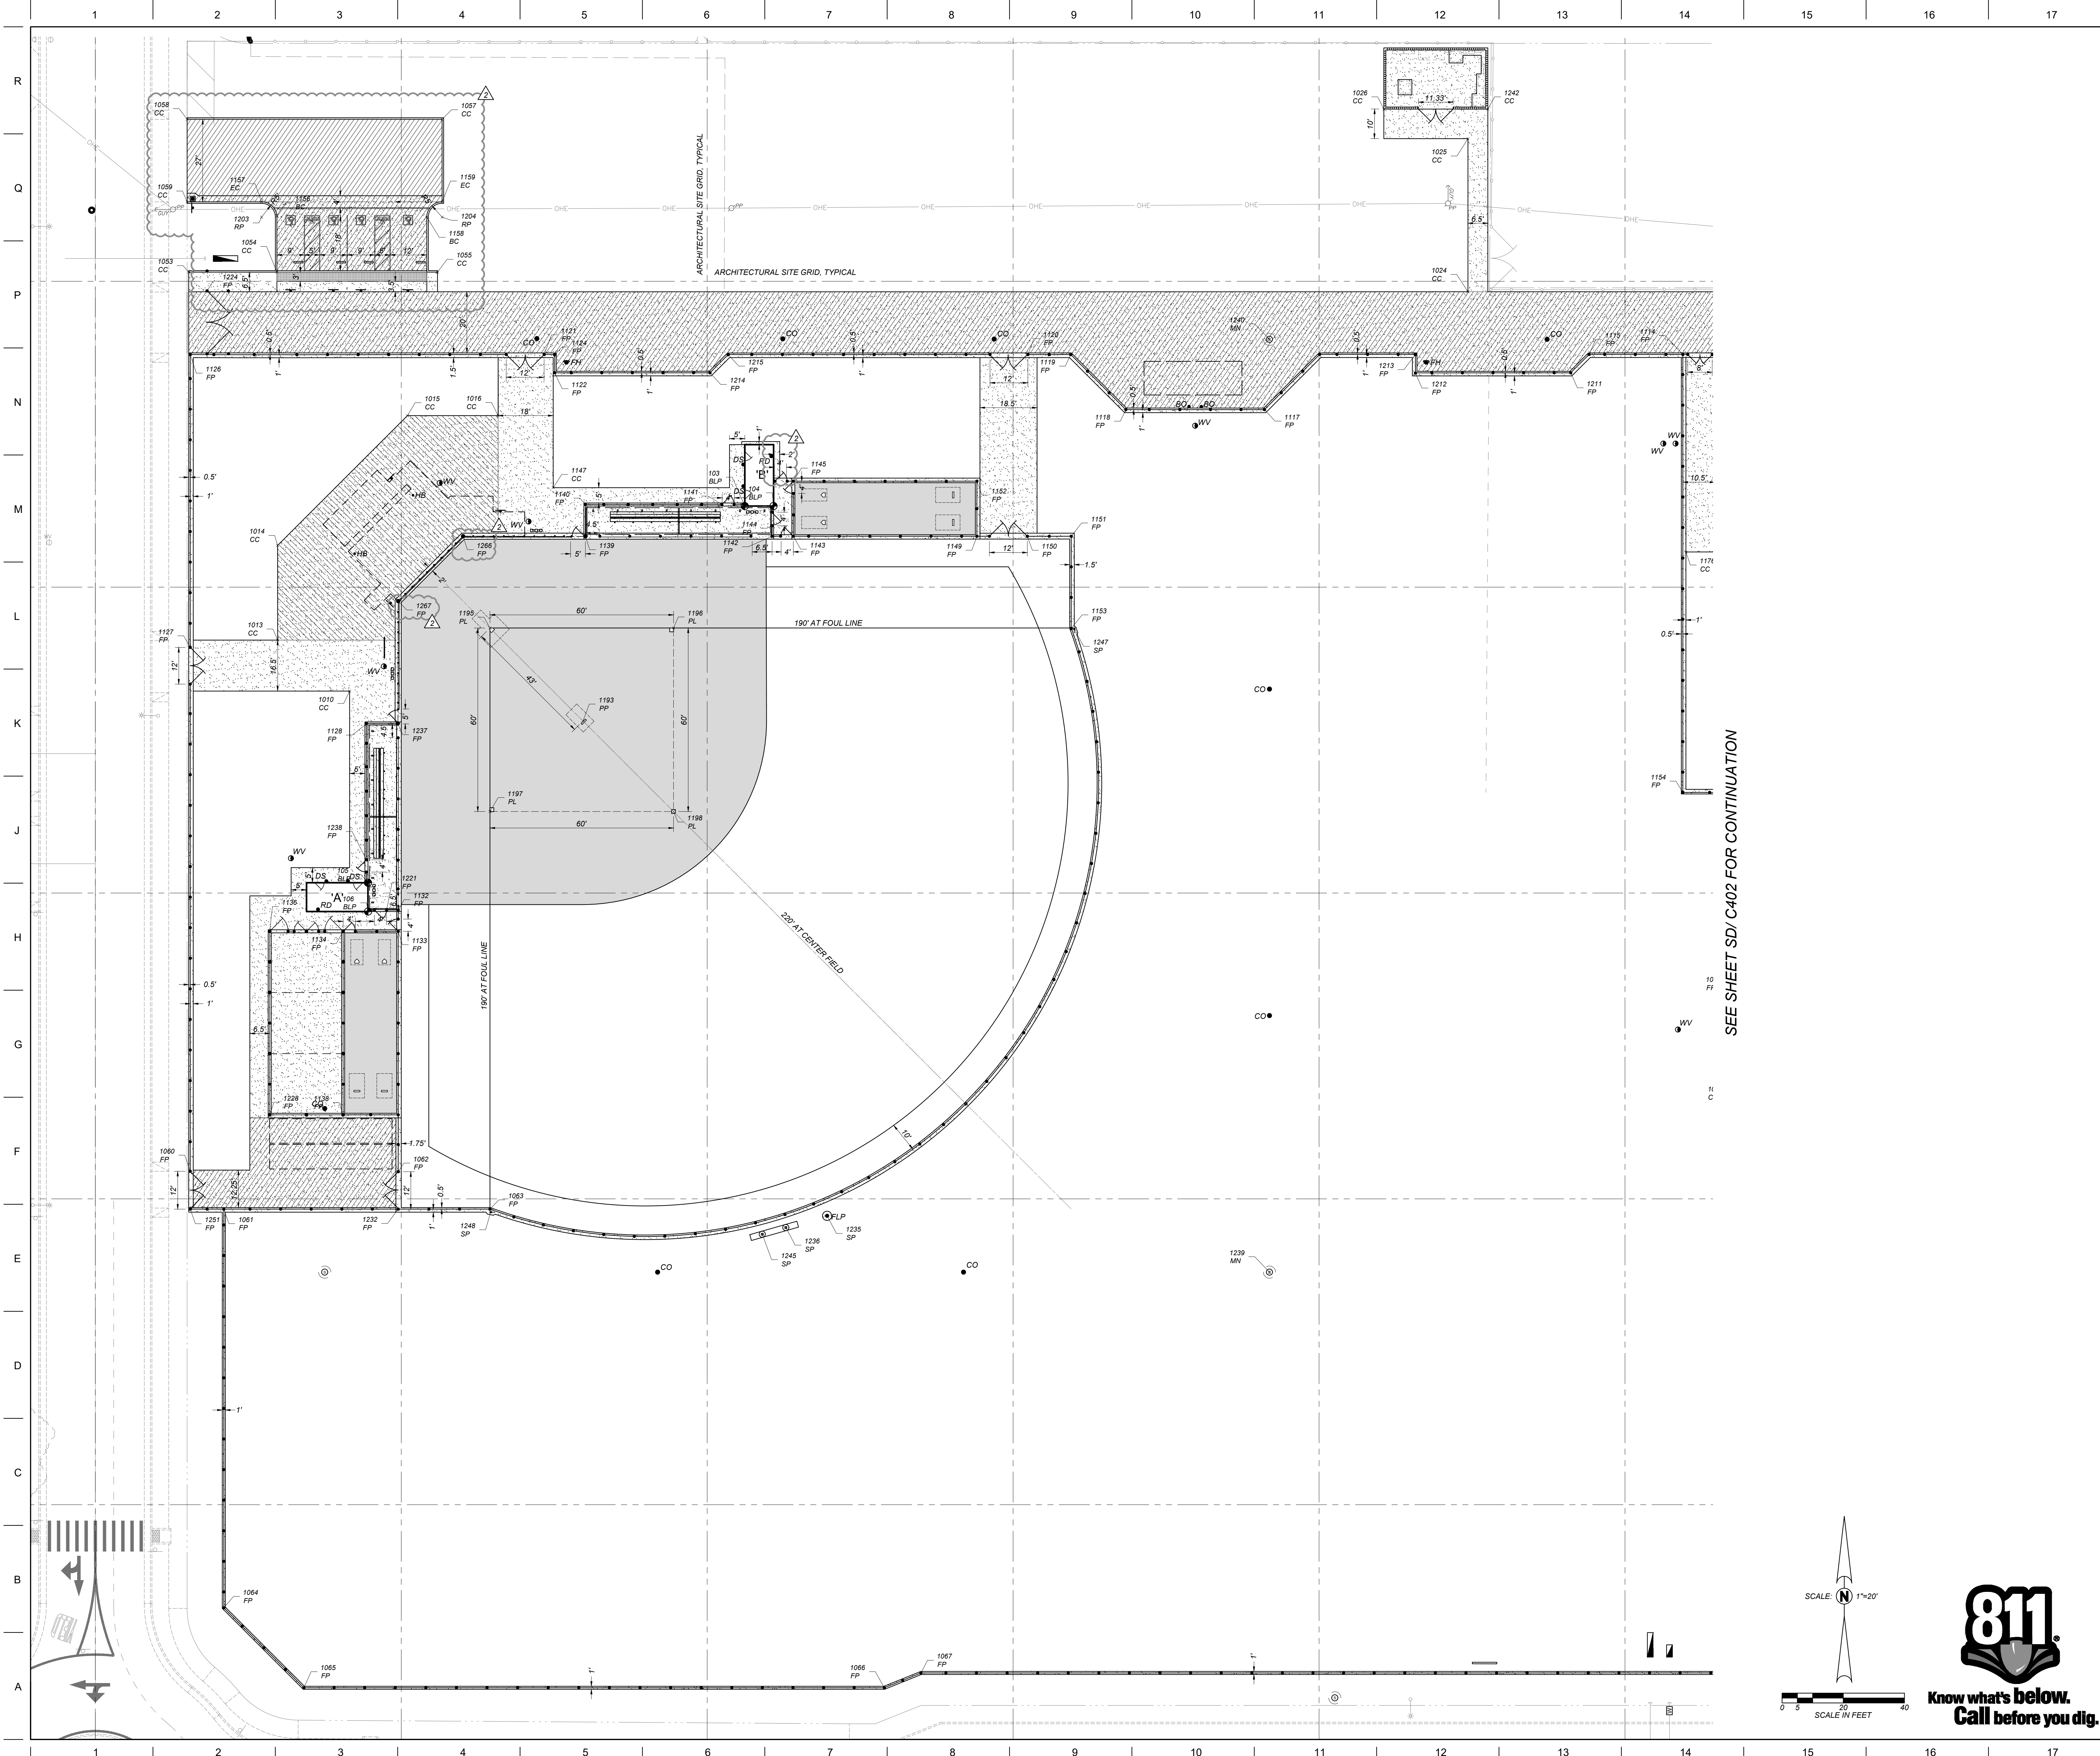

SEE SHEET SD/C402 FOR CONTINUATION

DSA File No.: 15-C1
 DSA Application No.: 03-122694

Agency Approval

HORIZONTAL CONTROL LEGEND:

- SLP SITE LAYOUT POINT
- BLP BUILDING LAYOUT POINT
- ✓ LCP LAYOUT COORDINATE POINT
- BC BEGIN OF CURVE
- CC CORNER CONCRETE
- EC END OF CURVE
- FP FENCE POST
- GR DRAIN INLET GRATE
- MN MANHOLE
- PL BASEBALL/ SOFTBALL PLATE
- PP CENTER OF PITCHER'S PLATE
- RP RADIUS POINT
- SP SPORT POST

GENERAL HORIZONTAL CONTROL NOTES:

1. REFERENCE GRID LINES ARE SPACED 40'-0". CENTERLINE TO CENTERLINE AND ARE BASED ON THE ARCHITECT'S DESIGN GRID FOR THE PROJECT
2. DIMENSIONS AND POINTS ARE TO CENTER OF FENCE POSTS, FACE OF BUILDINGS, TOP FACE OF CURB, OR EDGE OF CONCRETE, UNLESS SHOWN OTHERWISE
3. HORIZONTAL CONTROL POINTS PROVIDED ARE BASED ON AN ASSUMED COORDINATE SYSTEM GOVERNED BY THE CONTROL POINTS FOR THE PROJECT
4. SITE LAYOUT POINT 100 IS A BENCHMARK FOR THIS PROJECT. IT IS THE TOP OF CURB ELEVATION AT THE NORTH END OF THE SOUTHWEST RETURN AT HIGHWAY 190 AND PLANO ROAD INTERSECTION
5. SITE LAYOUT POINT 101 IS A BENCHMARK TO BE USED FOR CONSTRUCTION. IT IS A PARKER-KALON (PK) NAIL ON THE SOUTH SIDE OF EAST COLLEGE AVENUE APPROXIMATELY 380' SOUTH EAST OF THE INTERSECTION BETWEEN EAST COLLEGE AVENUE AND SOUTH MAIN STREET
6. SITE LAYOUT POINT 102 IS A PARKER-KALON (PK) NAIL AT THE SOUTHWEST PARKING LOT APPROXIMATELY 53' SOUTH WEST OF THE SOUTHWEST CORNER OF THE EXISTING TENNIS COURT FENCING.

REFERENCE ONLY

KEYMAP

General Notes

Blair, Church & Flynn
 Consulting Engineers
 Blair, Church & Flynn Consulting Engineers
 451 Clovis Avenue, Suite 200
 Clovis, California 93612
 Tel (559) 326-1400 Fax (559) 326-1500

Professional Engineer Seal: Robert D. Blair, No. 57218, State of California

Consultant

PORTERVILLE COLLEGE ATHLETIC COMPLEX
 PHASE I
 100 E COLLEGE AVE.
 PORTERVILLE, CA 93257

Project

HORIZONTAL CONTROL PLAN
 Drawing

darden architects
 ARCHITECTURE PLANNING INTERIORS
 www.dardenarchitects.com
 6790 N. West Ave. • Fresno, CA 93711 • T. 559.448.8051

Licensed Architect Seal: Robert L. Peterson, No. L19988, State of California

Architect

No.	Revision/Submission	Date
▲	ADDENDUM 02	01/11/2024

Revision


Designed By:	ZH	Copyright	2024 Darden Architects
Scale:	AS NOTED	Drawn By:	AH
Project Number:	2118	Checked By:	JF
Date:	12/28/2023	Reviewed By:	ZH

SD/C401
AD2-CX04

811 Know what's below. Call before you dig.

SCALE: 1"=20'
 SCALE IN FEET

Drawing: P:\221-01761-01\Production\Drawings\2211761_01.dwg, Layout1 - RZF.cpl
 Plot by: System on 12/28/2024 6:53pm

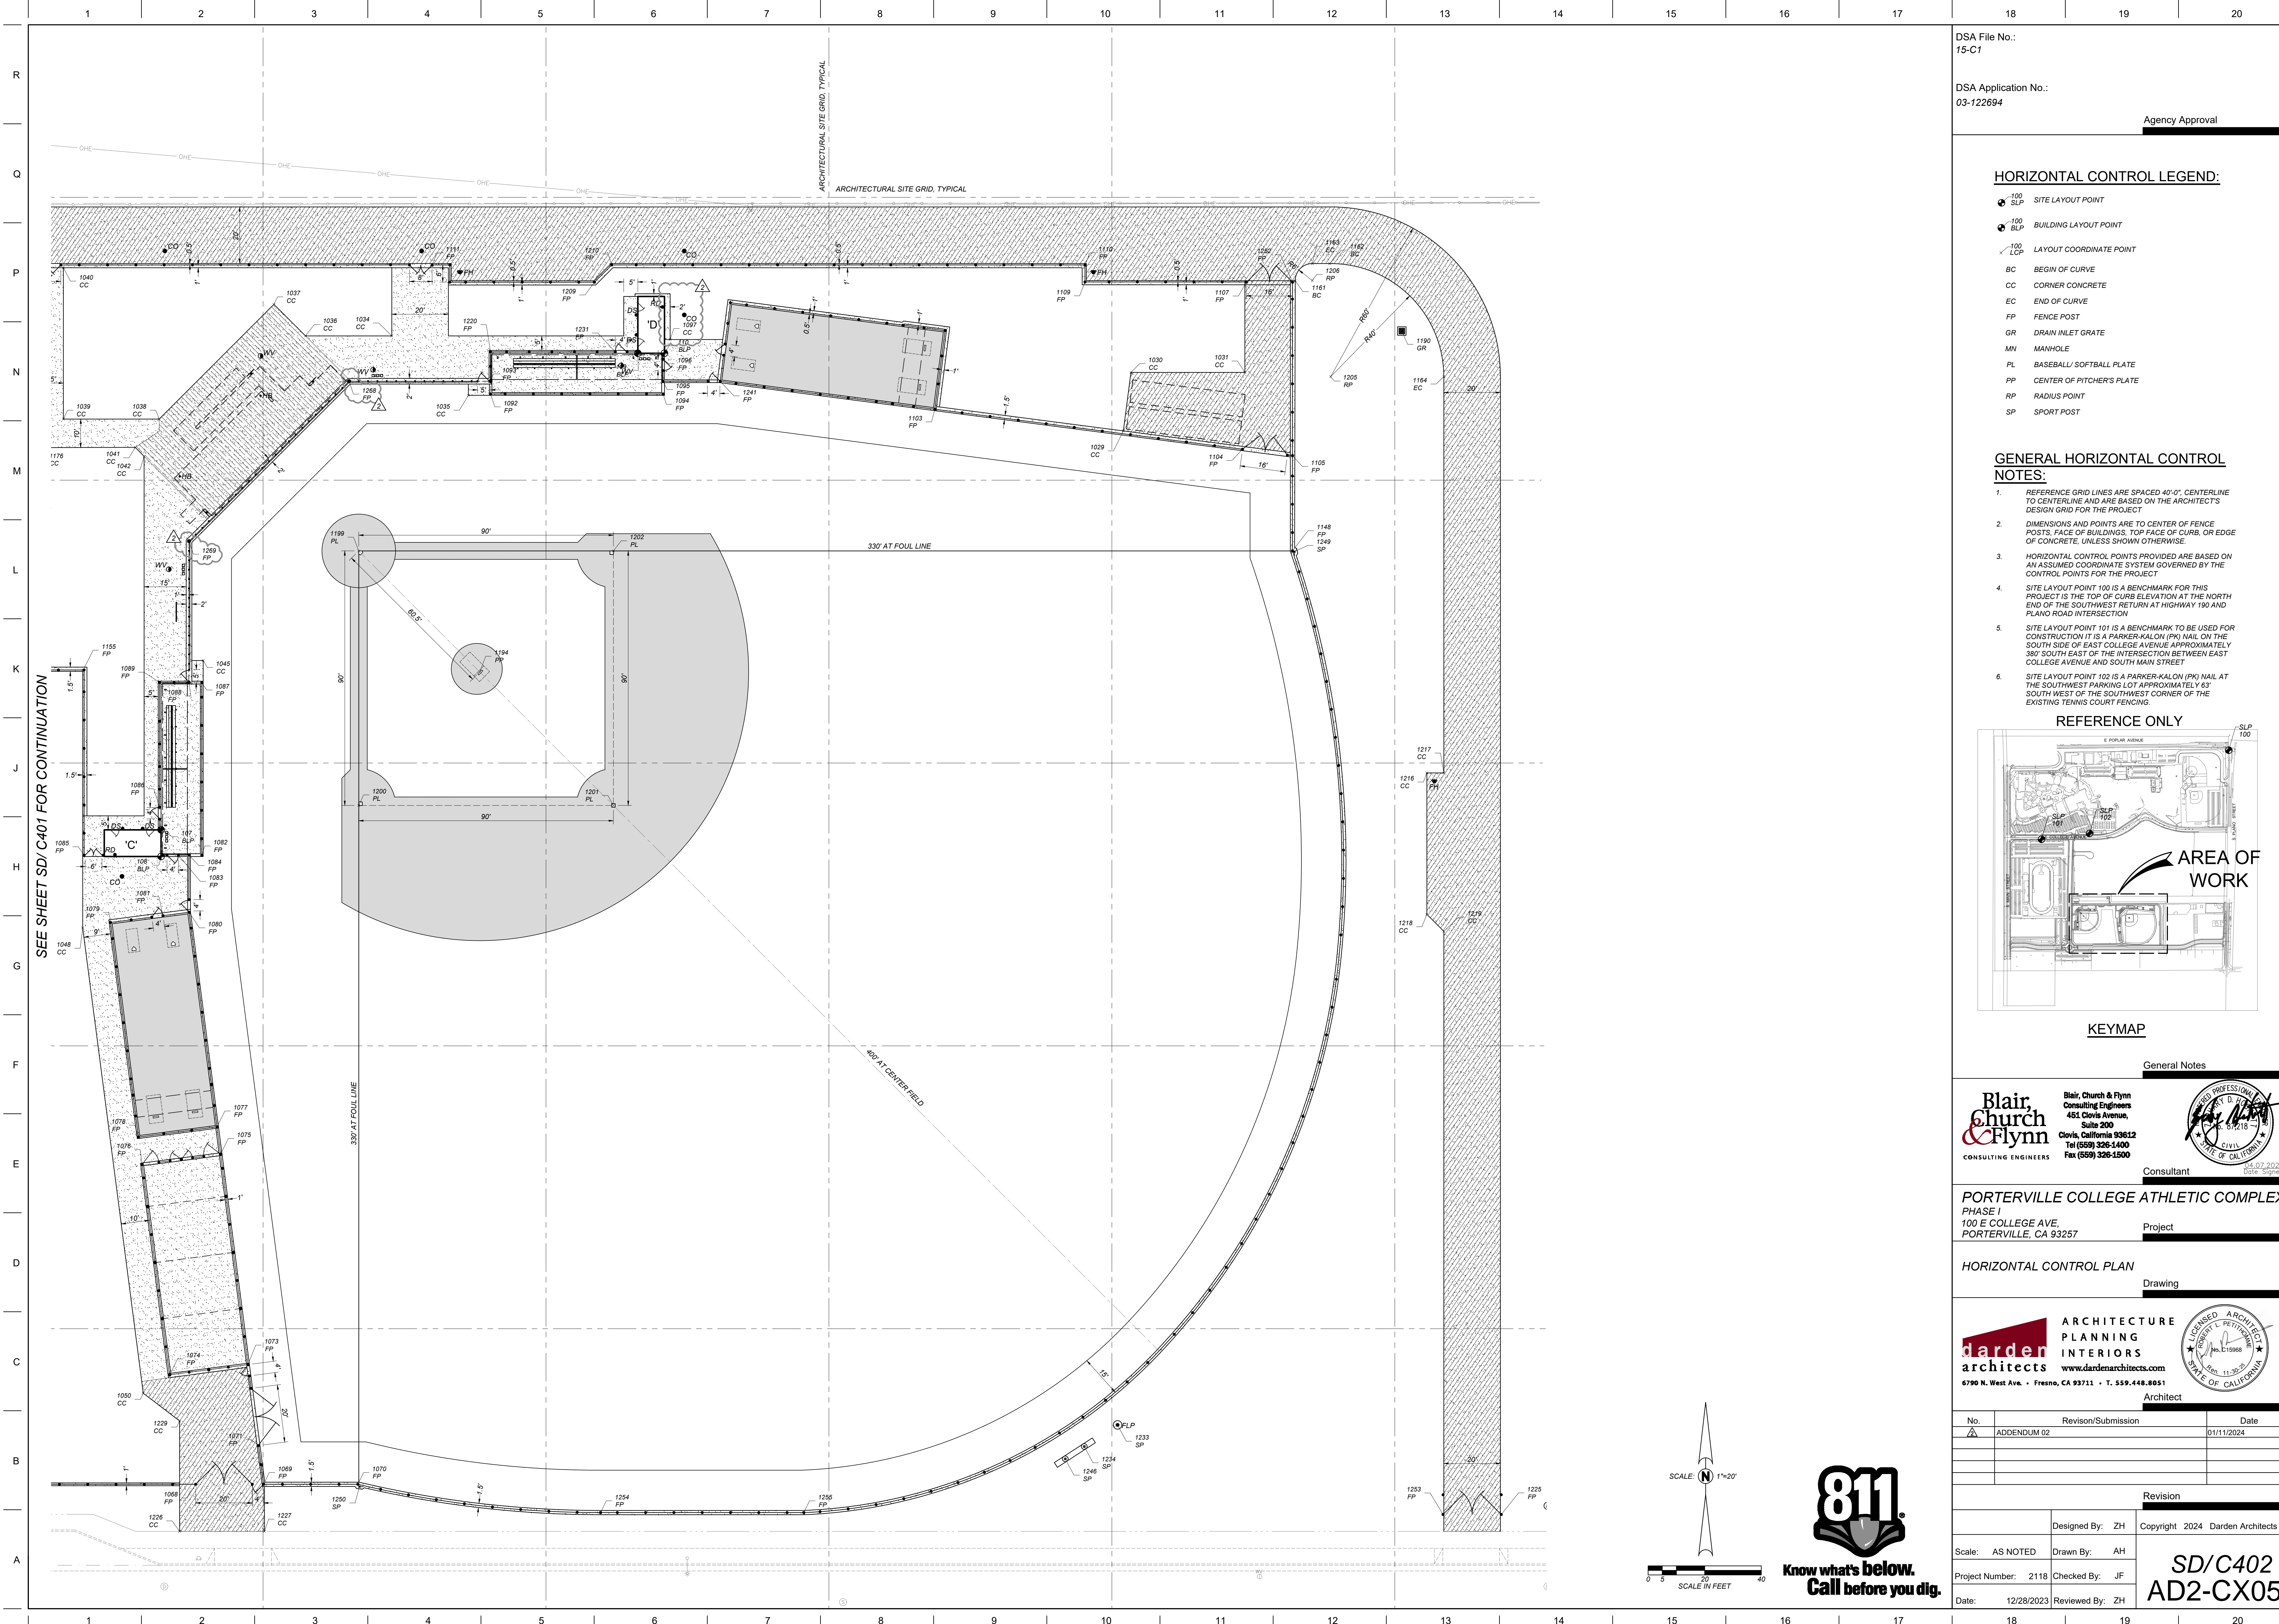

DSA File No.: 15-C1

DSA Application No.: 03-122694

Agency Approval


HORIZONTAL CONTROL LEGEND:

- 100 SLP SITE LAYOUT POINT
- 100 BLP BUILDING LAYOUT POINT
- ✓ 100 LCP LAYOUT COORDINATE POINT
- BC BEGIN OF CURVE
- CC CORNER CONCRETE
- EC END OF CURVE
- FP FENCE POST
- GR DRAIN INLET GRATE
- MN MANHOLE
- PL BASEBALL / SOFTBALL PLATE
- PP CENTER OF PITCHER'S PLATE
- RP RADIUS POINT
- SP SPORT POST

GENERAL HORIZONTAL CONTROL NOTES:

1. REFERENCE GRID LINES ARE SPACED 40'-0". CENTERLINE TO CENTERLINE AND ARE BASED ON THE ARCHITECT'S DESIGN GRID FOR THE PROJECT
2. DIMENSIONS AND POINTS ARE TO CENTER OF FENCE POSTS, FACE OF BUILDINGS, TOP FACE OF CURB, OR EDGE OF CONCRETE, UNLESS SHOWN OTHERWISE
3. HORIZONTAL CONTROL POINTS PROVIDED ARE BASED ON AN ASSUMED COORDINATE SYSTEM GOVERNED BY THE CONTROL POINTS FOR THE PROJECT
4. SITE LAYOUT POINT 100 IS A BENCHMARK FOR THIS PROJECT IS THE TOP OF CURB ELEVATION AT THE NORTH END OF THE SOUTHWEST RETURN AT HIGHWAY 190 AND PLANO ROAD INTERSECTION
5. SITE LAYOUT POINT 101 IS A BENCHMARK TO BE USED FOR CONSTRUCTION IT IS A PARKER-KALON (PK) NAIL ON THE SOUTH SIDE OF EAST COLLEGE AVENUE APPROXIMATELY 380' SOUTH EAST OF THE INTERSECTION BETWEEN EAST COLLEGE AVENUE AND SOUTH MAIN STREET
6. SITE LAYOUT POINT 102 IS A PARKER-KALON (PK) NAIL AT THE SOUTHWEST CORNER OF THE EXISTING TENNIS COURT FENCING.

REFERENCE ONLY

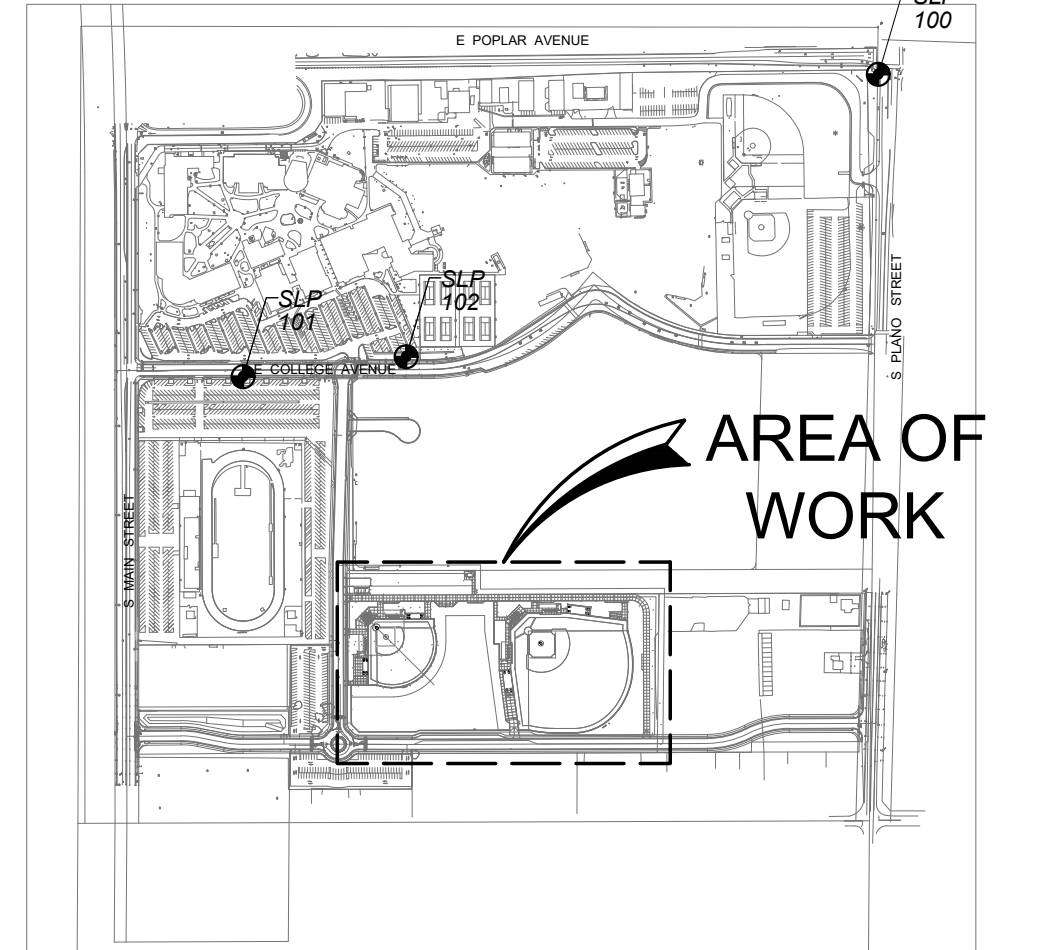

KEYMAP

General Notes

Blair, Church & Flynn
 CONSULTING ENGINEERS
 Blair, Church & Flynn Consulting Engineers
 451 Clovis Avenue, Suite 200
 Clovis, California 93212
 Tel (559) 326-1400 Fax (559) 326-1500


PORTERVILLE COLLEGE ATHLETIC COMPLEX
 PHASE I
 100 E COLLEGE AVE.
 PORTERVILLE, CA 93257


HORIZONTAL CONTROL PLAN
 Drawing

darden architects
 ARCHITECTURE PLANNING INTERIORS
 www.dardenarchitects.com
 6790 N. West Ave. • Fresno, CA 93711 • T. 559.448.8051

No.	Revision/Submission	Date
ADDENDUM 02		01/11/2024

Revision	
Designed By: ZH	Copyright 2024 Darden Architects
Scale: AS NOTED	Drawn By: AH
Project Number: 2118	Checked By: JF
Date: 12/28/2023	Reviewed By: ZH

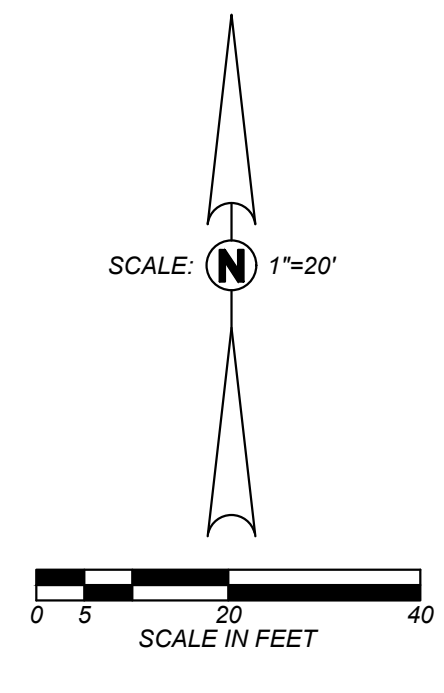

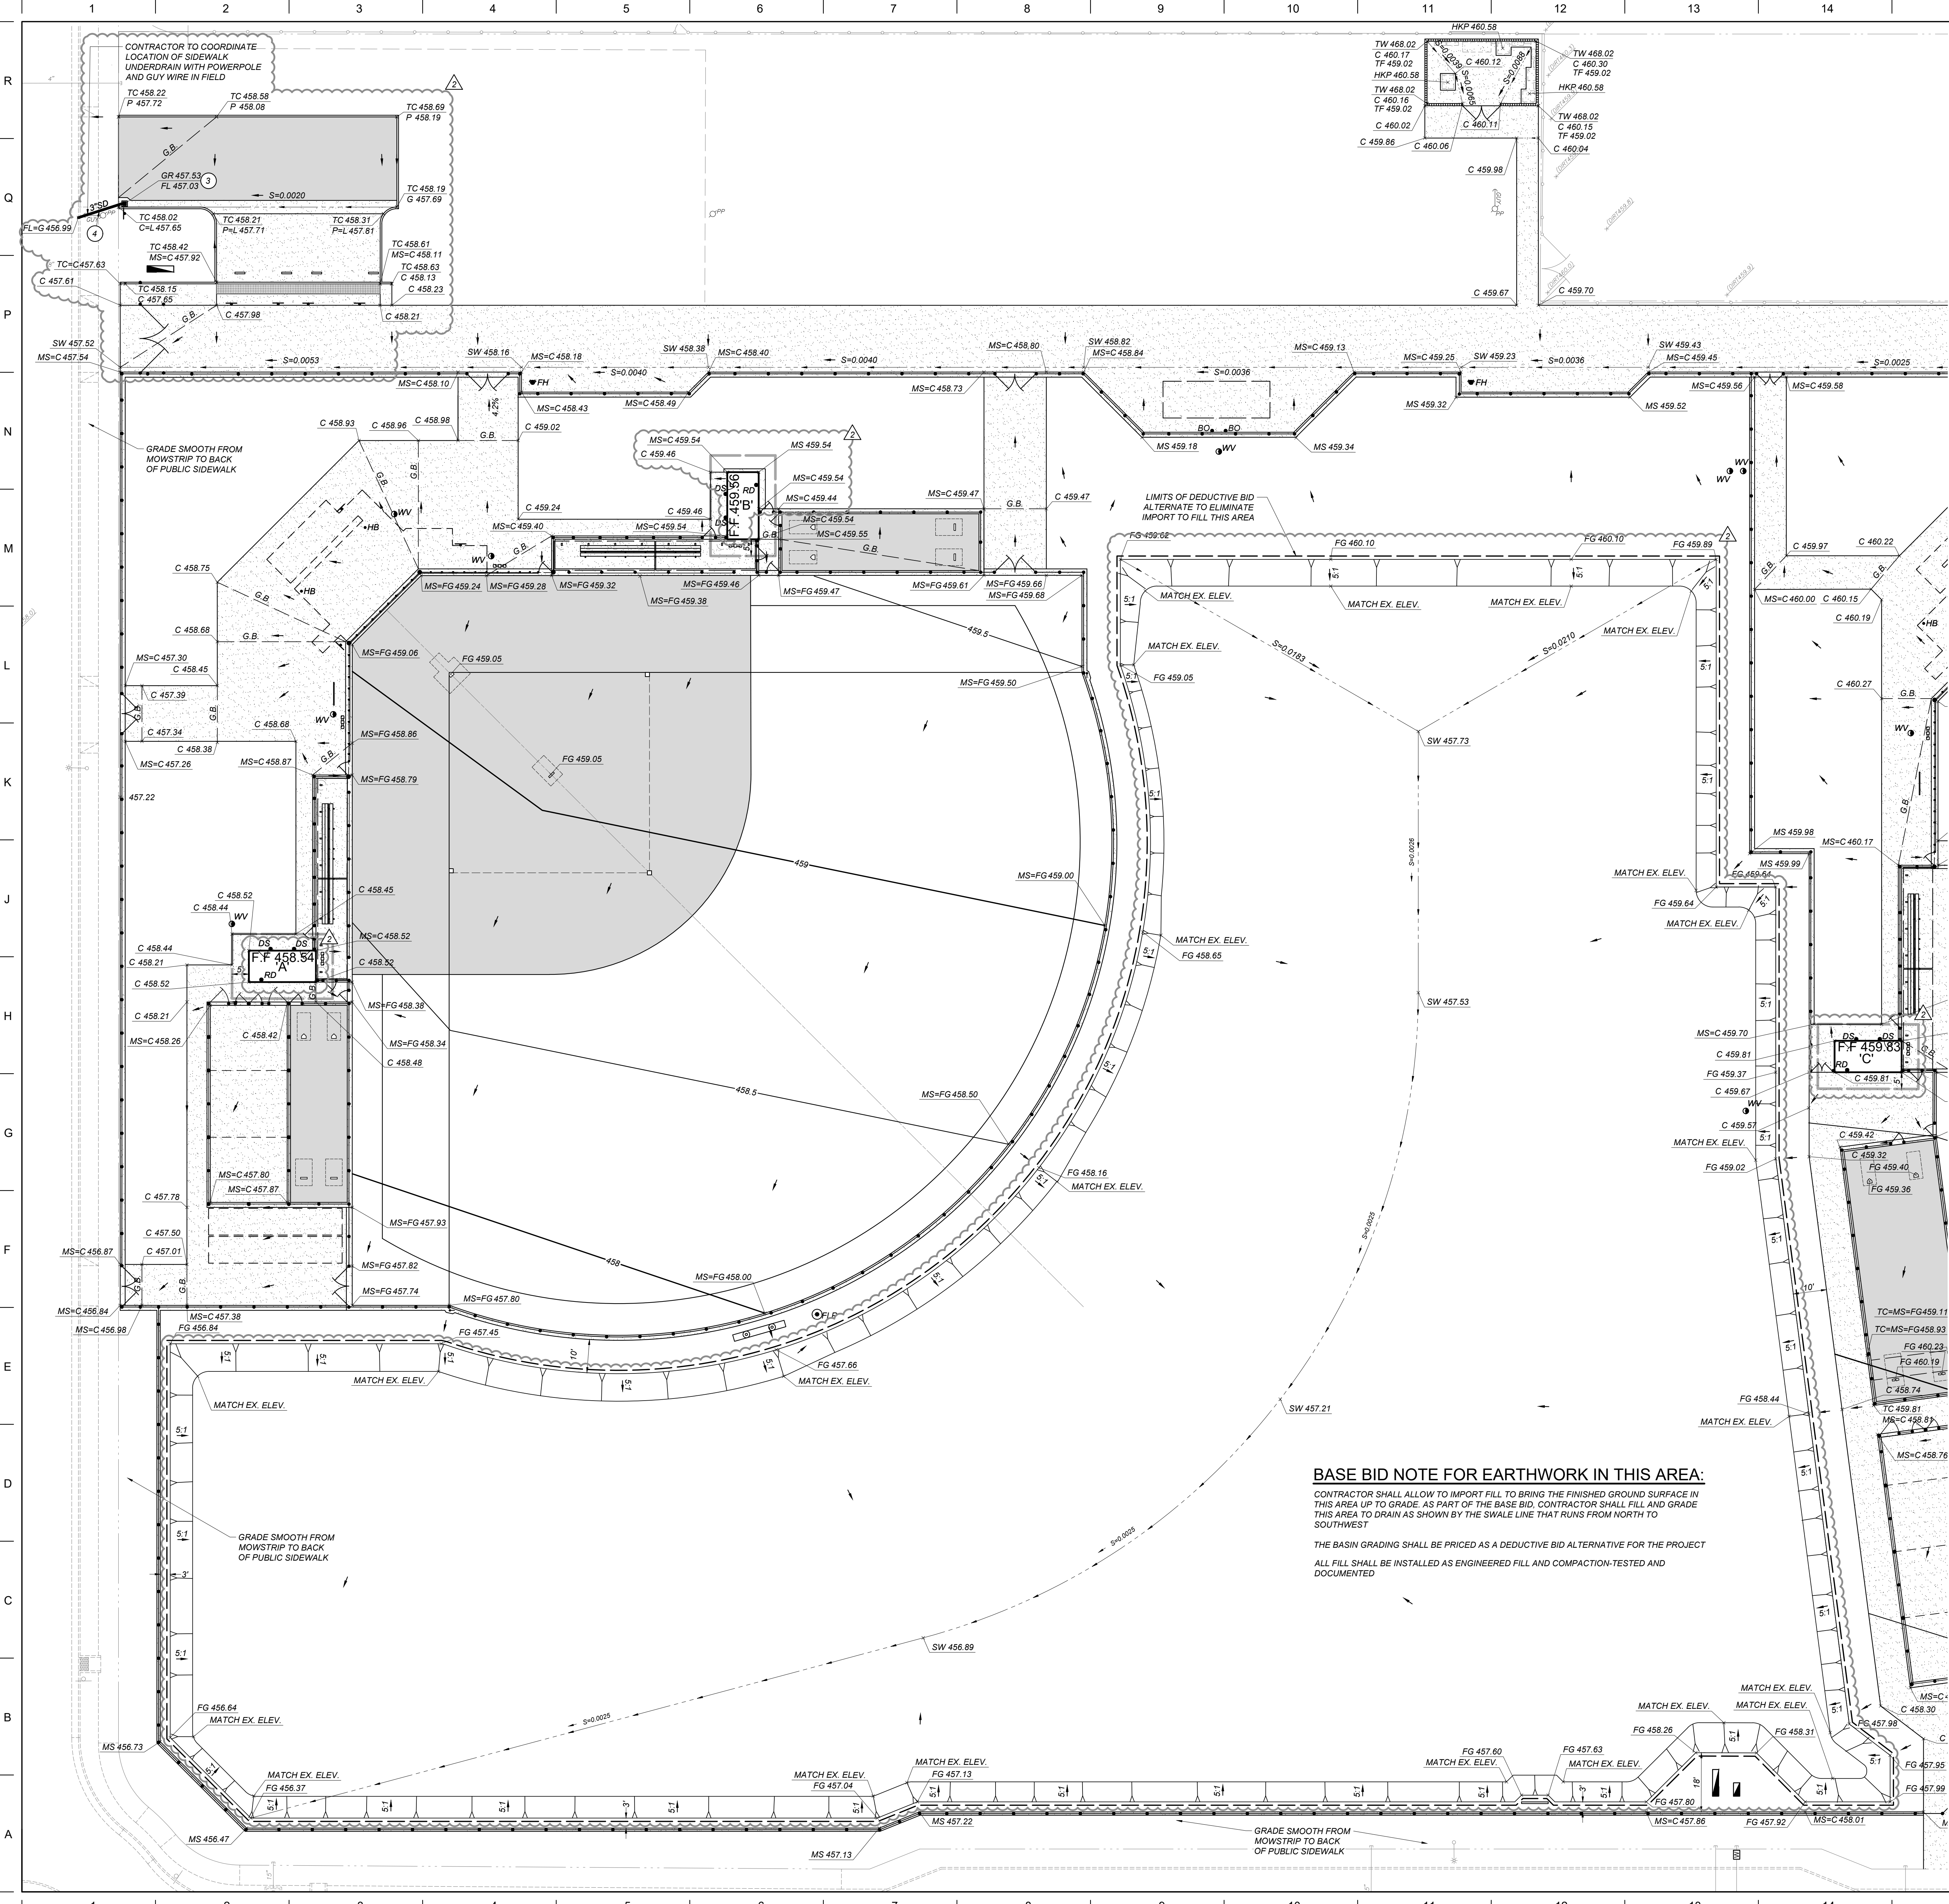

GRADING AND DRAINAGE LEGEND:

C	CONCRETE
FF	FINISHED FLOOR
FG	FINISHED GRADE
FL	FLOWLINE
G	GUTTER
GR	STORM DRAIN GRATE
HKP	HOUSE KEEPING PAD
MS	MOWSTRIP
P	PAVEMENT
SW	SWALE
(344)	EXISTING ELEVATION
---	NEW FINISHED GRADE
---	DIRECTION OF SURFACE DRAINAGE
---	BUILDING OVER-EXCAVATION LIMITS; SEE DETAIL [E/SD/X201]
G.B.	GRADE BREAK
---	LIMITS OF GRADING
---	PIPE SLOPE AND DIRECTION OF FLOW
---	SWALE AND DIRECTION OF FLOW
---	PROPOSED MAJOR GRADE CONTOUR LINE
---	PROPOSED MINOR GRADE CONTOUR LINE
(1)	U23 STORM DRAIN INLET PER DETAIL [D/SD/X202]
(2)	STORM DRAIN MANHOLE PER DETAIL [G/SD/X201]
(3)	V12 STORM DRAIN INLET PER DETAIL [G/SD/X202]
(4)	SIDE WALK UNDERDRAIN PER DETAIL [H/SD/X202]
(5)	STORM DRAIN MANHOLE
6"SD	PVC STORM DRAIN PIPELINE; SIZE AS NOTED ON PLANS; TRENCH AND BACKFILL PER DETAIL [F/SD/X201]
S=0.0020	FLOWLINE SLOPE AND DIRECTION OF FLOW

DSA File No.: 15-C1
 DSA Application No.: 03-122694
 Agency Approval

GENERAL GRADING AND DRAINAGE NOTES:

- CONSTRUCTION OF ALL PROJECT SITE IMPROVEMENTS SUBJECT TO ADA ACCESS COMPLIANCE, INCLUDING ACCESSIBLE PATH OF TRAVEL, CURB BURNS, PARKING STALL(S) AND UNLOADING AREAS, BARRIER FREE AMENITIES AND/OR OTHER APPLICABLE SITE IMPROVEMENTS SHALL CONFORM TO THE AMERICANS WITH DISABILITIES ACT, CALIFORNIA TITLE 24, THE CALIFORNIA BUILDING CODE, REGULATIONS AND/OR BUILDING CODES.
- CONTRACTOR SHALL FIELD VERIFY ALL GRADES AND SLOPES PRIOR TO THE PLACEMENT OF CONCRETE AND/OR PAVEMENT FOR CONFORMANCE WITH ADA ACCESS COMPLIANCE REQUIREMENTS. EXAMPLES OF MINIMUM AND MAXIMUM LIMITS RELATED TO ADA ACCESS COMPLIANCE INCLUDE, BUT ARE NOT LIMITED TO:
 - ACCESSIBLE PATH OF TRAVEL CROSS-SLOPE SHALL NOT EXCEED 2%
 - ACCESSIBLE PATH OF TRAVEL LONGITUDINAL SLOPES SHALL NOT EXCEED 5%
 - RAMP LONGITUDINAL SLOPES SHALL NOT EXCEED 8.33%
 - ACCESSIBLE WALKS SHALL NOT HAVE LESS THAN 48 INCHES IN UNOBSTRUCTED WIDTH
 - ACCESSIBLE PARKING SPACES AND ACCESS AISLES SHALL NOT EXCEED 2% SLOPE IN ANY DIRECTION
 - LANDINGS AT THE TOP AND BOTTOM OF ACCESSIBLE RAMPS SHALL NOT EXCEED 2% SLOPE IN ANY DIRECTION
 - GUTTERS AND ROAD SURFACES DIRECTLY ADJACENT TO AND WITHIN 2 FEET OF A CURB RAMP SHALL HAVE A COUNTER SLOPE NOT TO EXCEED 5%
- CONTRACTOR MUST IMMEDIATELY NOTIFY THE ENGINEER OF RECORD, IDENTIFIED BY THE PROFESSIONAL ENGINEERING SEAL AND SIGNATURE ON THESE PLANS, OF ANY SITE CONDITIONS AND/OR DESIGN INFORMATION THAT PREVENTS THE CONTRACTOR FROM COMPLYING WITH THE LAWS, REGULATIONS AND/OR BUILDING CODES GOVERNING ADA ACCESS COMPLIANCE.
- GROUND SLOPES AWAY FROM BUILDING PADS IN LANDSCAPED OR DIRT AREAS SHALL BE NO LESS THAN 3% FOR AT LEAST TEN (10) FEET, OR AS OTHERWISE NOTED ON THE PLANS.
- DRAINAGE SHALL NOT BE ALLOWED ONTO ADJACENT PROPERTY.
- ALL FILL MATERIAL USED TO SUPPORT THE FOUNDATIONS OF ANY BUILDING OR STRUCTURE SHALL BE PLACED UNDER THE DIRECTION OF A LICENSED GEOTECHNICAL ENGINEER, AND IN COMPLIANCE WITH THE PROJECT SPECIFICATIONS. A SOILS COMPACTION REPORT SHALL BE SUBMITTED TO THE ENGINEER OF RECORD AS REQUIRED BY THE PROJECT SPECIFICATIONS.
- THE CONTRACTOR SHALL IMPLEMENT DUST CONTROL MEASURES AS REQUIRED BY THE PROJECT SPECIFICATIONS, AND BY GOVERNING PUBLIC AGENCIES.
- THE CONTRACTOR SHALL IMPLEMENT A STORM WATER POLLUTION PREVENTION PLAN (SWPPP) AS REQUIRED BY THE PROJECT SPECIFICATIONS AND THE STATE WATER RESOURCES CONTROL BOARD'S CONSTRUCTION GENERAL PERMIT. IMPLEMENT BEST MANAGEMENT PRACTICES WITHIN PUBLIC RIGHT OF WAY PER LOCAL JURISDICTION REQUIREMENTS.
- AS A FIRST ORDER OF WORK, THE CONTRACTOR SHALL POT-HOLE THE EXISTING UTILITY LINES AT THE POINT OF CONNECTION TO VERIFY THE LOCATION, SIZE, PIPE MATERIAL AND ELEVATION SO THAT THE ENGINEER CAN MAKE ELEVATION AND/OR ALIGNMENT ADJUSTMENTS IF NECESSARY. SHOULD POT-HOLING DISCOVER ANY DISCREPANCIES, CONTACT THE ENGINEER AND OBTAIN WRITTEN DIRECTION BEFORE PROCEEDING.
- ADJUST UTILITY LIDS WITHIN NEW CONSTRUCTION AREA TO FINISHED GRADE PER DETAIL [D/SD/X201]. REPLACE ALL BROKEN LIDS WITH NEW. PROVIDE TRAFFIC RATED LIDS WITHIN VEHICLE LOADING AREAS.
- WATER TEST PAVEMENT WITHIN NEW IMPROVEMENT AREA. REPLACE PAVEMENT WHERE BIRD BATHS OCCUR AFTER TEST AS DIRECTED BY THE INSPECTOR OR ENGINEER.
- MINIMUM SLOPE ON IMPERVIOUS SURFACES PERPENDICULAR TO ADJACENT STRUCTURE(S), WITHIN ADA PATH, SHALL BE 1% MINIMUM AND 2% MAXIMUM. WHERE DOOR AND GATE LANDINGS OCCUR THE CROSS SLOPE SHALL BE 2% MAXIMUM IN ALL DIRECTIONS.

SEE SHEET SD/ C502 FOR CONTINUATION

BASE BID NOTE FOR EARTHWORK IN THIS AREA:
 CONTRACTOR SHALL ALLOW TO IMPORT FILL TO BRING THE FINISHED GROUND SURFACE IN THIS AREA UP TO GRADE, AS PART OF THE BASE BID. CONTRACTOR SHALL FILL AND GRADE THIS AREA TO DRAIN AS SHOWN BY THE SWALE LINE THAT RUNS FROM NORTH TO SOUTHWEST.
 THE BASIN GRADING SHALL BE PRICED AS A DEDUCTIVE BID ALTERNATIVE FOR THE PROJECT ALL FILL SHALL BE INSTALLED AS ENGINEERED FILL AND COMPACTION-TESTED AND DOCUMENTED.

Blair, Church & Flynn Consulting Engineers
 461 Clovis Avenue, Suite 300
 Clovis, California 93612
 Tel (559) 326-1400 Fax (559) 326-1500

Consultant

PORTERVILLE COLLEGE ATHLETIC COMPLEX
 PHASE I
 100 E COLLEGE AVE,
 PORTERVILLE, CA 93257

Project

GRADING PLAN

Drawing

darden architects
 ARCHITECTURE PLANNING INTERIORS
 www.dardenarchitects.com
 6790 N. West Ave. • Fresno, CA 93711 • T. 559.448.8051

Architect

No.	Revision/Submission	Date
1	ADDENDUM 02	01/11/2024


Revision


Designed By: ZH
 Copyright 2024 Darden Architects

Scale: AS NOTED
 Project Number: 2118
 Date: 12/28/2023

Drawn By: AH
 Checked By: JF
 Reviewed By: ZH

**SD/C501
 AD2-CX06**

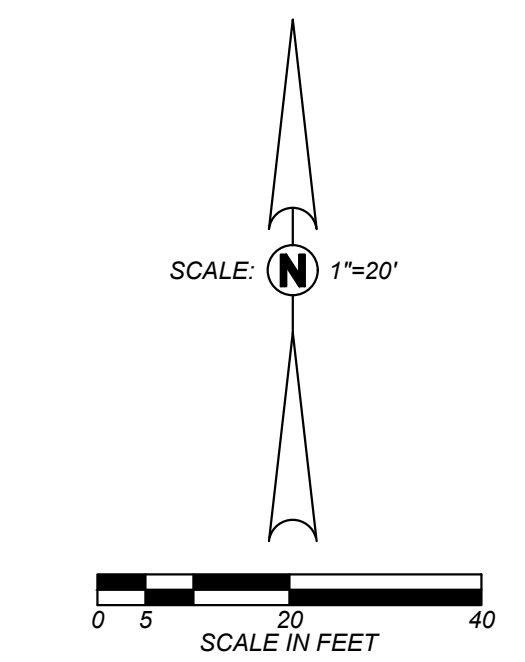

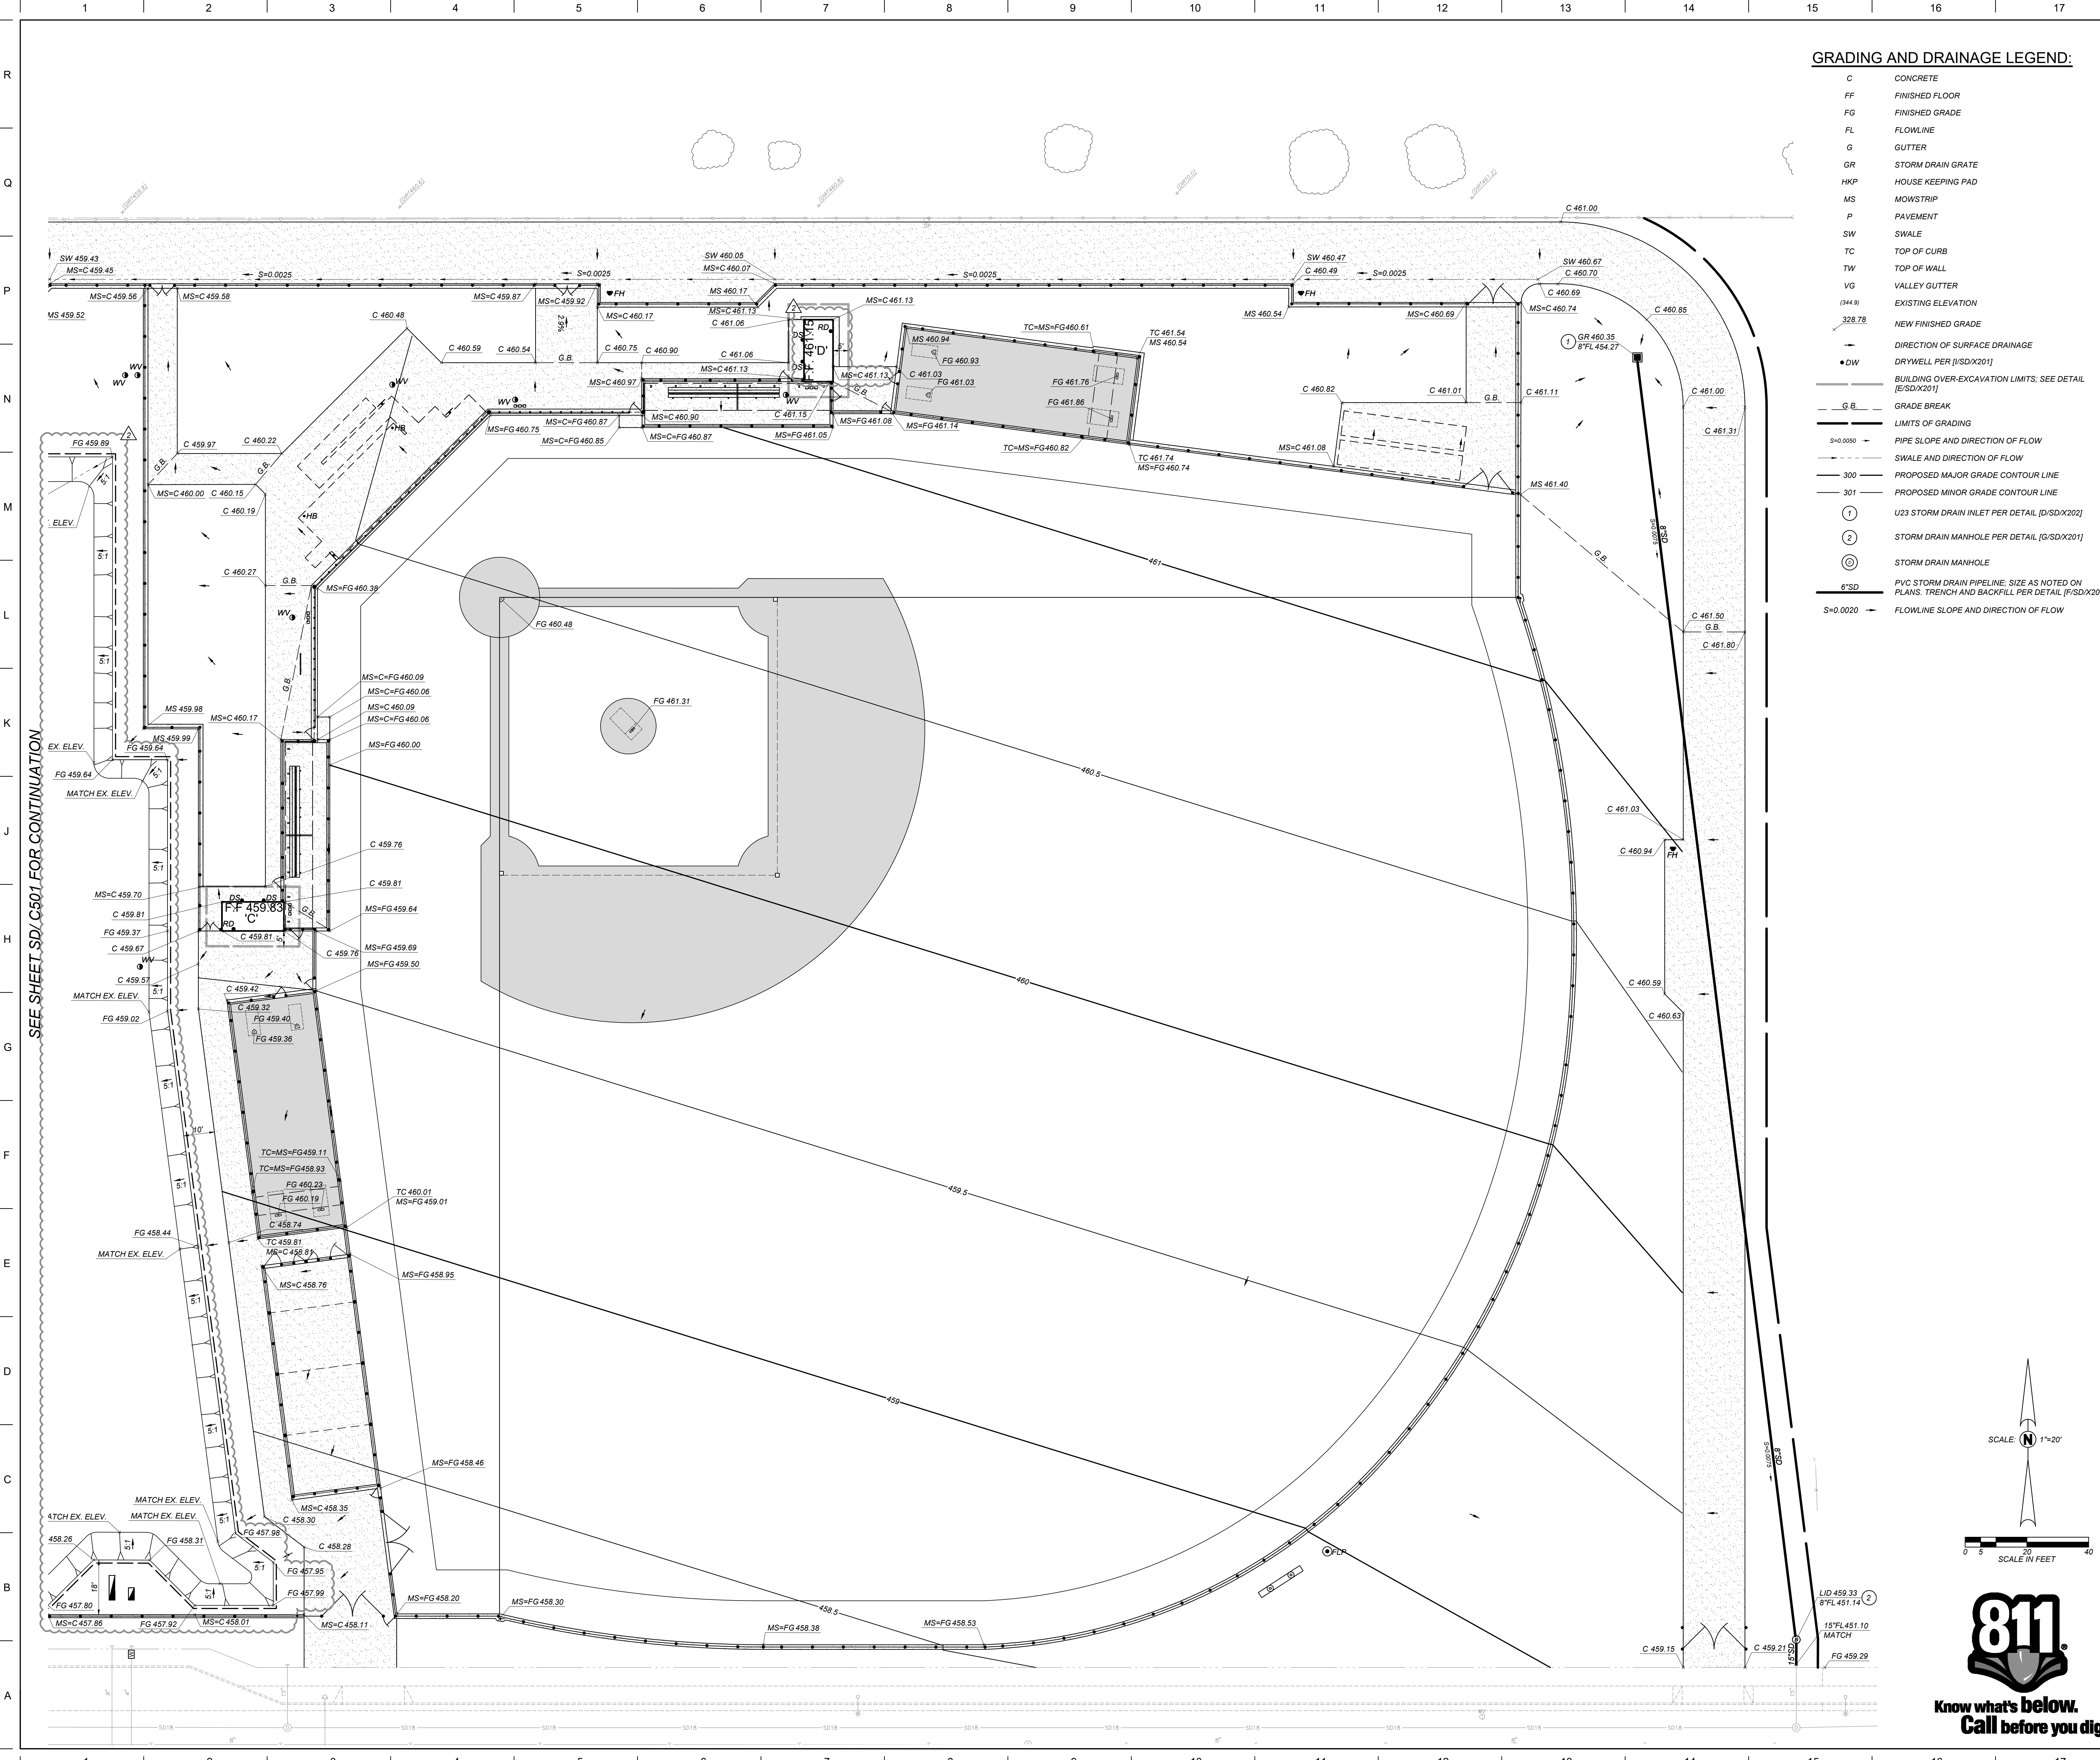

GRADING AND DRAINAGE LEGEND:

- C CONCRETE
- FF FINISHED FLOOR
- FG FINISHED GRADE
- FL FLOWLINE
- G GUTTER
- GR STORM DRAIN GRATE
- HKP HOUSE KEEPING PAD
- MS MOWSTRIP
- P PAVEMENT
- SW SWALE
- (34.9) EXISTING ELEVATION
- 328.78 NEW FINISHED GRADE
- DIRECTION OF SURFACE DRAINAGE
- DW DRYWELL PER [SD/X201]
- G.B. GRADE BREAK
- LIMITS OF GRADING
- S=0.0050 PIPE SLOPE AND DIRECTION OF FLOW
- SWALE AND DIRECTION OF FLOW
- 300 PROPOSED MAJOR GRADE CONTOUR LINE
- 301 PROPOSED MINOR GRADE CONTOUR LINE
- ① U23 STORM DRAIN INLET PER DETAIL [D/SD/X202]
- ② STORM DRAIN MANHOLE PER DETAIL [G/SD/X201]
- ⊙ STORM DRAIN MANHOLE
- 6"SD PVC STORM DRAIN PIPELINE, SIZE AS NOTED ON PLANS. TRENCH AND BACKFILL PER DETAIL [F/SD/X201]
- S=0.0020 FLOWLINE SLOPE AND DIRECTION OF FLOW

DSA File No.: 15-C1
 DSA Application No.: 03-122694
 Agency Approval

GENERAL GRADING AND DRAINAGE NOTES:

1. CONSTRUCTION OF ALL PROJECT SITE IMPROVEMENTS SUBJECT TO ADA ACCESS COMPLIANCE, INCLUDING ACCESSIBLE PATH OF TRAVEL, CURB RETURNS, PARKING STALL(S) AND UNLOADING AREAS, BARRIER FREE AMENITIES AND/OR OTHER APPLICABLE SITE IMPROVEMENTS SHALL CONFORM TO THE AMERICANS WITH DISABILITIES ACT, CALIFORNIA TITLE 24, THE CALIFORNIA BUILDING CODE, CURRENT EDITION(S).
2. CONTRACTOR SHALL FIELD VERIFY ALL GRADES AND SLOPES PRIOR TO THE PLACEMENT OF CONCRETE AND/OR PAVEMENT FOR CONFORMANCE WITH ADA ACCESS COMPLIANCE REQUIREMENTS. EXAMPLES OF MINIMUM AND MAXIMUM LIMITS RELATED TO ADA ACCESS COMPLIANCE INCLUDE, BUT ARE NOT LIMITED TO:
 - a) ACCESSIBLE PATH OF TRAVEL CROSS-SLOPE SHALL NOT EXCEED 2%
 - b) ACCESSIBLE PATH OF TRAVEL LONGITUDINAL SLOPES SHALL NOT EXCEED 5%
 - c) RAMP LONGITUDINAL SLOPES SHALL NOT EXCEED 8.33%
 - d) ACCESSIBLE WALKS SHALL NOT HAVE LESS THAN 48 INCHES IN UNOBSTRUCTED WIDTH
 - e) ACCESSIBLE PARKING SPACES AND ACCESS AISLES SHALL NOT EXCEED 2% SLOPE IN ANY DIRECTION
 - f) LANDINGS AT THE TOP AND BOTTOM OF ACCESSIBLE RAMPS SHALL NOT EXCEED 2% SLOPE IN ANY DIRECTION
 - g) GUTTERS AND ROAD SURFACES DIRECTLY ADJACENT TO AND WITHIN 2 FEET OF A CURB RAMP SHALL HAVE A COUNTER SLOPE NOT TO EXCEED 5%
3. CONTRACTOR MUST IMMEDIATELY NOTIFY THE ENGINEER OF RECORD, IDENTIFIED BY THE PROFESSIONAL ENGINEERING SEAL AND SIGNATURE ON THESE PLANS, OF ANY SITE CONDITIONS AND/OR DESIGN INFORMATION THAT PREVENTS THE CONTRACTOR FROM COMPLYING WITH THE LAWS, REGULATIONS AND/OR BUILDING CODES GOVERNING ADA ACCESS COMPLIANCE.
4. GROUND SLOPES AWAY FROM BUILDING PADS IN LANDSCAPED OR DIRT AREAS SHALL BE NO LESS THAN 3% FOR AT LEAST TEN (10) FEET, OR AS OTHERWISE NOTED ON THE PLANS.
5. DRAINAGE SHALL NOT BE ALLOWED ONTO ADJACENT PROPERTY.
6. ALL FILL MATERIAL USED TO SUPPORT THE FOUNDATIONS OF ANY BUILDING OR STRUCTURE SHALL BE PLACED UNDER THE DIRECTION OF A LICENSED GEOTECHNICAL ENGINEER, AND IN COMPLIANCE WITH THE PROJECT SPECIFICATIONS. A SOILS COMPACTION REPORT SHALL BE SUBMITTED TO THE ENGINEER OF RECORD AS REQUIRED BY THE PROJECT SPECIFICATIONS.
7. THE CONTRACTOR SHALL IMPLEMENT DUST CONTROL MEASURES AS REQUIRED BY THE PROJECT SPECIFICATIONS, AND BY GOVERNING PUBLIC AGENCIES.
8. THE CONTRACTOR SHALL IMPLEMENT A STORM WATER POLLUTION PREVENTION PLAN (SWPPP) AS REQUIRED BY THE PROJECT SPECIFICATIONS AND THE STATE WATER RESOURCES CONTROL BOARD'S CONSTRUCTION GENERAL PERMIT. IMPLEMENT BEST MANAGEMENT PRACTICES WITHIN PUBLIC RIGHT OF WAY PER LOCAL JURISDICTION REQUIREMENTS.
9. AS A FIRST ORDER OF WORK, THE CONTRACTOR SHALL POT-HOLE THE EXISTING UTILITY LINES AT THE POINT OF CONNECTION TO VERIFY THE LOCATION, SIZE, PIPE MATERIAL AND ELEVATION SO THAT THE ENGINEER CAN MAKE ELEVATION AND/OR ALIGNMENT ADJUSTMENTS IF NECESSARY. SHOULD POT-HOLING DISCOVER ANY DISCREPANCIES, CONTACT THE ENGINEER AND OBTAIN WRITTEN DIRECTION BEFORE PROCEEDING.
10. ADJUST UTILITY LIDS WITHIN NEW CONSTRUCTION AREA TO FINISHED GRADE PER DETAIL [D/SD/X201]. REPLACE ALL BROKEN LIDS WITH NEW. PROVIDE TRAFFIC RATED LIDS WITHIN VEHICLE LOADING AREAS.
11. WATER TEST PAVEMENT WITHIN NEW IMPROVEMENT AREA. REPLACE PAVEMENT WHERE BIRD BATHS OCCUR AFTER TEST AS DIRECTED BY THE INSPECTOR OR ENGINEER.
12. MINIMUM SLOPE ON IMPERVIOUS SURFACES PERPENDICULAR TO ADJACENT STRUCTURE(S), WITHIN ADA PATH, SHALL BE 1% MINIMUM AND 2% MAXIMUM. WHERE DOOR AND GATE LANDINGS OCCUR THE CROSS SLOPE SHALL BE 2% MAXIMUM IN ALL DIRECTIONS.

SEE SHEET SD/C501 FOR CONTINUATION

Blair, Church & Flynn
 Consulting Engineers
 461 Clovis Avenue,
 Suite 200
 Clovis, California 93612
 Tel (559) 326-1400
 Fax (559) 326-1500

Professional Engineer Seal: Robert D. Flynn, No. 51218, State of California

Consultant

PORTERVILLE COLLEGE ATHLETIC COMPLEX
 PHASE I
 100 E COLLEGE AVE,
 PORTERVILLE, CA 93257

Project

GRADING PLAN
 Drawing

darden architects
 ARCHITECTURE
 PLANNING
 INTERIORS
 www.dardenarchitects.com
 6790 N. West Ave. • Fresno, CA 93711 • T. 559.448.8051

Licensed Architect Seal: Robert L. Pettinato, No. L11998, State of California

Architect

No.	Revision/Submission	Date
1	ADDENDUM 02	01/11/2024


Revision	
Designed By:	ZH
Copyright:	2024 Darden Architects
Scale:	AS NOTED
Drawn By:	AH
Project Number:	2118
Checked By:	JF
Date:	12/28/2023
Reviewed By:	ZH

SD/C502
AD2-CX07

SCALE 1"=20'

0 5 10 20 SCALE IN FEET

811
 Know what's Below.
 Call before you dig.

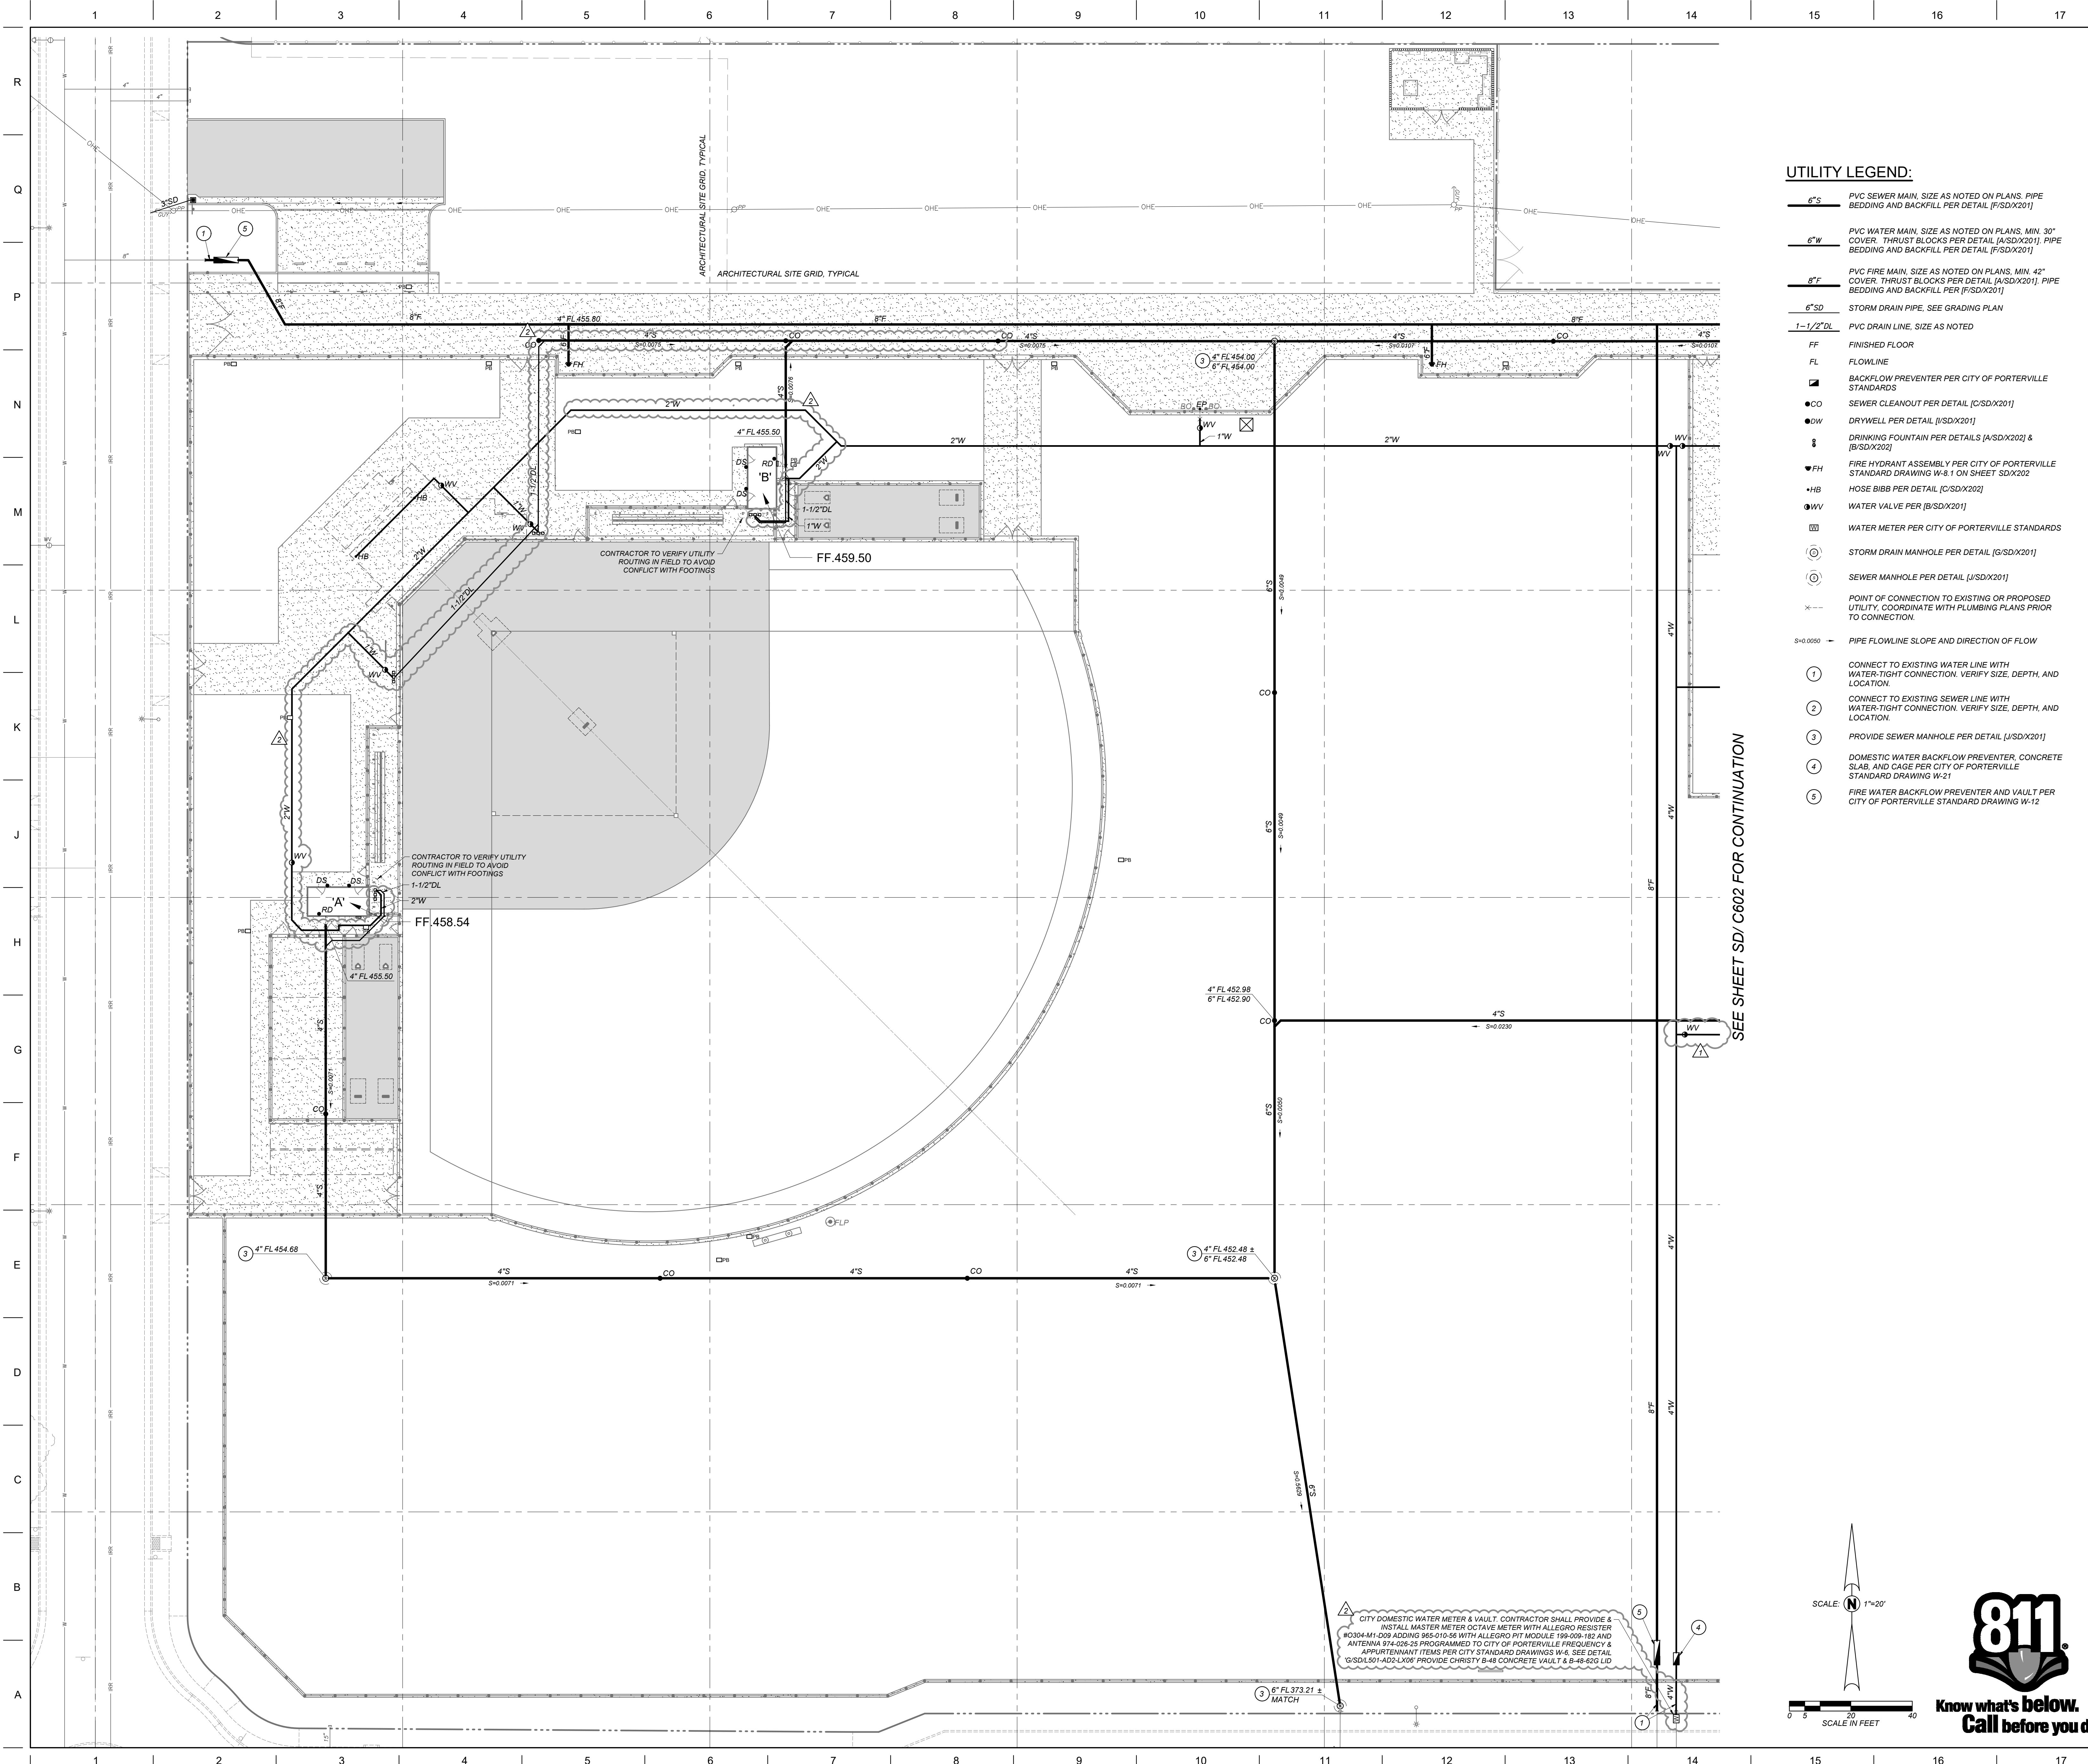

UTILITY LEGEND:

- 8"S PVC SEWER MAIN, SIZE AS NOTED ON PLANS, PIPE BEDDING AND BACKFILL PER DETAIL [F/SDX201]
- 6"W PVC WATER MAIN, SIZE AS NOTED ON PLANS, MIN. 30" COVER, THRUST BLOCKS PER DETAIL [A/SDX201], PIPE BEDDING AND BACKFILL PER DETAIL [F/SDX201]
- 8" F PVC FIRE MAIN, SIZE AS NOTED ON PLANS, MIN. 42" COVER, THRUST BLOCKS PER DETAIL [A/SDX201], PIPE BEDDING AND BACKFILL PER DETAIL [F/SDX201]
- 6" SD STORM DRAIN PIPE, SEE GRADING PLAN
- 1-1/2" DL PVC DRAIN LINE, SIZE AS NOTED
- FF FINISHED FLOOR
- FL FLOWLINE
- CB BACKFLOW PREVENTER PER CITY OF PORTERVILLE STANDARDS
- SC SEWER CLEANOUT PER DETAIL [C/SDX201]
- DW DRYWELL PER DETAIL [I/SDX201]
- DF DRINKING FOUNTAIN PER DETAILS [A/SDX202] & [B/SDX202]
- FH FIRE HYDRANT ASSEMBLY PER CITY OF PORTERVILLE STANDARD DRAWING W-8.1 ON SHEET SDX202
- HB HOSE BIBB PER DETAIL [C/SDX202]
- WV WATER VALVE PER [B/SDX201]
- WM WATER METER PER CITY OF PORTERVILLE STANDARDS
- SM STORM DRAIN MANHOLE PER DETAIL [G/SDX201]
- SEWER MANHOLE PER DETAIL [J/SDX201]
- PC POINT OF CONNECTION TO EXISTING OR PROPOSED UTILITY, COORDINATE WITH PLUMBING PLANS PRIOR TO CONNECTION.
- SLOPE PIPE FLOWLINE SLOPE AND DIRECTION OF FLOW
- 1 CONNECT TO EXISTING WATER LINE WITH WATER-TIGHT CONNECTION. VERIFY SIZE, DEPTH, AND LOCATION.
- 2 CONNECT TO EXISTING SEWER LINE WITH WATER-TIGHT CONNECTION. VERIFY SIZE, DEPTH, AND LOCATION.
- 3 PROVIDE SEWER MANHOLE PER DETAIL [J/SDX201]
- 4 DOMESTIC WATER BACKFLOW PREVENTER, CONCRETE SLAB, AND CAGE PER CITY OF PORTERVILLE STANDARD DRAWING W-21
- 5 FIRE WATER BACKFLOW PREVENTER AND VAULT PER CITY OF PORTERVILLE STANDARD DRAWING W-12

DSA File No.: 15-C1
 DSA Application No.: 03-122694
 Agency Approval

- GENERAL SITE UTILITY NOTES:**
- AS FIRST ORDER OF WORK, CONTRACTOR SHALL POTHOLE EXISTING UTILITIES AND NOTIFY ENGINEER IMMEDIATELY OF LOCATIONS, SIZE AND DEPTH.
 - THE CONTRACTOR SHALL FIELD VERIFY THE EXACT LOCATION, SIZE, DEPTH, AND TYPE OF ALL EXISTING UTILITIES AND INTERFERENCES SITUATED ALONG THE ROUTE OF THE PROPOSED CONSTRUCTION PRIOR TO COMMENCEMENT OF EXCAVATION, FABRICATION, AND INSTALLATION. THE CONTRACTOR SHALL CONSTRUCT ALL IMPROVEMENTS IN SUCH A MANNER AS WILL PROTECT ALL EXISTING UNDERGROUND UTILITIES AND, IN THE EVENT OF ANY CONFLICTS, SHALL NOTIFY THE ENGINEER BEFORE PROCEEDING.
 - SEE IRRIGATION PLANS FOR PROPOSED IRRIGATION PIPE ALIGNMENT.
 - COORDINATE EXACT POINTS OF CONNECTION TO BUILDING PLUMBING AND NOTIFY THE ENGINEER OF ANY CONFLICT SO THAT ADJUSTMENTS CAN BE MADE IF NEEDED.
 - SAWCUT EXISTING CONCRETE IMPROVEMENTS AS NECESSARY TO INSTALL NEW WATER OR SEWER IMPROVEMENTS. CONSTRUCT NEW CONCRETE IMPROVEMENTS TO MATCH ADJACENT CONCRETE IMPROVEMENTS.
 - INSTALLATION, TYPE, AND MANUFACTURER'S MODELS OF DOMESTIC WATER METERS, DRAIN INLETS/OUTLETS AND OTHER APPURTENANCES OF SITE UTILITY SYSTEMS SHALL BE DONE IN STRICT ACCORDANCE WITH GOVERNING AUTHORITY REQUIREMENTS.
 - LAYOUT OF MATERIALS, EQUIPMENT AND SYSTEMS IS GENERALLY DIAGRAMMATIC UNLESS SPECIFICALLY DIMENSIONED. SOME WORK MAY BE SHOWN OFFSET FOR CLARITY. THE ACTUAL LOCATIONS OF ALL MATERIALS, PIPING, FIXTURES, EQUIPMENT, SUPPORTS, ETC., SHALL BE CAREFULLY PLANNED PRIOR TO INSTALLATION OF ANY WORK TO AVOID ALL INTERFERENCES WITH EACH OTHER OR WITH STRUCTURAL, ELECTRICAL, PLUMBING AND MECHANICAL, ARCHITECTURAL OR ANY OTHER ELEMENTS. ALL CONFLICTS SHALL BE CALLED TO THE ATTENTION OF THE ARCHITECT AND THE ENGINEER PRIOR TO THE INSTALLATION OF ANY WORK OR THE ORDERING OF ANY EQUIPMENT.
 - ANY INSPECTION TO BE MADE BY THE AUTHORITY HAVING JURISDICTION SHALL REQUIRE A MINIMUM OF 24 HOURS NOTICE.
 - PURITY TESTS ARE REQUIRED ON ALL WATER SYSTEM INSTALLATIONS. CONTRACTOR TO COORDINATE WITH THE AUTHORITY HAVING JURISDICTION.
 - IF THE TOP OF THE STEM OF ANY WATER GATE VALVE IS DEEPER THAN 4' BELOW FINISHED PAVEMENT GRADE, THE CONTRACTOR SHALL INSTALL A STEM EXTENSION SO THAT THE TOP OF THE STEM, WITH EXTENSION, SHALL BE NO DEEPER THAN 4' NOR SHALLOWER THAN 2' FROM FINISHED GRADE.
 - BACKFILL UTILITY TRENCHES PER DETAIL [F/SDX201]
 - ADJUST EXISTING UTILITY LIDS TO FINISHED GRADE PER UTILITY COMPANY STANDARDS AND DETAIL [D/SDX201] AND INSTALL TRAFFIC RATED LIDS WHERE LOCATED IN A TRAFFIC AREA.

General Notes

Blair, Church & Flynn Consulting Engineers
 461 Clovis Avenue, Suite 200
 Clovis, California 93212
 Tel (559) 326-1400 Fax (559) 326-1500

Consultant

PORTERVILLE COLLEGE ATHLETIC COMPLEX
 PHASE I
 100 E COLLEGE AVE,
 PORTERVILLE, CA 93257

Project

UTILITY PLAN

Drawing

arden architects
 ARCHITECTURE PLANNING INTERIORS
 www.ardenarchitects.com
 6790 N. West Ave. • Fresno, CA 93711 • T. 559.448.8051

Architect

No.	Revision/Submission	Date
1	ADDENDUM 02	01/11/2024


Revision		
Designed By:	ZH	Copyright 2024 Darden Architects
Scale:	AS NOTED	Drawn By: AH
Project Number:	2118	Checked By: JF
Date:	12/28/2023	Reviewed By: ZH

SD/C601
AD2-CX08

SCALE: 1"=20'

SCALE IN FEET

811
 Know what's below.
 Call before you dig.

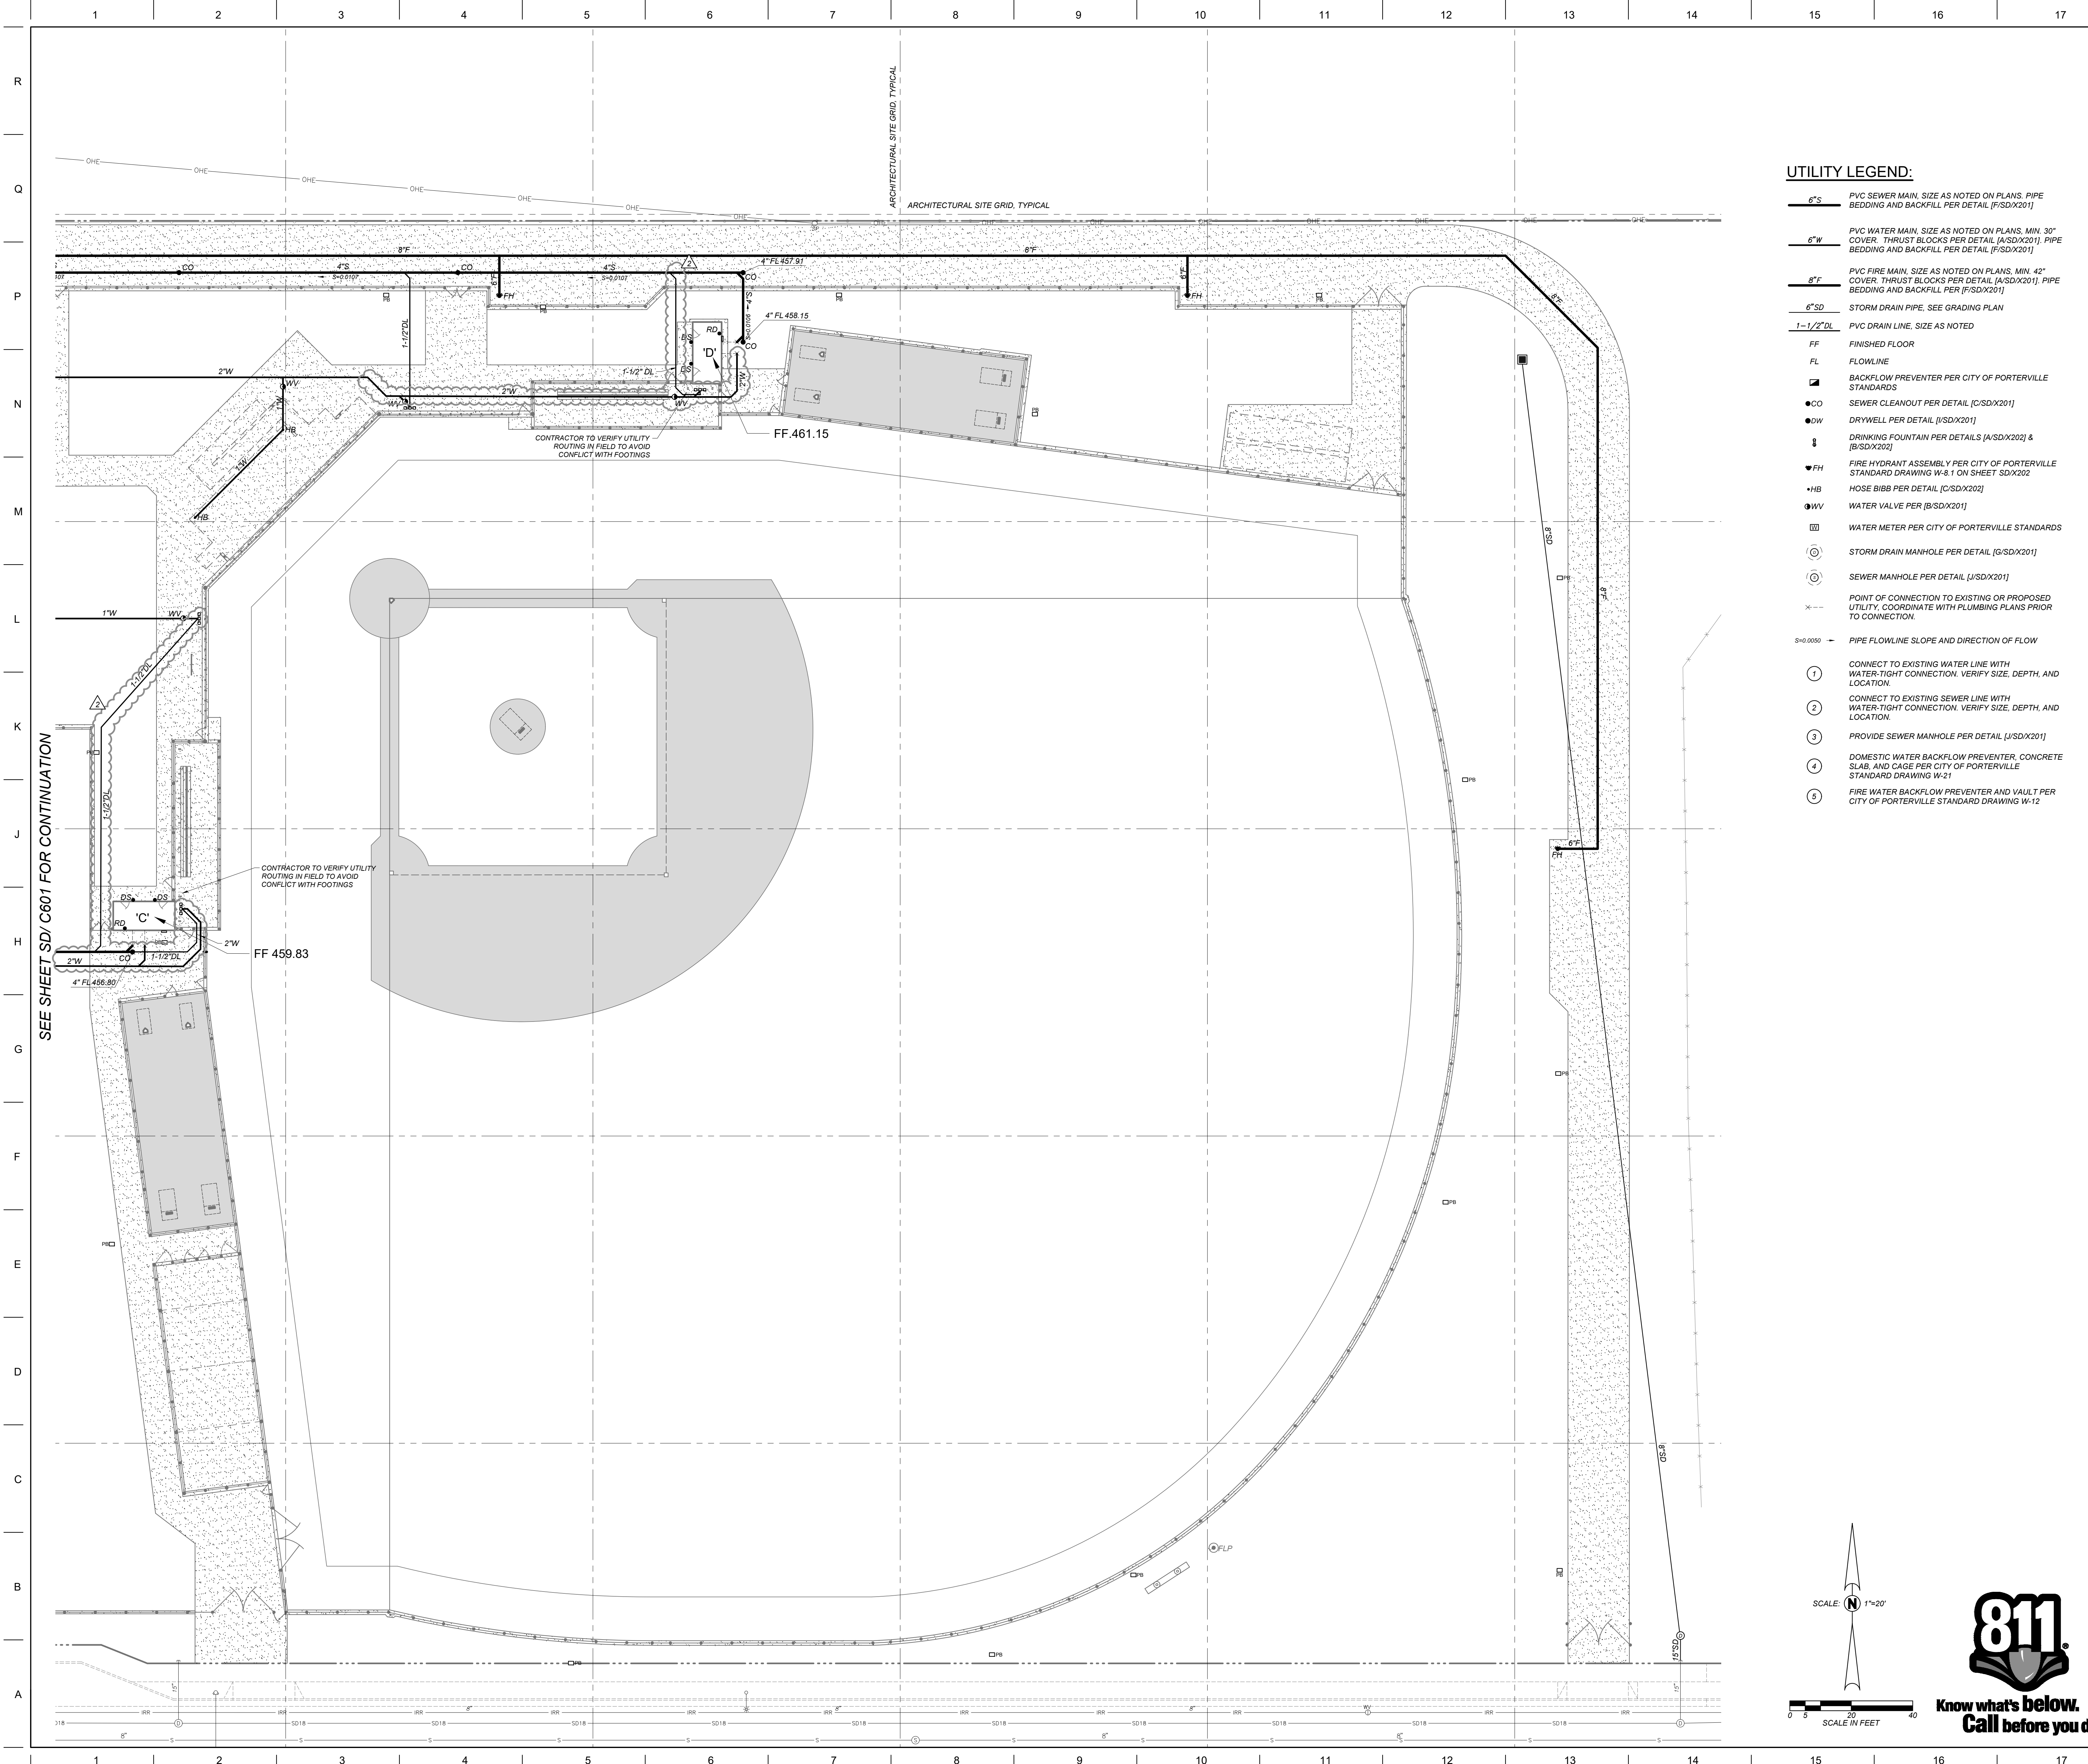

UTILITY LEGEND:

- 6" S PVC SEWER MAIN, SIZE AS NOTED ON PLANS. PIPE BEDDING AND BACKFILL PER DETAIL [F/SDX201]
- 6" W PVC WATER MAIN, SIZE AS NOTED ON PLANS. MIN. 30" COVER. THRUST BLOCKS PER DETAIL [A/SDX201]. PIPE BEDDING AND BACKFILL PER DETAIL [F/SDX201]
- 6" F PVC FIRE MAIN, SIZE AS NOTED ON PLANS. MIN. 42" COVER. THRUST BLOCKS PER DETAIL [A/SDX201]. PIPE BEDDING AND BACKFILL PER DETAIL [F/SDX201]
- 6" SD STORM DRAIN PIPE, SEE GRADING PLAN
- 1-1/2" DL PVC DRAIN LINE, SIZE AS NOTED
- FF FINISHED FLOOR
- FL FLOWLINE
- CB BACKFLOW PREVENTER PER CITY OF PORTERVILLE STANDARDS
- CO SEWER CLEANOUT PER DETAIL [C/SDX201]
- DW DRYWELL PER DETAIL [J/SDX201]
- DF DRINKING FOUNTAIN PER DETAILS [A/SDX202] & [B/SDX202]
- FH FIRE HYDRANT ASSEMBLY PER CITY OF PORTERVILLE STANDARD DRAWING W-8.1 ON SHEET SDX202
- HB HOSE BIBB PER DETAIL [C/SDX202]
- WV WATER VALVE PER [B/SDX201]
- WM WATER METER PER CITY OF PORTERVILLE STANDARDS
- SM STORM DRAIN MANHOLE PER DETAIL [G/SDX201]
- SH SEWER MANHOLE PER DETAIL [J/SDX201]
- PC POINT OF CONNECTION TO EXISTING OR PROPOSED UTILITY, COORDINATE WITH PLUMBING PLANS PRIOR TO CONNECTION.
- S=0.0050 PIPE FLOWLINE SLOPE AND DIRECTION OF FLOW
- 1 CONNECT TO EXISTING WATER LINE WITH WATER-TIGHT CONNECTION. VERIFY SIZE, DEPTH, AND LOCATION.
- 2 CONNECT TO EXISTING SEWER LINE WITH WATER-TIGHT CONNECTION. VERIFY SIZE, DEPTH, AND LOCATION.
- 3 PROVIDE SEWER MANHOLE PER DETAIL [J/SDX201]
- 4 DOMESTIC WATER BACKFLOW PREVENTER, CONCRETE SLAB, AND CAGE PER CITY OF PORTERVILLE STANDARD DRAWING W-21
- 5 FIRE WATER BACKFLOW PREVENTER AND VAULT PER CITY OF PORTERVILLE STANDARD DRAWING W-12

DSA File No.: 15-C1
 DSA Application No.: 03-122694
 Agency Approval

- GENERAL SITE UTILITY NOTES:**
- AS FIRST ORDER OF WORK, CONTRACTOR SHALL POTHOLE EXISTING UTILITIES AND NOTIFY ENGINEER IMMEDIATELY OF LOCATIONS, SIZE AND DEPTH.
 - THE CONTRACTOR SHALL FIELD VERIFY THE EXACT LOCATION, SIZE, DEPTH, AND TYPE OF ALL EXISTING UTILITIES AND INTERFERENCES SITUATED ALONG THE ROUTE OF THE PROPOSED CONSTRUCTION PRIOR TO COMMENCEMENT OF EXCAVATION, FABRICATION, AND INSTALLATION. THE CONTRACTOR SHALL CONSTRUCT ALL IMPROVEMENTS IN SUCH A MANNER AS WILL PROTECT ALL EXISTING UNDERGROUND UTILITIES AND, IN THE EVENT OF ANY CONFLICTS, SHALL NOTIFY THE ENGINEER BEFORE PROCEEDING.
 - SEE IRRIGATION PLANS FOR PROPOSED IRRIGATION PIPE ALIGNMENT.
 - COORDINATE EXACT POINTS OF CONNECTION TO BUILDING PLUMBING AND NOTIFY THE ENGINEER OF ANY CONFLICT SO THAT ADJUSTMENTS CAN BE MADE IF NEEDED.
 - SAW/CUT EXISTING CONCRETE IMPROVEMENTS AS NECESSARY TO INSTALL NEW WATER OR SEWER IMPROVEMENTS. CONSTRUCT NEW CONCRETE IMPROVEMENTS TO MATCH ADJACENT CONCRETE IMPROVEMENTS.
 - INSTALLATION, TYPE, AND MANUFACTURER'S MODELS OF DOMESTIC WATER METERS, DRAIN INLETS/OUTLETS AND OTHER APPURTENANCES OF SITE UTILITY SYSTEMS SHALL BE DONE IN STRICT ACCORDANCE WITH GOVERNING AUTHORITY REQUIREMENTS.
 - LAYOUT OF MATERIALS, EQUIPMENT AND SYSTEMS IS GENERALLY DIAGRAMMATIC UNLESS SPECIFICALLY DIMENSIONED. SOME WORK MAY BE SHOWN OFF-SET FOR CLARITY. THE ACTUAL LOCATIONS OF ALL MATERIALS, PIPING, FIXTURES, EQUIPMENT, SUPPORTS, ETC., SHALL BE CAREFULLY PLANNED PRIOR TO INSTALLATION OF ANY WORK TO AVOID ALL INTERFERENCES WITH EACH OTHER OR WITH STRUCTURAL, ELECTRICAL, PLUMBING AND MECHANICAL, ARCHITECTURAL OR ANY OTHER ELEMENTS. ALL CONFLICTS SHALL BE CALLED TO THE ATTENTION OF THE ARCHITECT AND THE ENGINEER PRIOR TO THE INSTALLATION OF ANY WORK OR THE ORDERING OF ANY EQUIPMENT.
 - ANY INSPECTION TO BE MADE BY THE AUTHORITY HAVING JURISDICTION SHALL REQUIRE A MINIMUM OF 24 HOUR NOTICE.
 - PURITY TESTS ARE REQUIRED ON ALL WATER SYSTEM INSTALLATIONS. CONTRACTOR TO COORDINATE WITH THE AUTHORITY HAVING JURISDICTION.
 - IF THE TOP OF THE STEM OF ANY WATER GATE VALVE IS DEEPER THAN 4' BELOW FINISHED PAVEMENT GRADE, THE CONTRACTOR SHALL INSTALL A STEM EXTENSION SO THAT THE TOP OF THE STEM, WITH EXTENSION, SHALL BE NO DEEPER THAN 4' NOR SHALLOWER THAN 2' FROM FINISHED GRADE.
 - BACKFILL UTILITY TRENCHES PER DETAIL [F/SDX201]
 - ADJUST EXISTING UTILITY LIDS TO FINISHED GRADE PER UTILITY COMPANY STANDARDS AND DETAIL [D/SDX201] AND INSTALL TRAFFIC RATED LIDS WHERE LOCATED IN A TRAFFIC AREA.

SEE SHEET SD/C601 FOR CONTINUATION

Blair, Church & Flynn
 Consulting Engineers
 451 Clovis Avenue,
 Suite 200
 Clovis, California 93612
 Tel (559) 326-1400 Fax (559) 326-1500

Professional Engineer Seal: Robert D. Blair, No. 51218, State of California, Civil.

Consultant

PORTERVILLE COLLEGE ATHLETIC COMPLEX
 PHASE I
 100 E COLLEGE AVE,
 PORTERVILLE, CA 93257

Project

UTILITY PLAN


Drawing

darden architects
 ARCHITECTURE
 PLANNING
 INTERIORS
 www.dardenarchitects.com
 6790 N. West Ave. • Fresno, CA 93711 • T. 559.448.8051

Architect Seal: Robert L. Pettiford, No. L11998, State of California, Architect.

No.	Revision/Submission	Date
1	ADDENDUM 02	01/11/2024

Revision	
Designed By: ZH	Copyright 2024 Darden Architects
Scale: AS NOTED	Drawn By: AH
Project Number: 2118	Checked By: JF
Date: 12/28/2023	Reviewed By: ZH

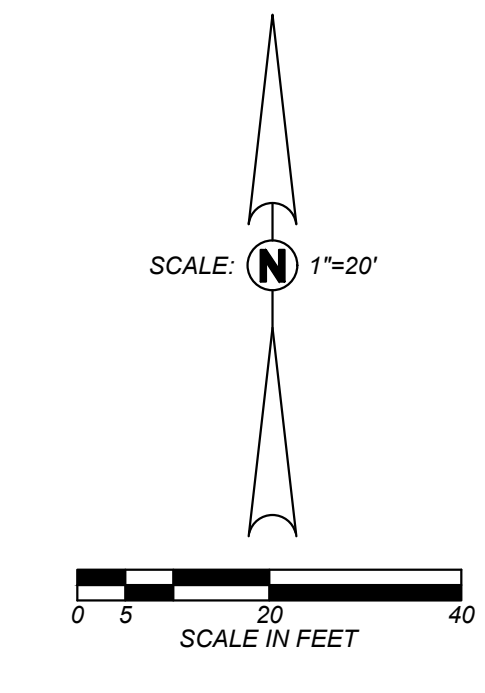


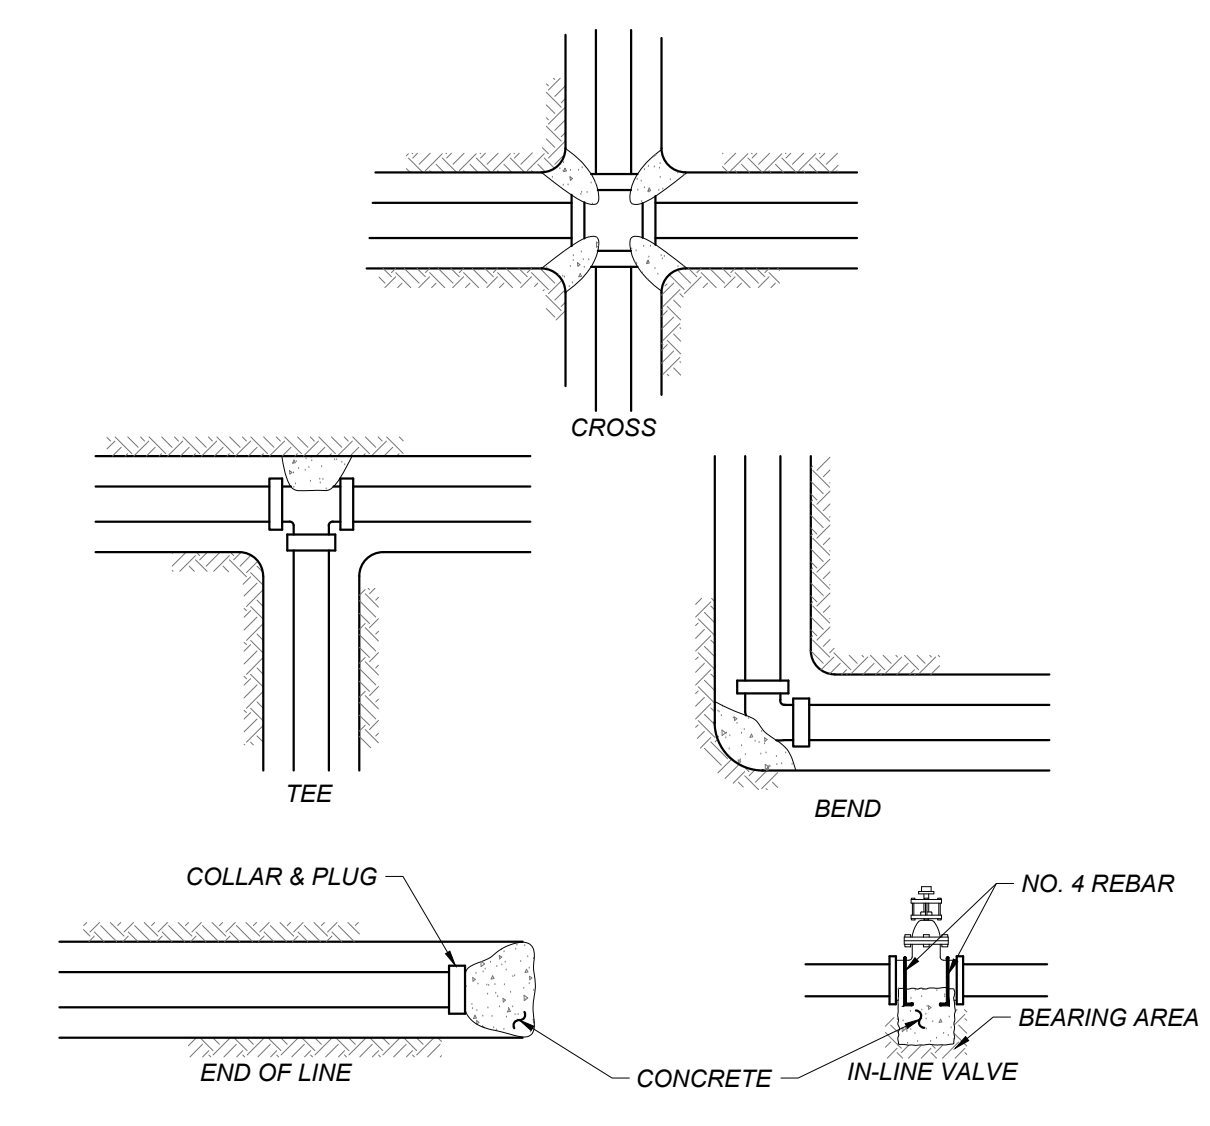


Table of Bearing Areas Required (In Square Feet)*


Pipe Diameter	4" Or Smaller	6"	8"	10"	12"
Cross, Tee, 90° Bend, Plug, Hydrant, Valve	6.3	13.2	22.7	34.2	48.3
45° Bend	3.4	7.1	12.3	18.5	26.1
22 1/2° Bend	1.7	3.6	6.1	9.4	13.3
11 1/4° Bend	0.9	1.8	3.1	4.7	6.7

* TABLE CALCULATED BASED ON NFPA 24, CURRENT EDITION TABLE A.10.8.2(b), WITH 250 PSI WATER PRESSURE AND 1500 PSF SOIL BEARING PRESSURE.


A CONCRETE THRUST BLOCKS
 SD/X201 NOT TO SCALE

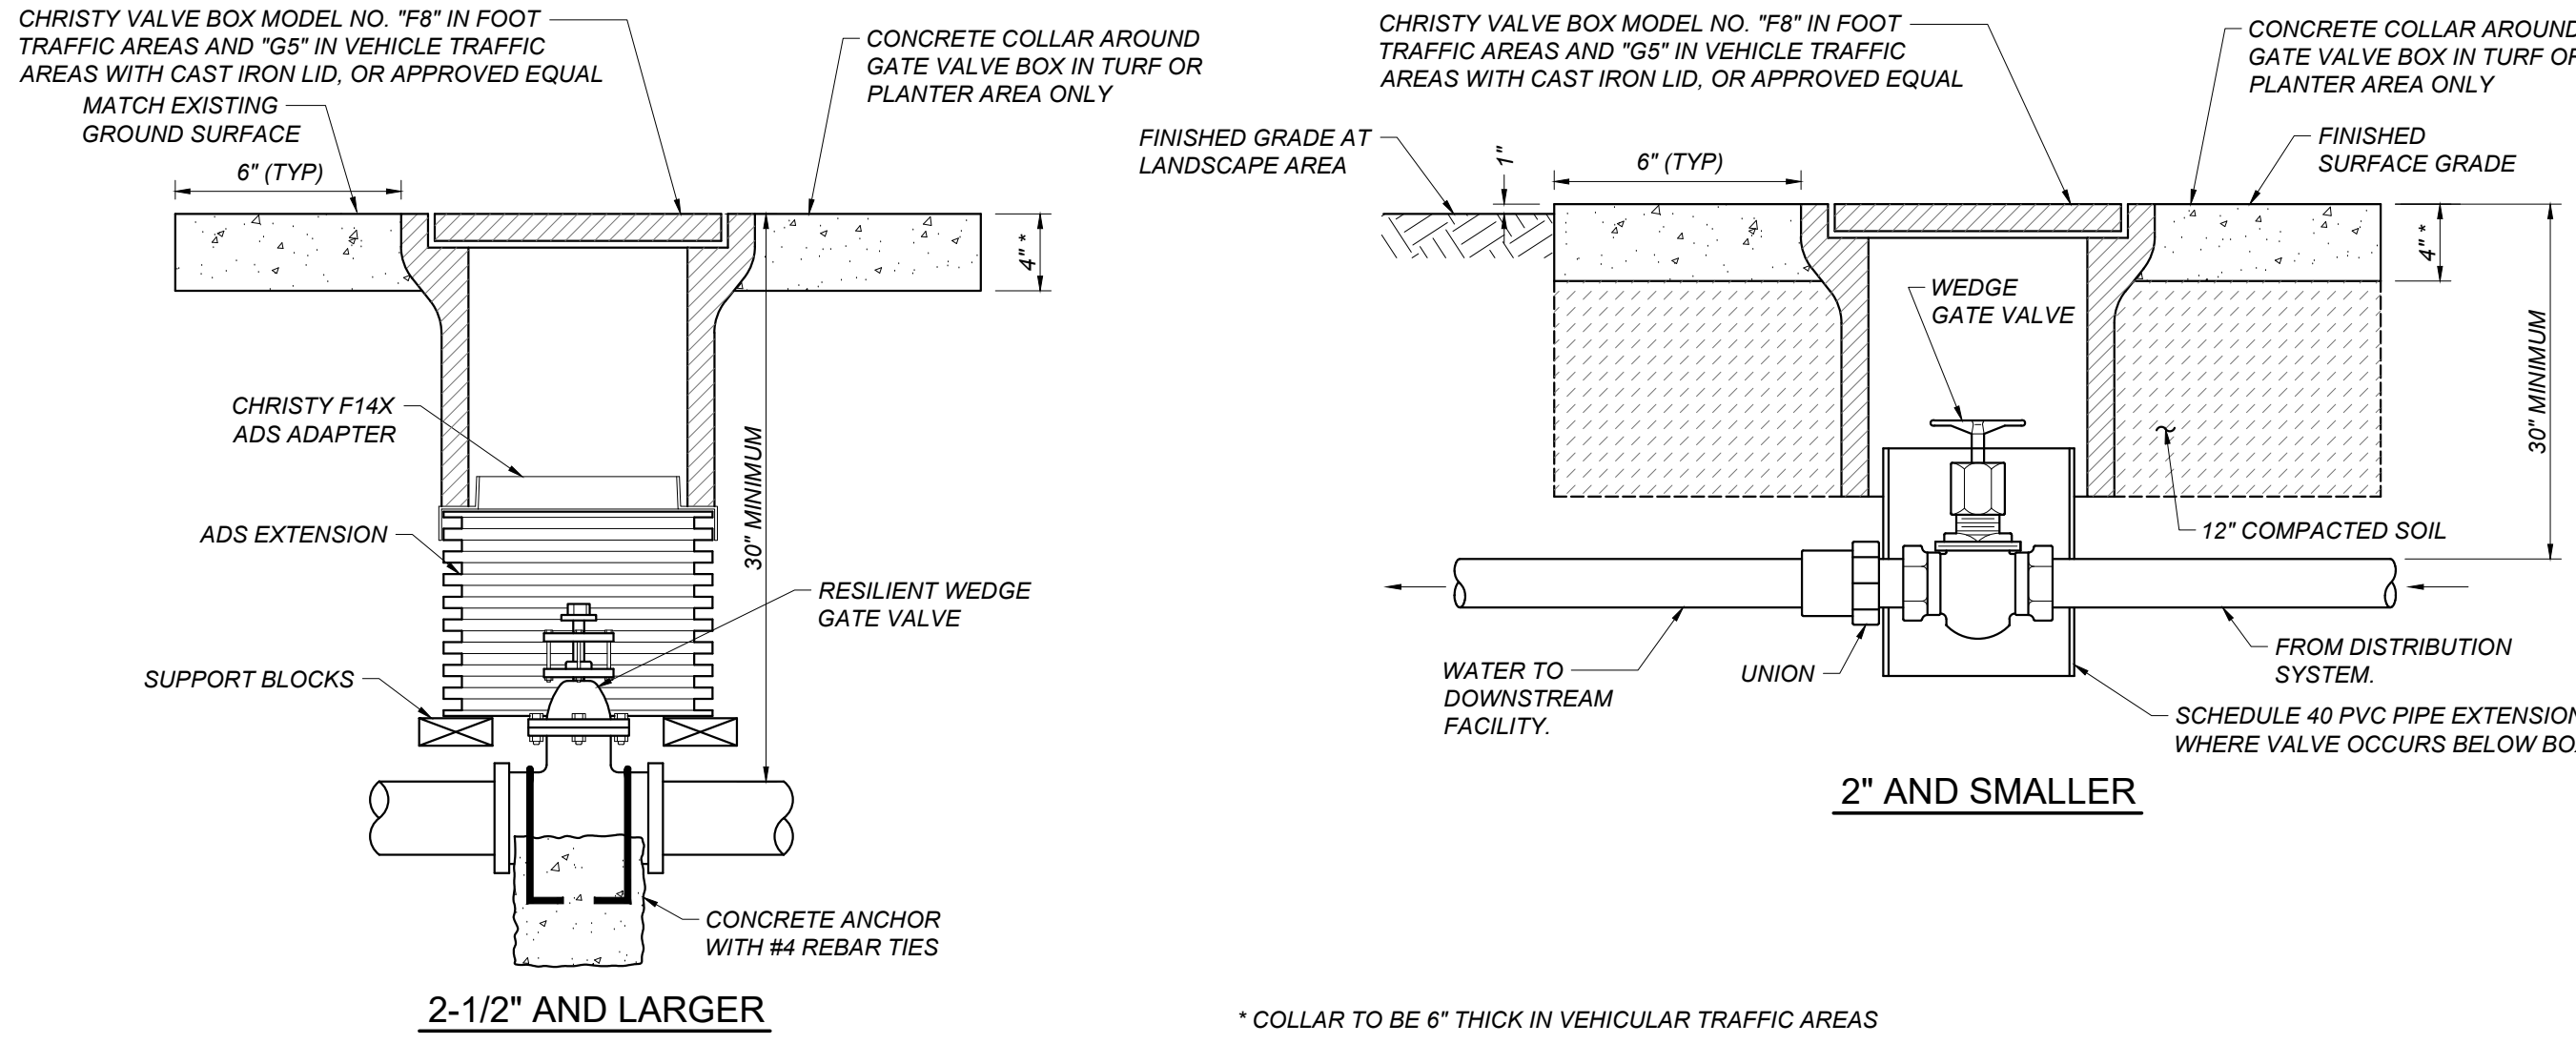


B GATE VALVE AND LID
 SD/X201 NOT TO SCALE

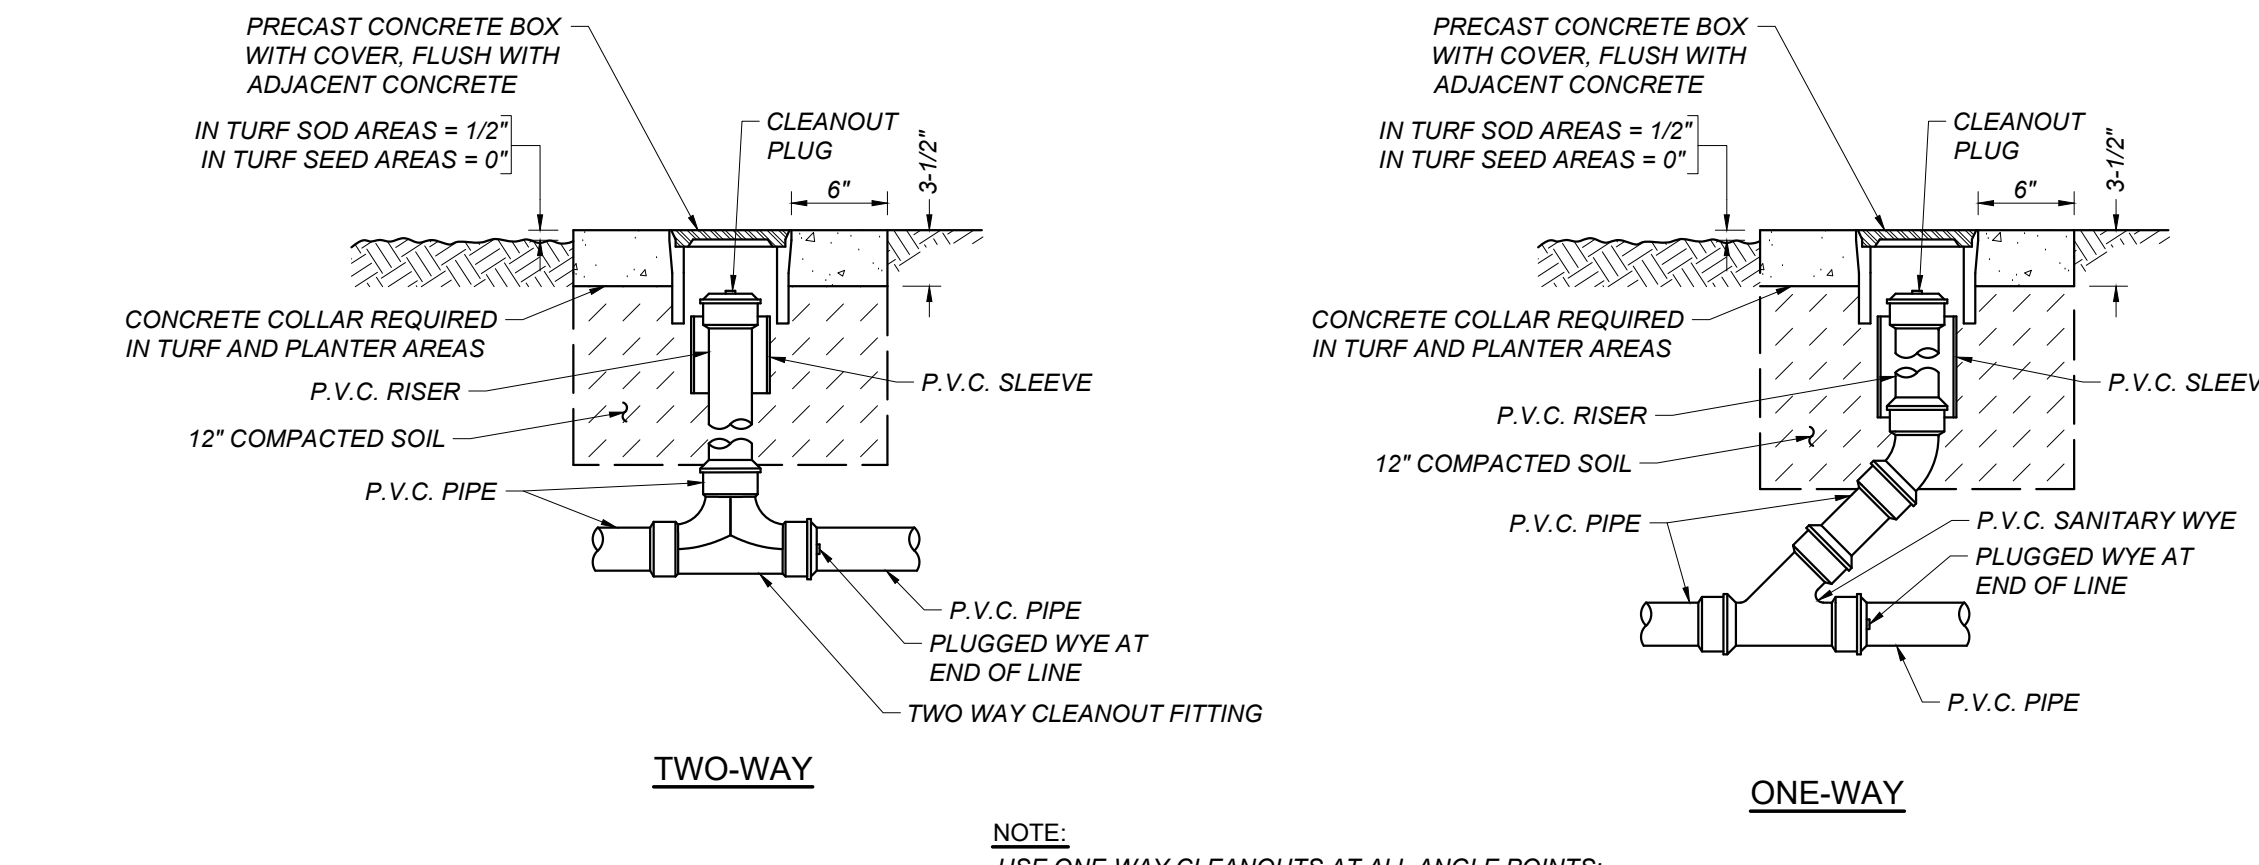


C SURFACE CLEANOUT
 SD/X201 NOT TO SCALE

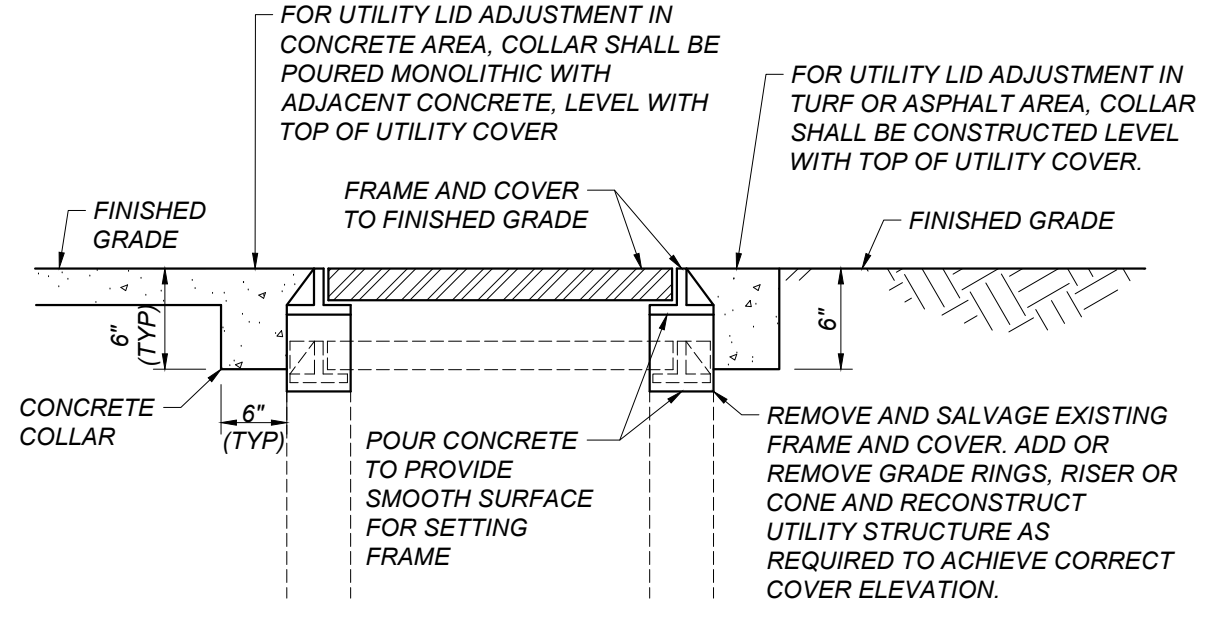

D ADJUST UTILITY LID
 SD/X201 NOT TO SCALE

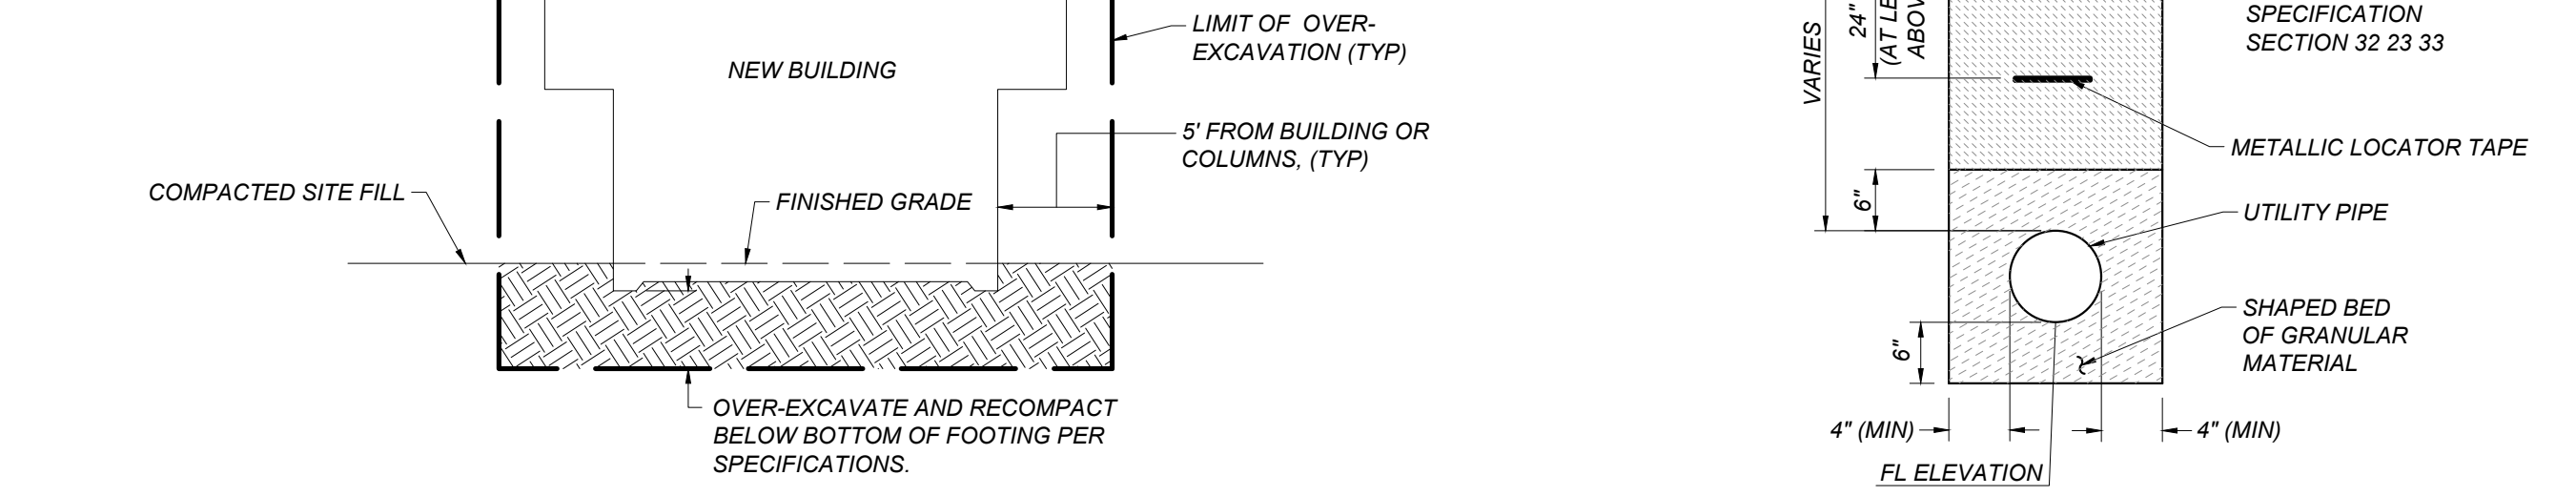

E OVEREXCAVATION AT TICKET BOOTHS
 SD/X201 NOT TO SCALE

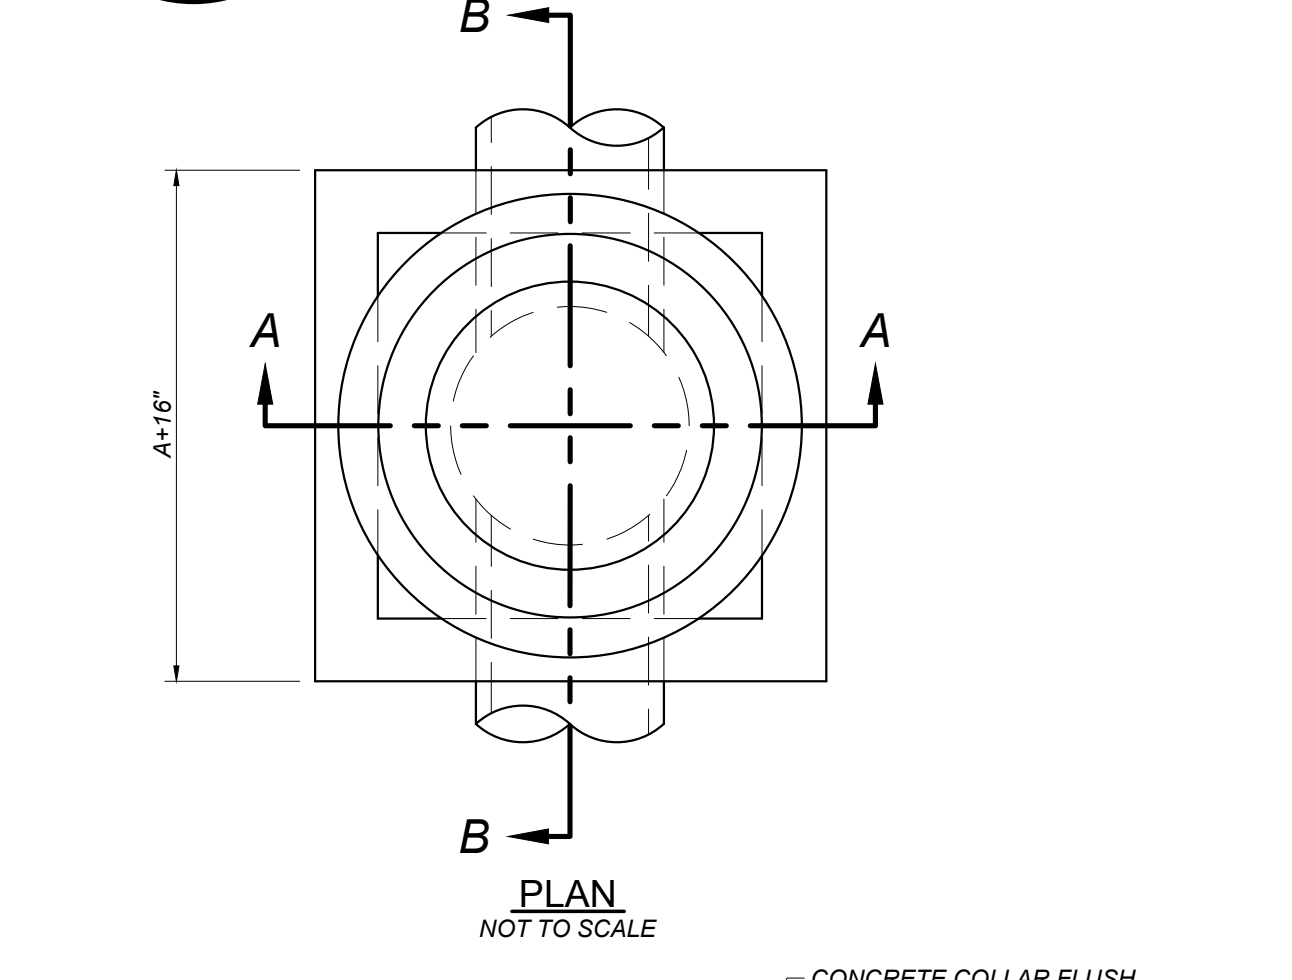


F TRENCH DETAIL FOR UTILITY LINES
 SD/X201 NOT TO SCALE


- NOTES:**
1. PRECAST PIPE, ADJUSTING RINGS AND TAPERED SECTIONS SHALL BE CONSTRUCTED IN ACCORDANCE WITH A.S.T.M. C-478, USING TYPE II CEMENT.
 2. ALL JOINTS BETWEEN PRECAST SECTIONS SHALL BE MORTARED.
 3. INTERIOR OF THE MANHOLE SHALL HAVE A SMOOTH TROWELED SURFACE, (WOOD TROWEL).
 4. IF THE DISTANCE BETWEEN THE FLOW LINE OF THE MANHOLE AND THE FINISH GRADE OF THE LID IS GREATER THAN OR EQUAL TO 12 FEET, THE MANHOLE IS TO BE CONSTRUCTED WITH STEPS.

DETAIL NOT USED

DETAIL NOT USED

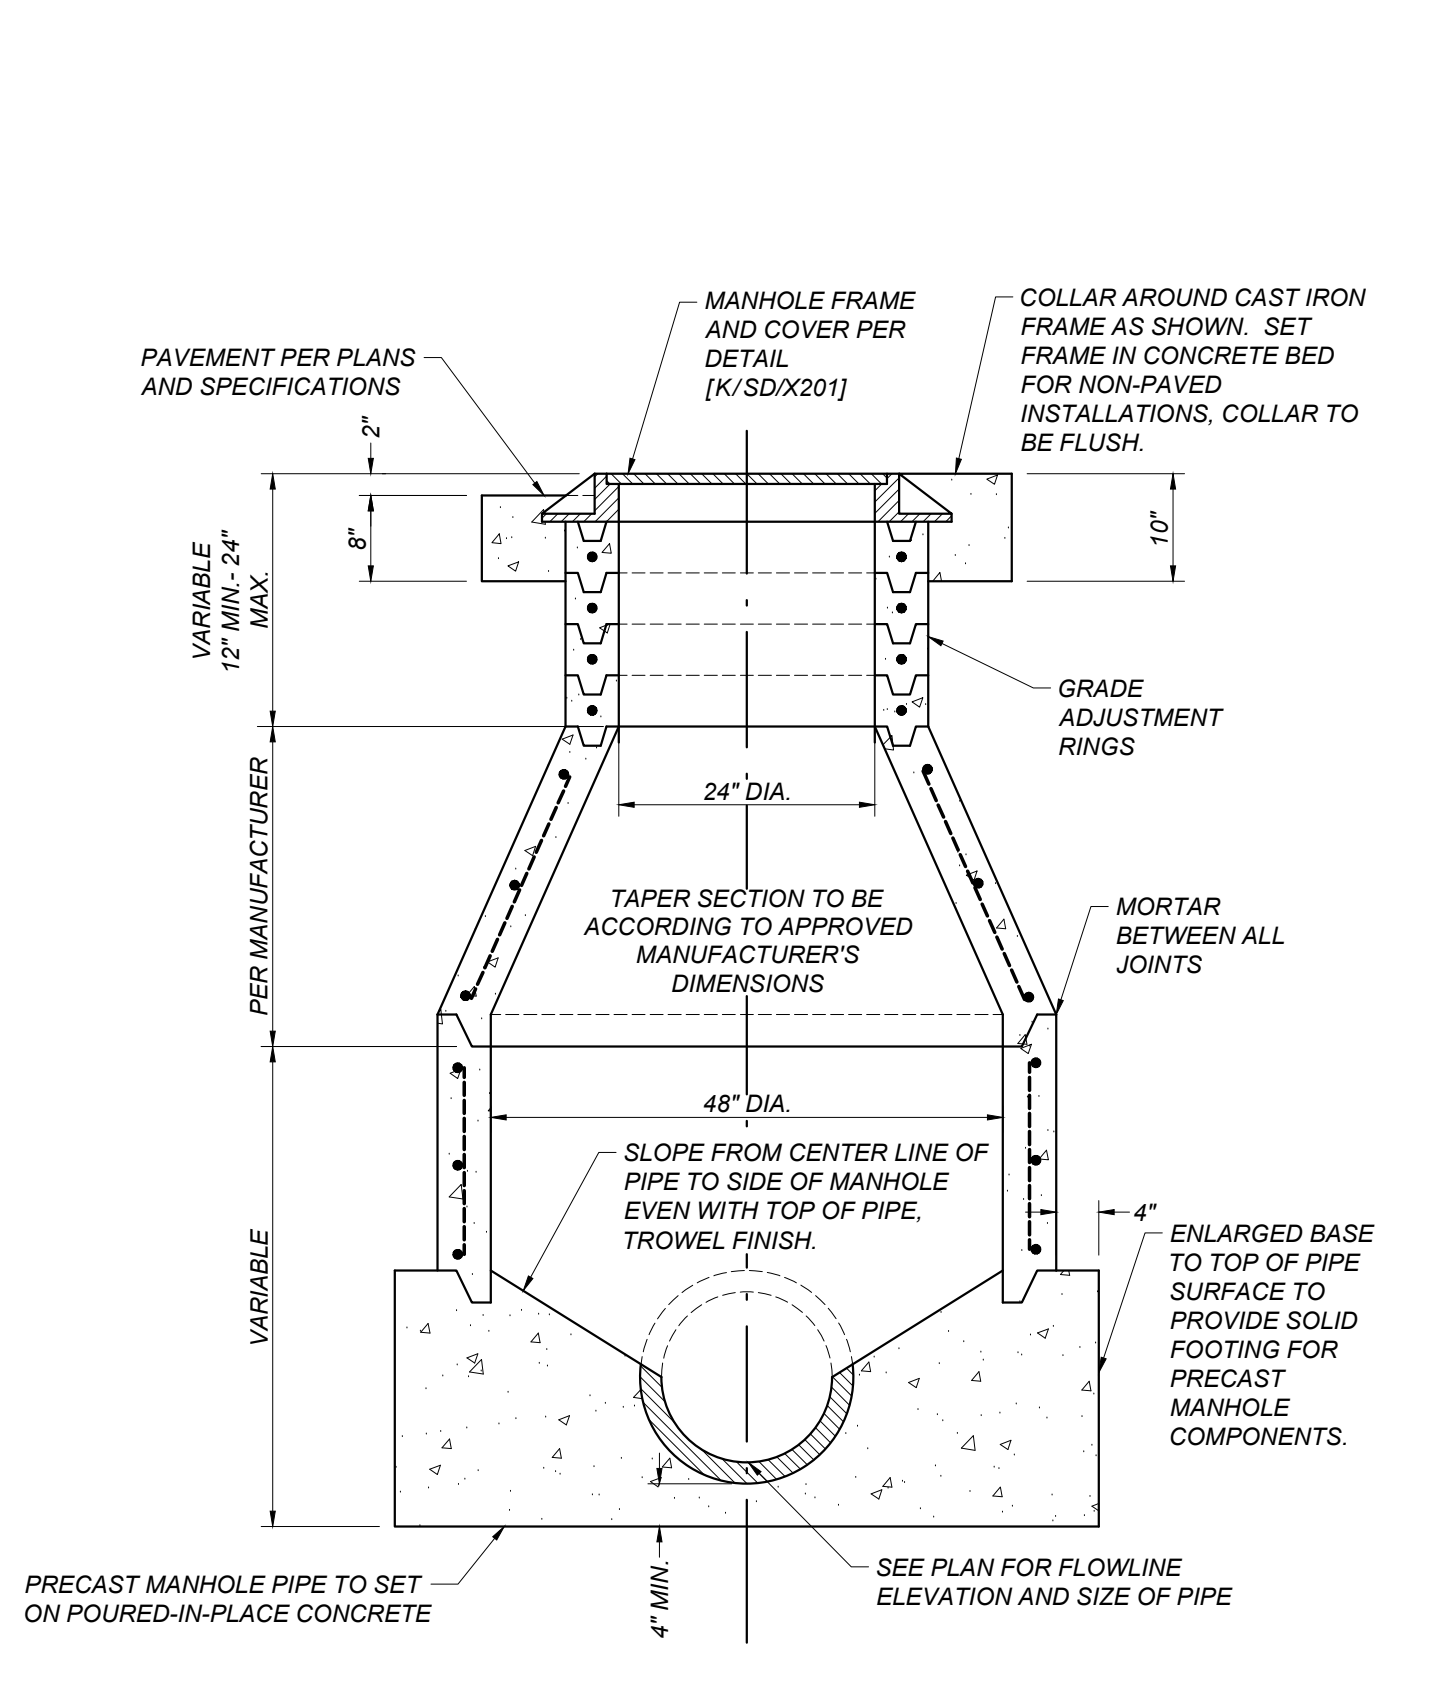

G STORM DRAIN MANHOLE
 SD/X201 NOT TO SCALE

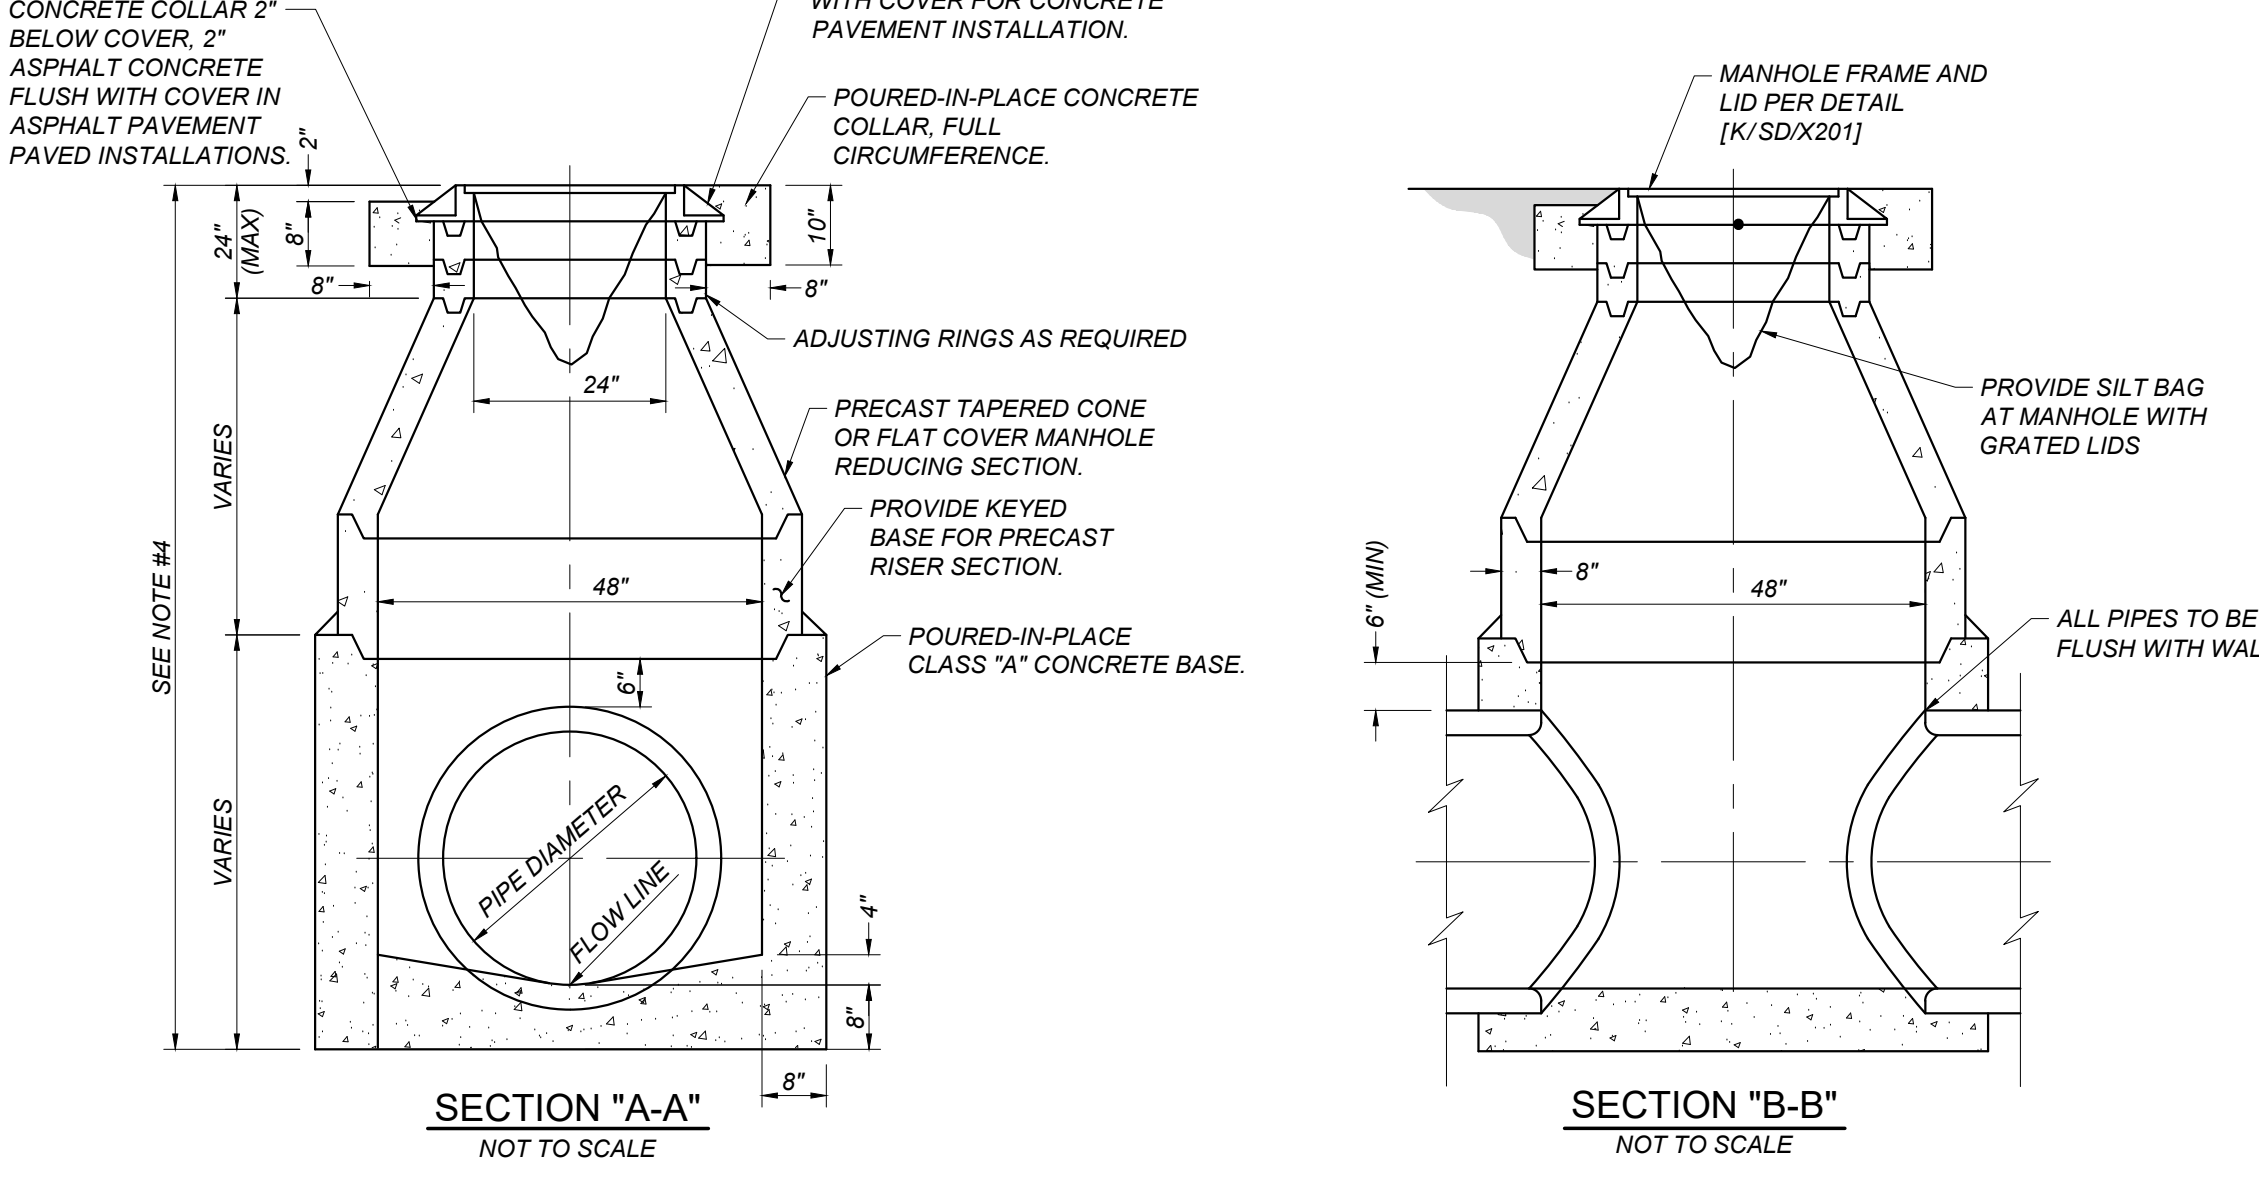


K MANHOLE FRAME AND LID
 SD/X201 NOT TO SCALE

H BOTTLE FILLING STATION
 SD/X201 NOT TO SCALE

I DRY WELL
 SD/X201 NOT TO SCALE

J SANITARY SEWER MANHOLE
 SD/X201 NOT TO SCALE

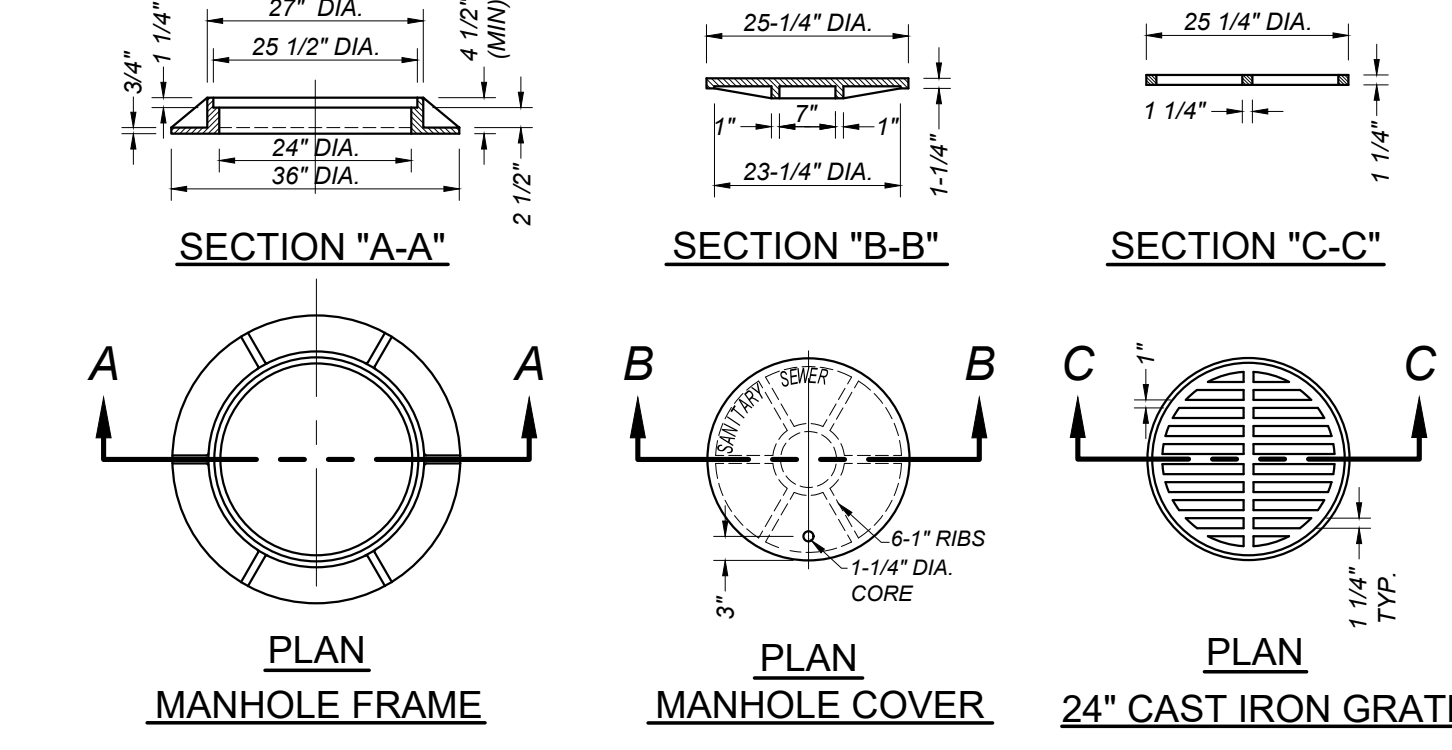

K MANHOLE COVER
 SD/X201 NOT TO SCALE

- NOTES:**
1. ALL DIMENSIONS ARE FINISHED DIMENSIONS.
 2. MATERIAL SHALL BE CAST IRON.
 3. FRAME AND COVER TO BE CONSTRUCTED IN ACCORDANCE WITH A.S.T.M. DESIGNATION A48, CLASS 25.
 4. MANHOLE COVER DESIGN, AS A MINIMUM, IS TO HAVE THE WORDS "STORM SEWER" OR "STORM DRAIN" MOLDED INTO THE COVER, AS APPROPRIATE.
 5. GRATE OPENINGS SHALL BE 1/2" MAXIMUM WHERE LOCATED WITHIN THE PEDESTRIAN PATH OF TRAVEL.
 6. INSTALL SLOTTED GRATE SO SLOTS ARE PARALLEL WITH THE DIRECTION OF SURFACE DRAINAGE FLOW.

General Notes

Blair, Church & Flynn
 Consulting Engineers
 451 Clovis Avenue, Suite 200
 Clovis, California 93612
 Tel (559) 326-1400 Fax (559) 326-1500

Professional Engineer Seal: Robert D. Flynn, No. 57218, State of California, Civil.

Consultant

PORTERVILLE COLLEGE ATHLETIC COMPLEX
 PHASE I
 100 E COLLEGE AVE.
 PORTERVILLE, CA 93257

Project

UTILITY DETAILS

Drawing

darden architects
 ARCHITECTURE PLANNING INTERIORS
 www.dardenarchitects.com
 6790 N. West Ave. • Fresno, CA 93711 • T. 559-448-8051

Licensed Architect Seal: Robert L. Peterson, No. L15986, State of California, Architect.


No.	Revision/Submission	Date
Δ	ADDENDUM 02	01/11/2024

Revision

Designed By: ZH	Copyright 2024 Darden Architects
Scale: AS NOTED	Drawn By: AH
Project Number: 2118	Checked By: JF
Date: 12/28/2023	Reviewed By: ZH


SD/X201
AD2-CX10

DETAIL NOT USED

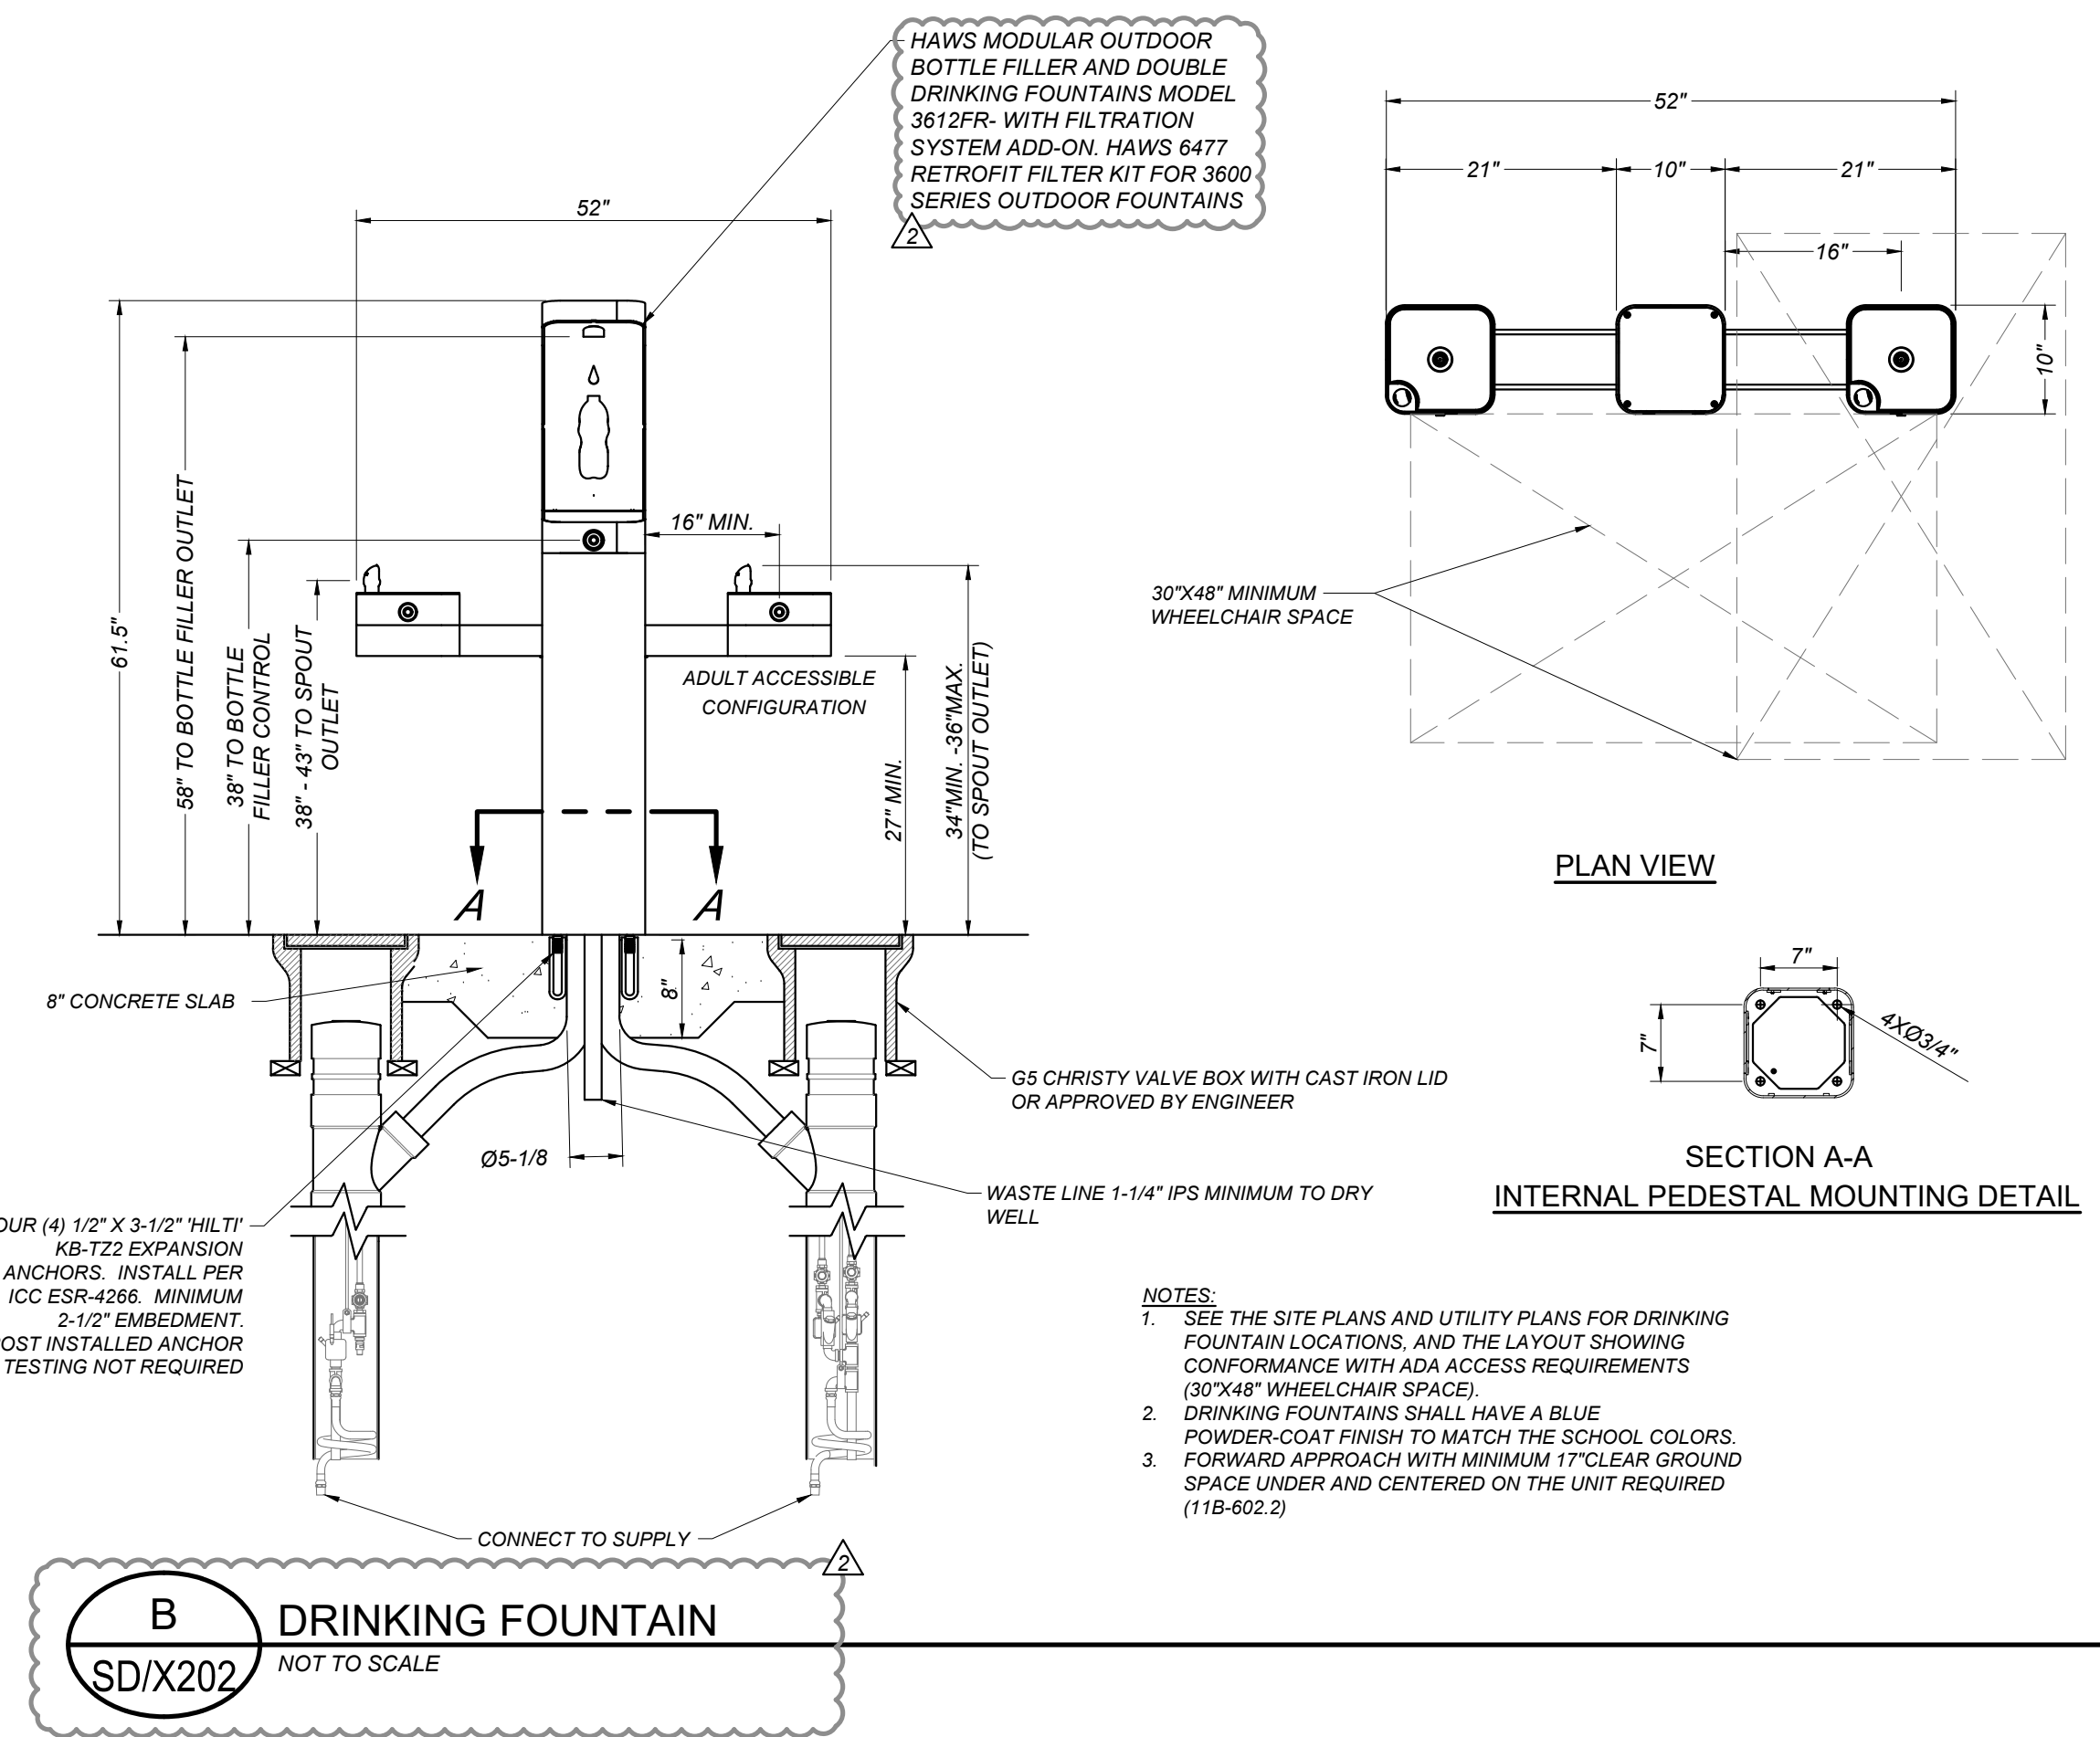

A DRINKING FOUNTAIN (AT DUGOUT AREA)
SD/X202 NOT TO SCALE

B DRINKING FOUNTAIN
SD/X202 NOT TO SCALE

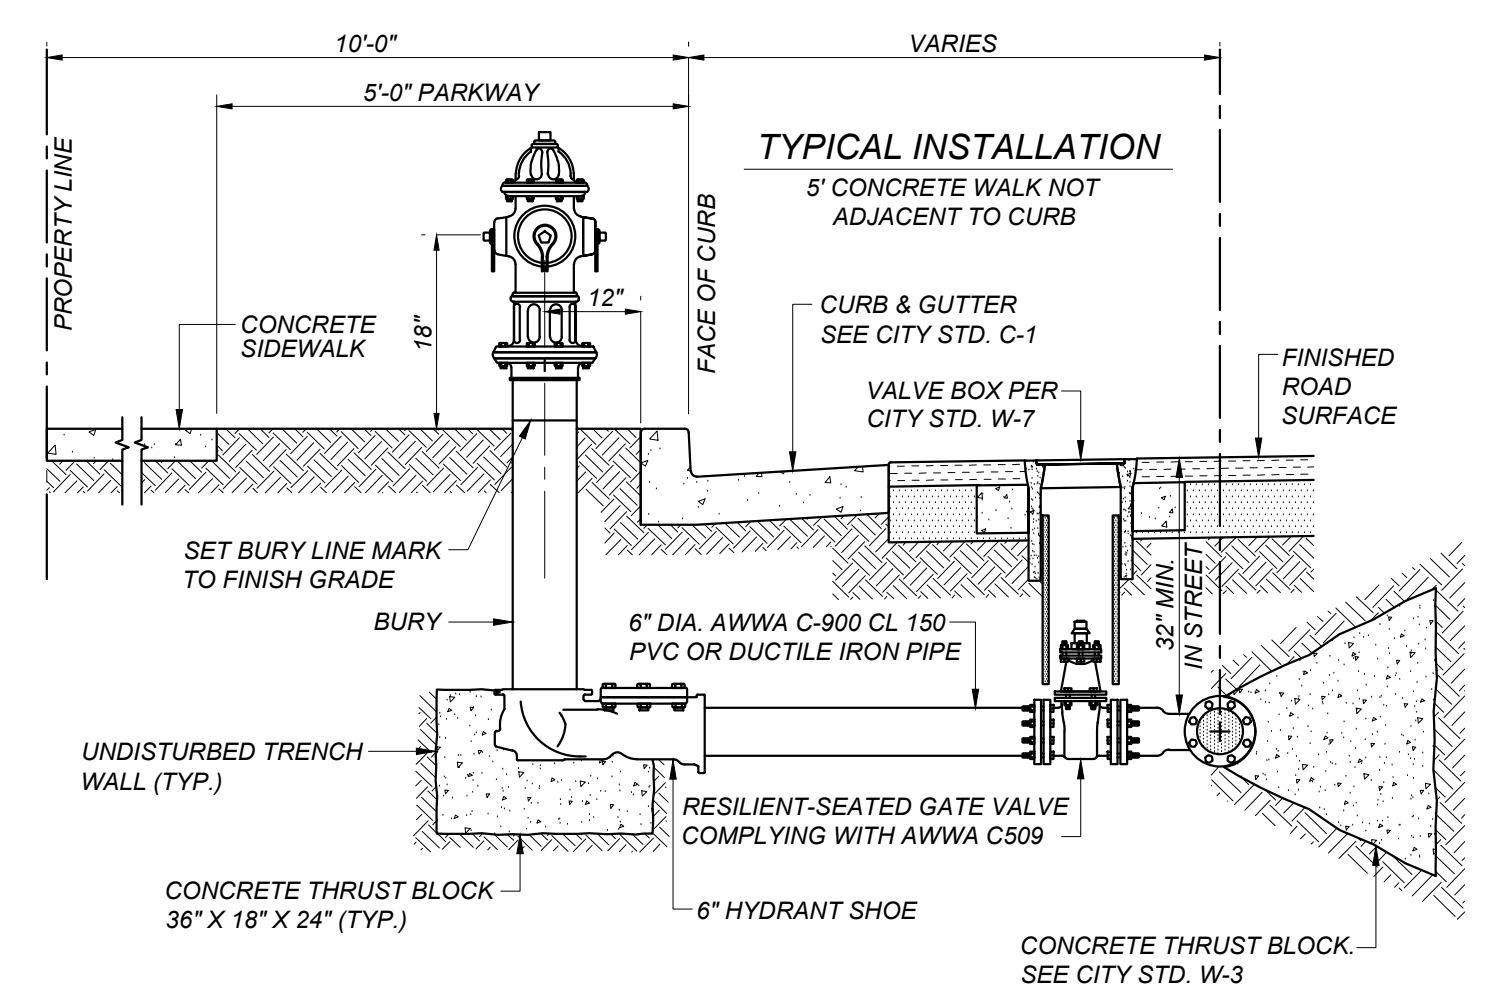

TYPICAL INSTALLATION
5\"/>

FIRE HYDRANT ASSEMBLY
MUELLER A423 CENTURIAN, WATEROUS PACER NO. W9-67, AMERICAN DARLING, KENNEDY GUARDIAN, CLOW MEDALLION, OR CITY ENGINEER APPROVED EQUAL, COMPLETE WITH:


- A. ONE 4-INCH N.S.T. PUMPER NOZZLE.
- B. TWO 2-1/2-INCH N.S.T. HOSE NOZZLE.
- C. HYDRANT VALVE OPENING SHALL BE 5-1/4-INCH, MINIMUM.
- D. BURY SHALL BE 42-INCHES WITH PUSH ON FITTING.
- E. STANDARD PENTAGON OPERATING NUT AND CAP NUT
- F. HYDRANT BODY PAINTED 'SAFETY YELLOW' - RUST-OLEUM HIGH PERFORMANCE PROTECTIVE ENAMEL NO. 242255 OR APPROVED EQUAL. SPRAY PAINT SHALL NOT BE ALLOWED.
- G. BLUE TWO-WAY REFLECTIVE TRAFFIC MARKER OPPOSITE FIRE HYDRANT LOCATION, 6-INCHES FROM ROAD CENTERLINE TOWARD FIRE HYDRANT.
- H. PLUG DRAIN HOLES.

HYDRANT 'T' TO DUCTILE IRON PIPE OR PVC C900 FOR NEW DEVELOPMENT
CITY WATER SYSTEM CONNECTION SHALL BE FLANGED OR APPROVED MECHANICAL JOINT SYSTEM
CONTACT RESPECTIVE WATER SYSTEM REGARDING CONNECTION TO PIPE BY OTHER MATERIAL


GATE VALVES
CLOW 'RESILIENT WEDGE'
MUELLER 'RESILIENT SEAT'
AMERICAN DARLING
KENNEDY RESILIENT
WATEROUS SERIES 500

STANDARD FIRE HYDRANT ASSEMBLY W-8.1


E FIRE HYDRANT INSTALLATION PER CITY OF PORTERVILLE W-8.1
SD/X202 NOT TO SCALE

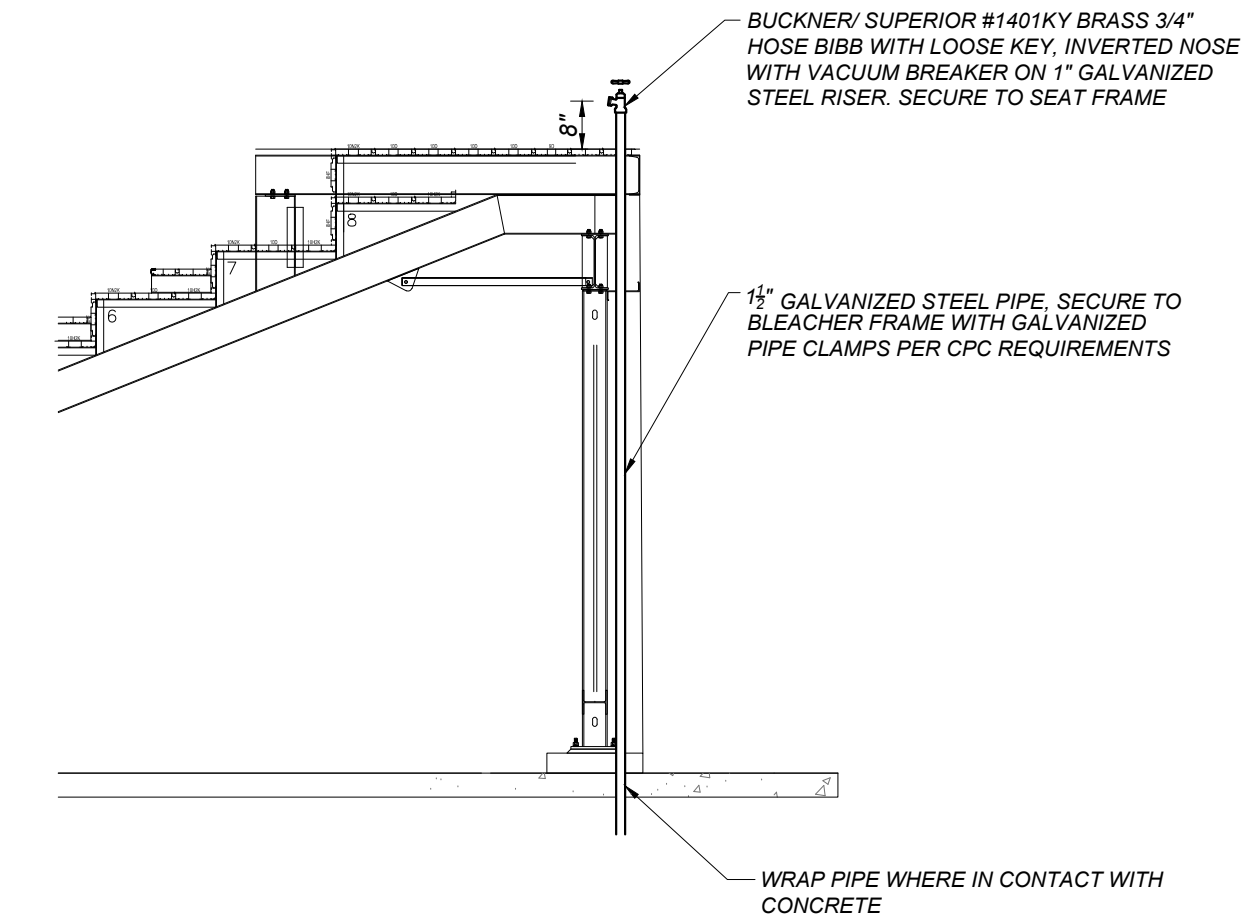


C HOSE BIB INSTALLATION AT BLEACHERS
SD/X202 NOT TO SCALE

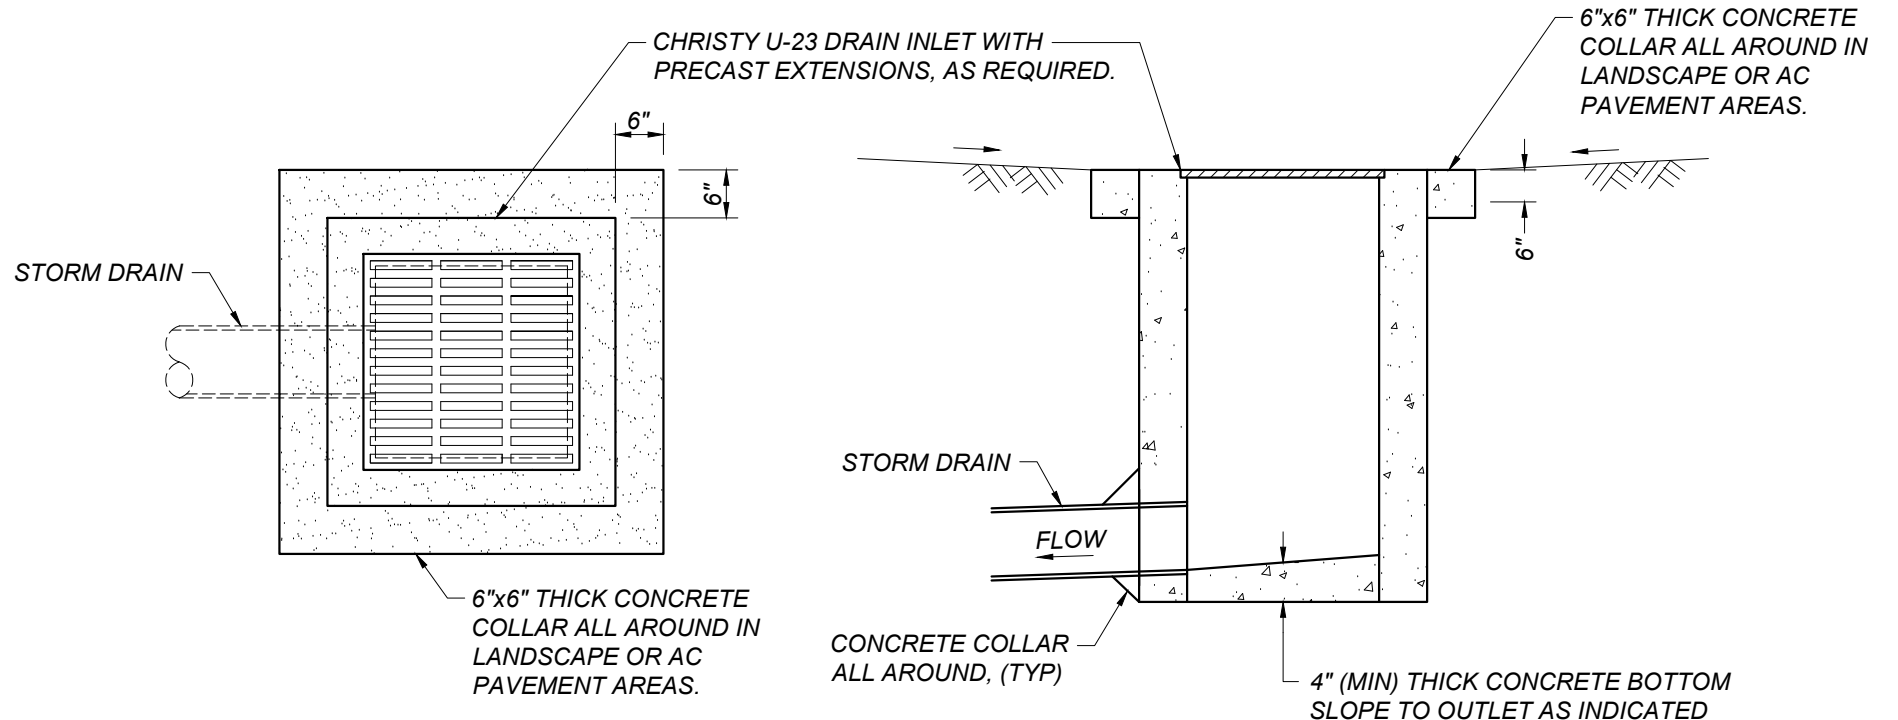


D U-23 DRAIN INLET WITH CONCRETE COLLAR
SD/X202 NOT TO SCALE

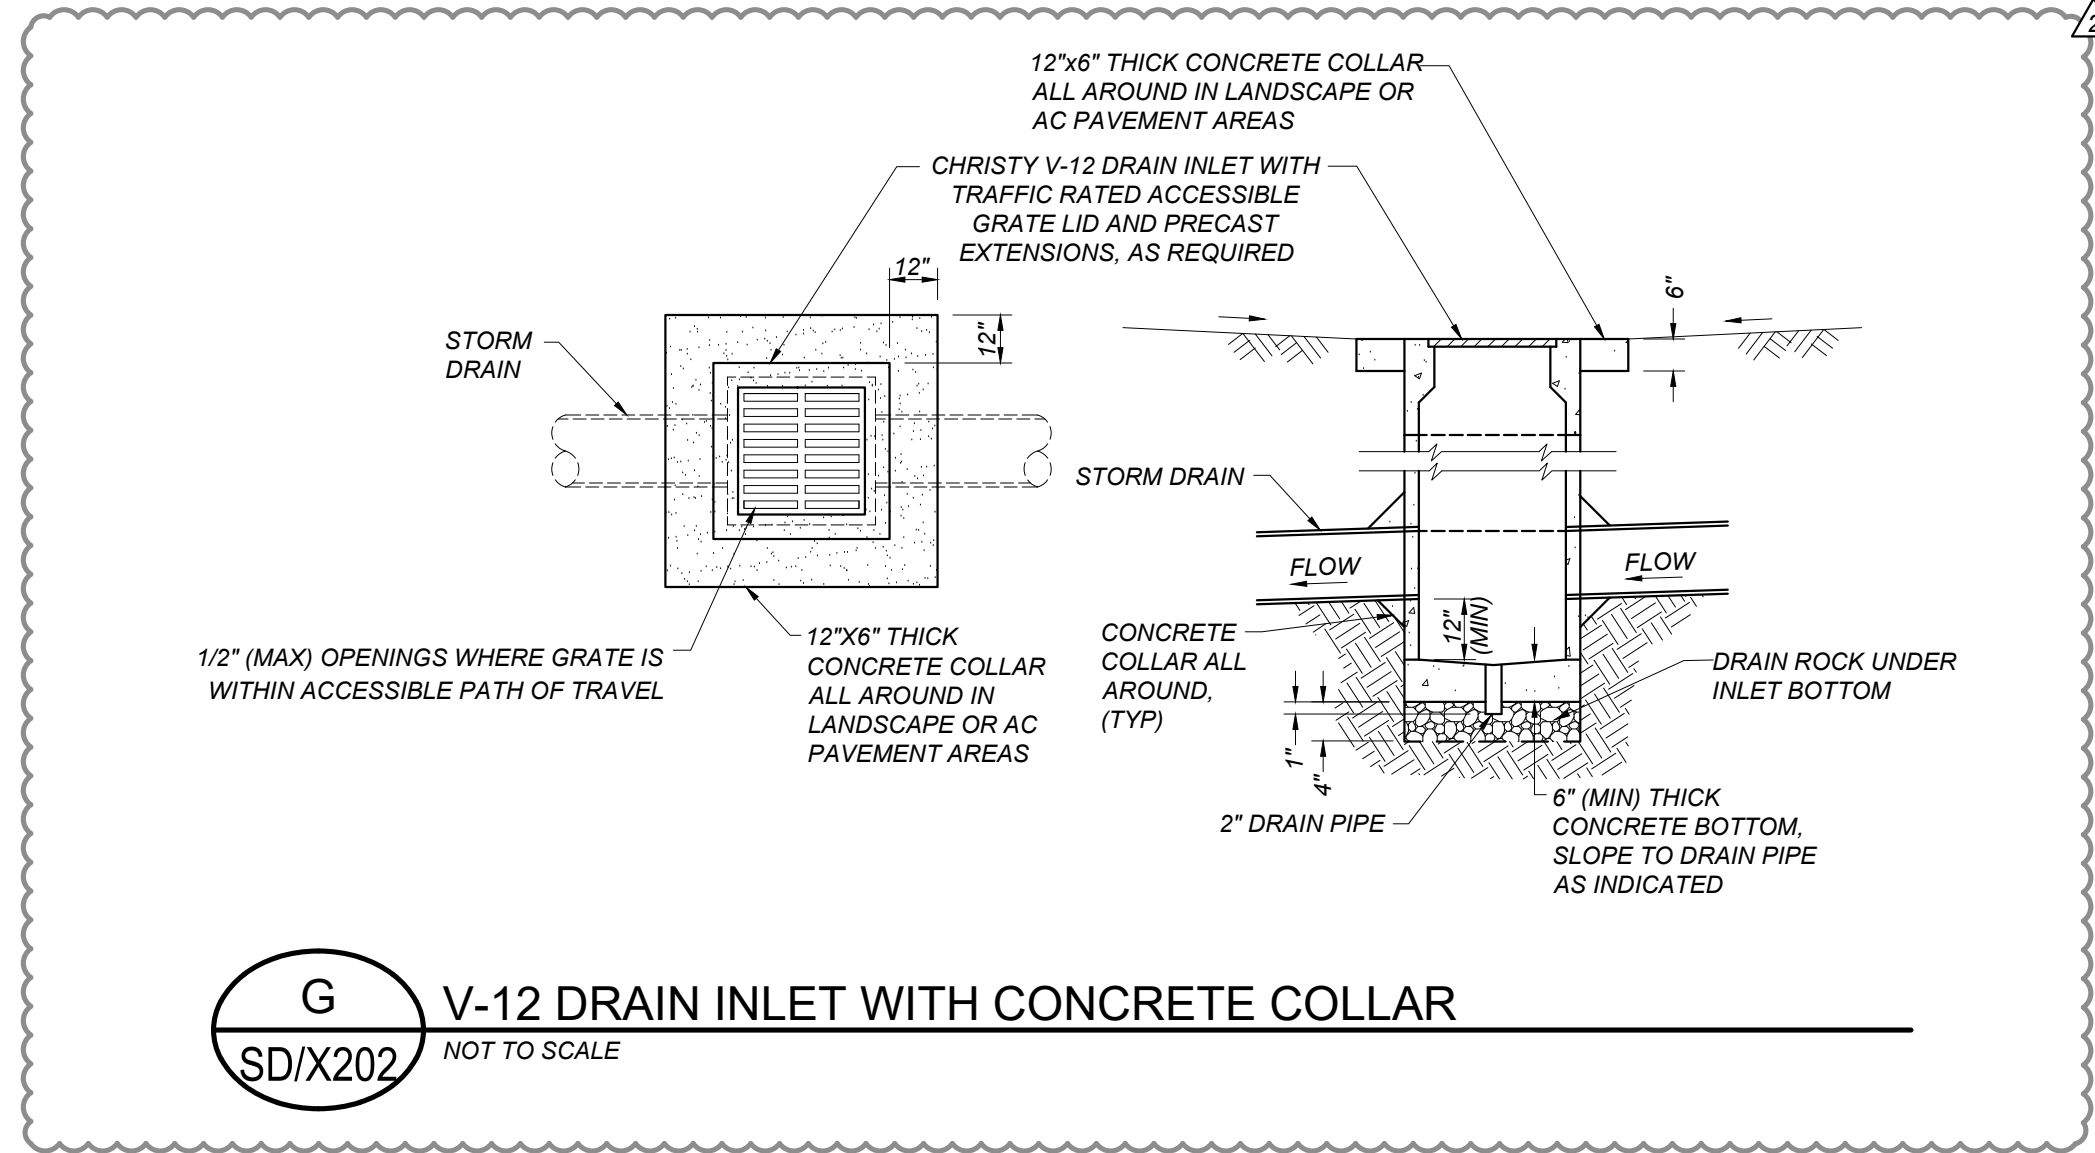

G V-12 DRAIN INLET WITH CONCRETE COLLAR
SD/X202 NOT TO SCALE

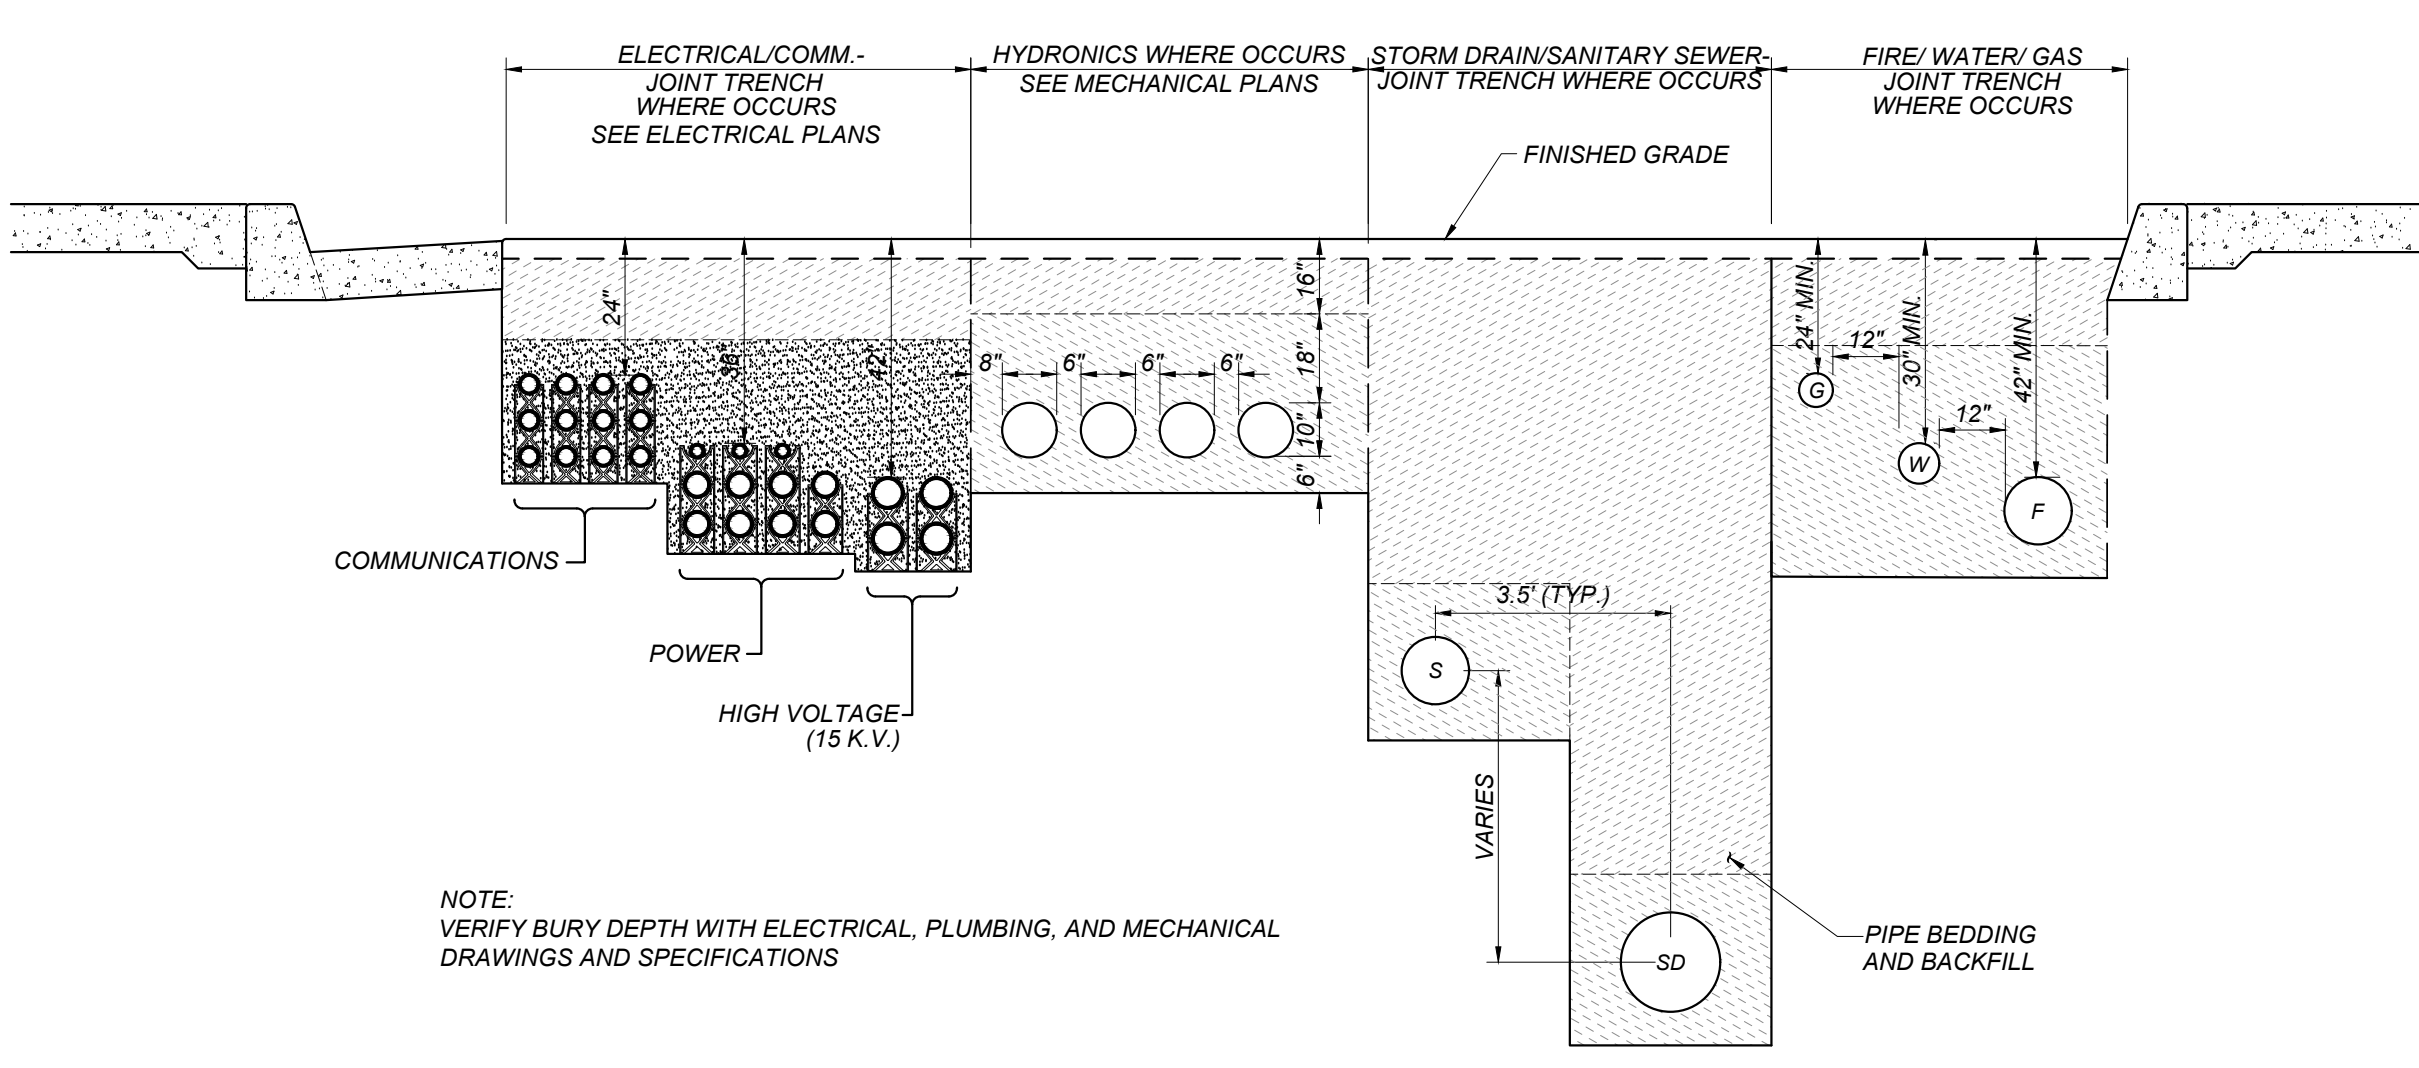

F TYPICAL JOINT UTILITY TRENCH
SD/X202 NOT TO SCALE

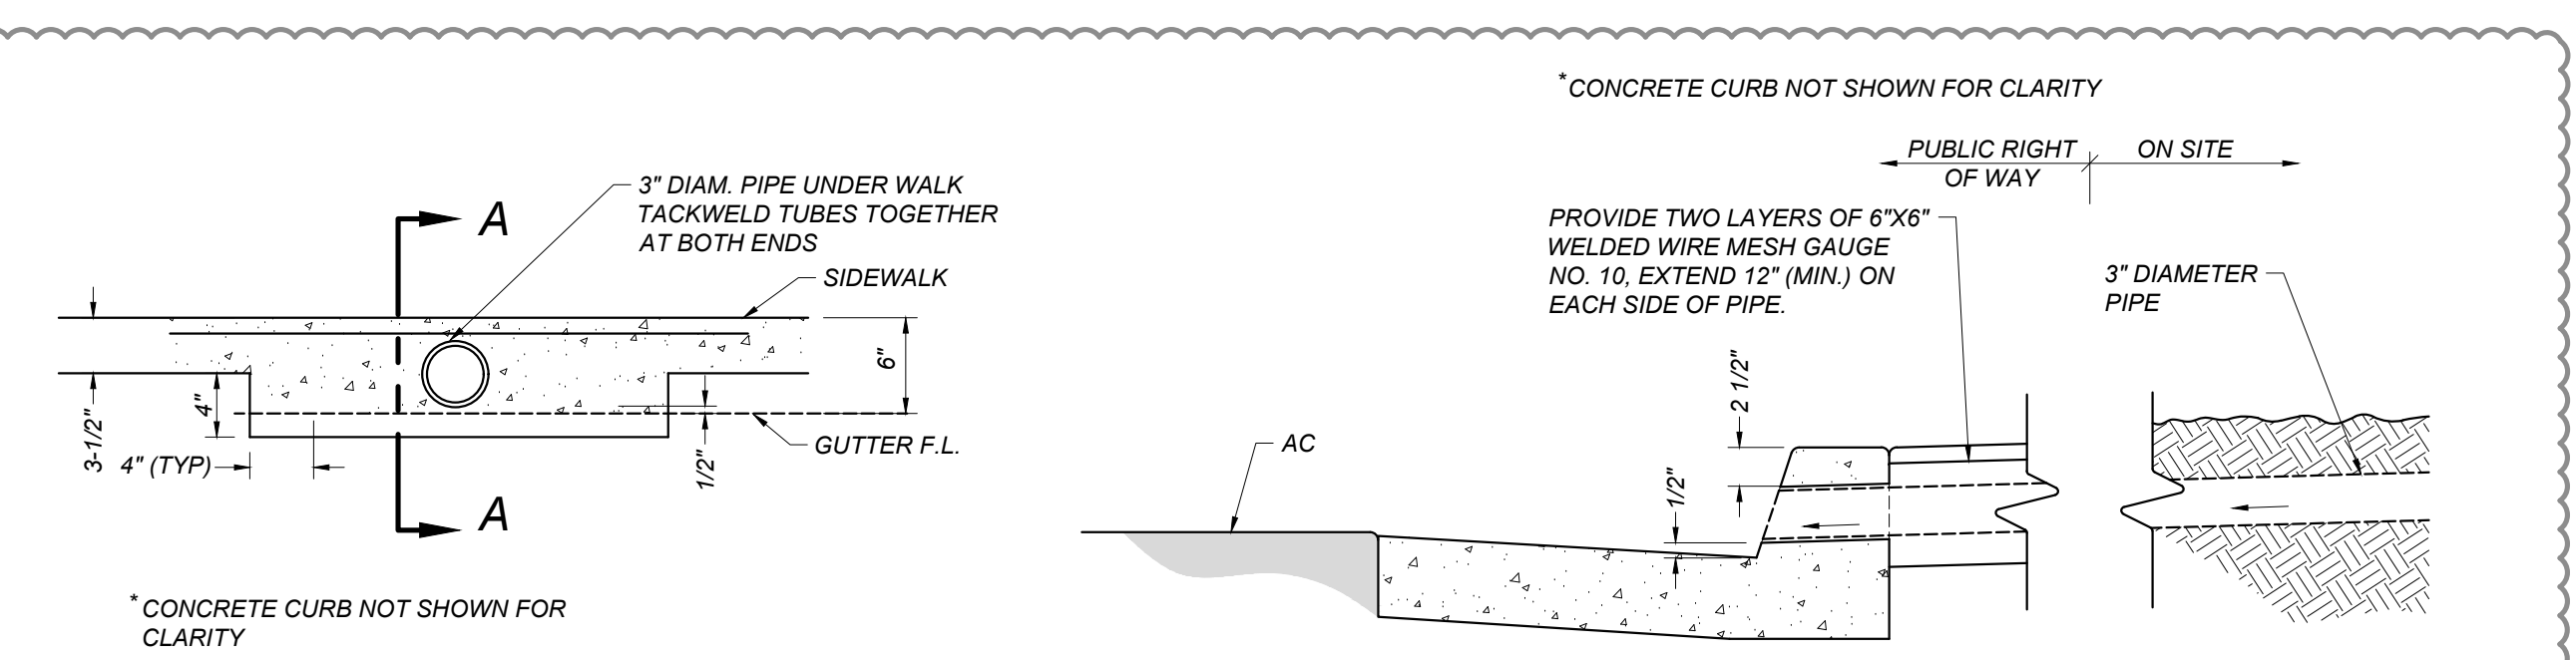

NOTES:

1. FOR 3\"/>
- 2. DRAIN SHALL NOT BE CONSTRUCTED UNDER A DRIVEWAY APPROACH.
- 3. SIDEWALK DRAINS, EXCEPT CHANNELS, SHALL BE ANGLED THROUGH SIDEWALK IN DIRECTION OF GUTTER FLOW.
- 4. ALL DRAINS AND CHANNELS SHALL BE FLUSH W/FACE OF CURB.
- 5. DRAIN SLOPES SHALL BE 010 FT/FT (MIN.) AND 042 FT/FT (MAX.)
- 6. SURFACE DRAINAGE OVER DRIVEWAY APPROACHES AND SIDEWALKS IS NOT PERMITTED WHEN THE AREA TO BE DRAINED EXCEEDS 1/4 ACRE.

H SIDEWALK PIPE UNDERDRAIN
SD/X202 NOT TO SCALE

DSA File No.: 15-C1
 DSA Application No.: 03-122694
 Agency Approval

Blair, Church & Flynn Consulting Engineers
 461 Clovis Avenue, Suite 200
 Clovis, California 93612
 Tel (559) 326-1400 Fax (559) 326-1500

PORTERVILLE COLLEGE ATHLETIC COMPLEX PHASE I
 100 E COLLEGE AVE, PORTERVILLE, CA 93257

UTILITY DETAILS


darden architects ARCHITECTURE PLANNING INTERIORS
 www.dardenarchitects.com
 6790 N. West Ave. • Fresno, CA 93711 • T. 559.448.8051

No.	Revision/Submission	Date
1	ADDENDUM 02	01/11/2024


Designed By: ZH
 Drawn By: AH
 Project Number: 2118
 Date: 12/28/2023

Copyright 2024 Darden Architects
 Checked By: JF
 Reviewed By: ZH


SD/X202 AD2-CX11

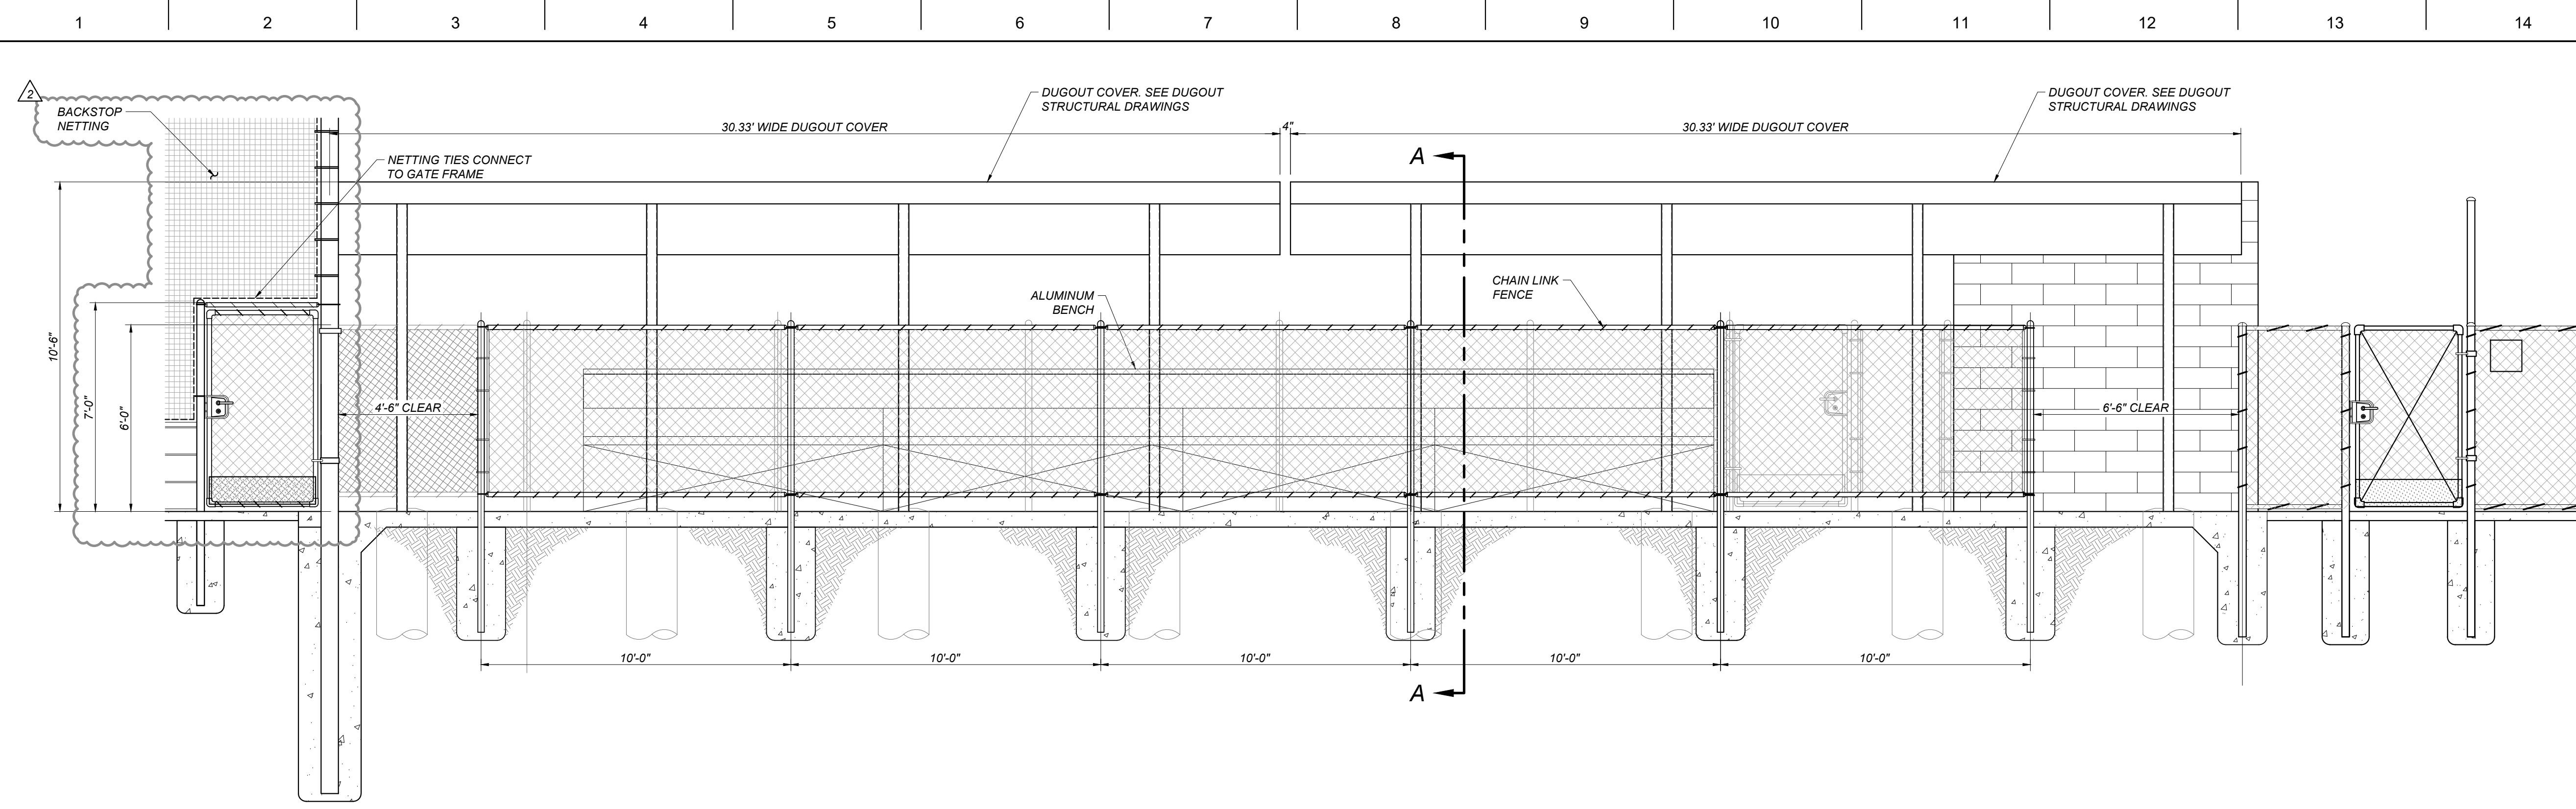

A SOFTBALL DUGOUT ELEVATION
SD/X402 NOT TO SCALE

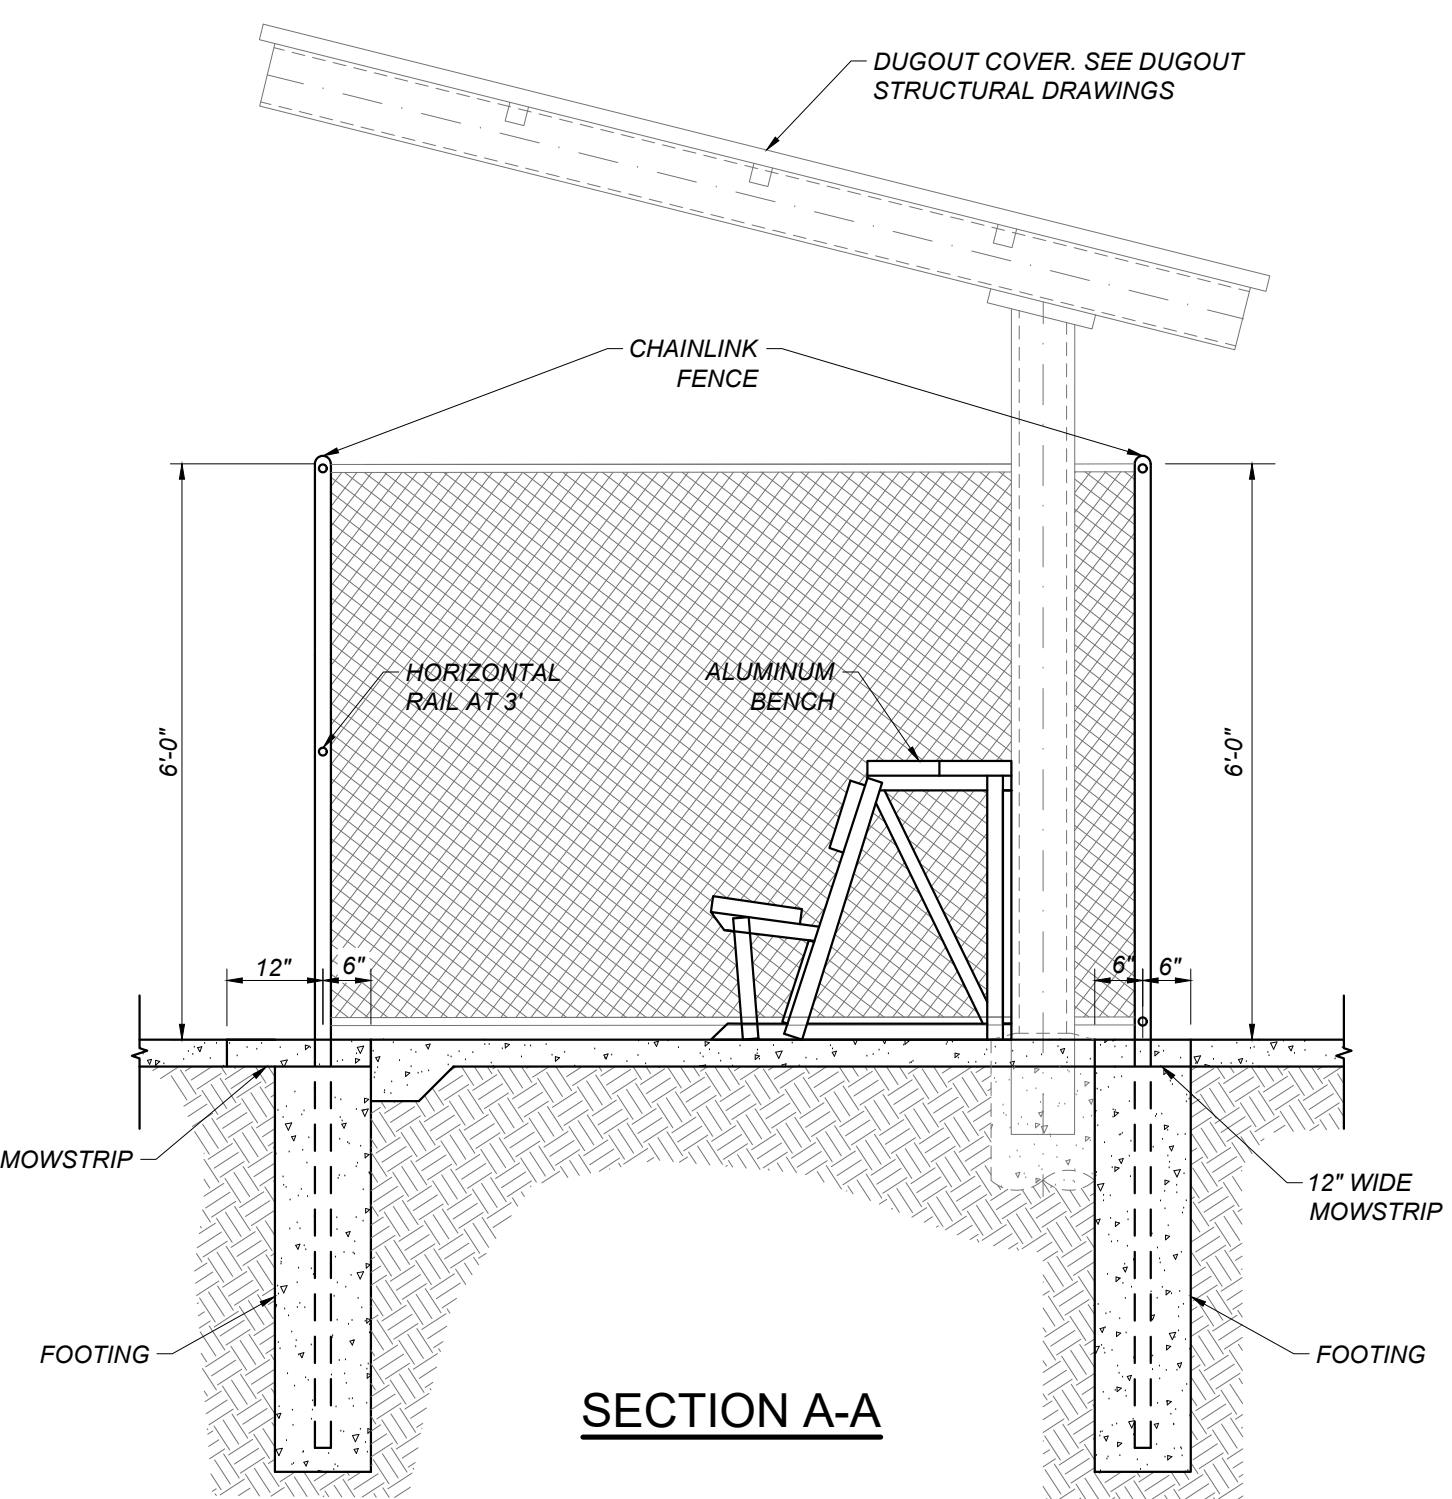


B SOFTBALL DUGOUT SECTION VIEW
SD/X402 NOT TO SCALE

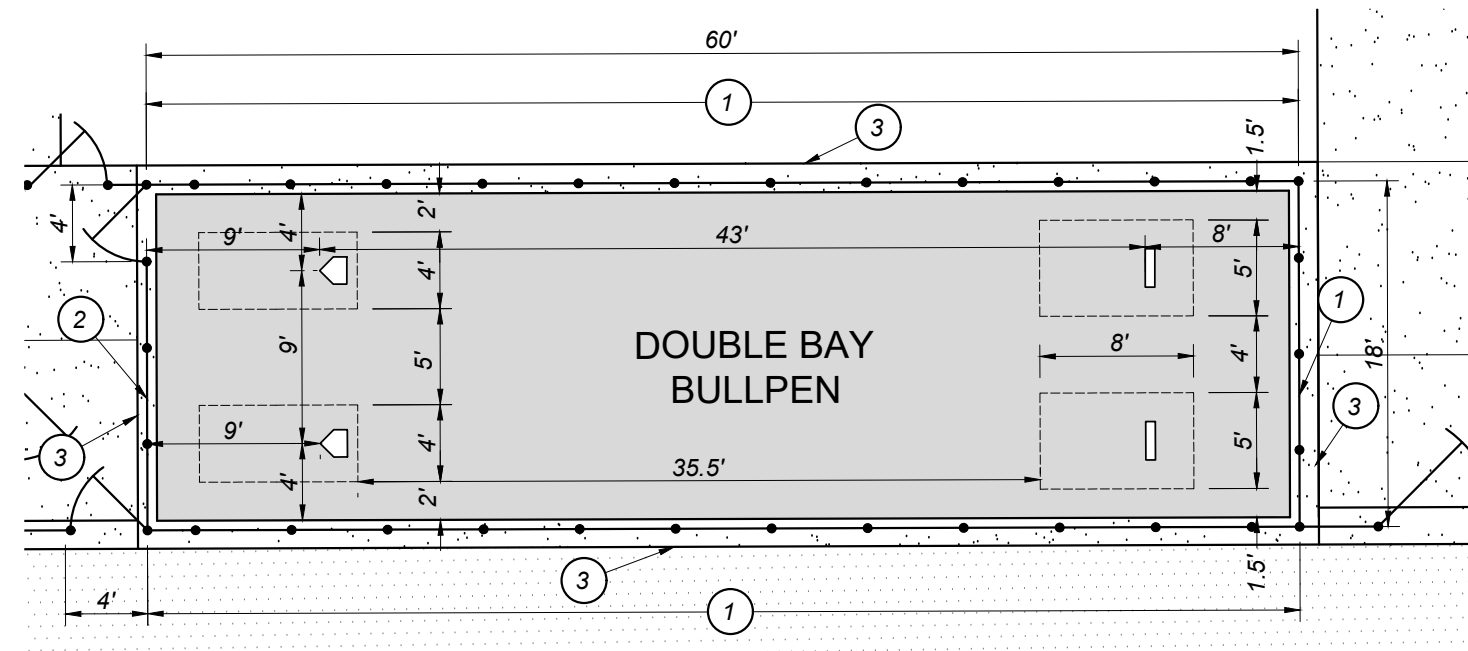

C TYPICAL SOFTBALL BULLPEN
SD/X402 SCALE: 1" = 10'

- KEYNOTES LEGEND:**
- 1 INSTALL 6' HIGH CHAIN LINK FENCE PER DETAIL [A/SD/X301]
 - 2 INSTALL 10' HIGH CHAIN LINK FENCE PER DETAIL [A/SD/X301]
 - 3 CONCRETE MOWSTRIP PER DETAIL [D/SD/X101]
- NOTES:**
1. ALL AREAS AFFECTED BY WELDING, TRIMMED ENDS OF BOLTS, STRETCHER BARS, OR ANY EXPOSED STEEL SHALL BE PAINTED (GALVANIZED) PER CONTRACT SPECIFICATIONS.
 2. CONTRACTOR TO PROVIDE AND INSTALL GATE HOLDBACK FOR EACH GATE. HOLDBACK TO BE INSTALLED IN FENCE MOWSTRIP UNLESS OTHERWISE NOTED.
 3. SURFACE OF BULLPEN TO BE SKINNED INFIELD PER DETAIL [H/SD/X101]

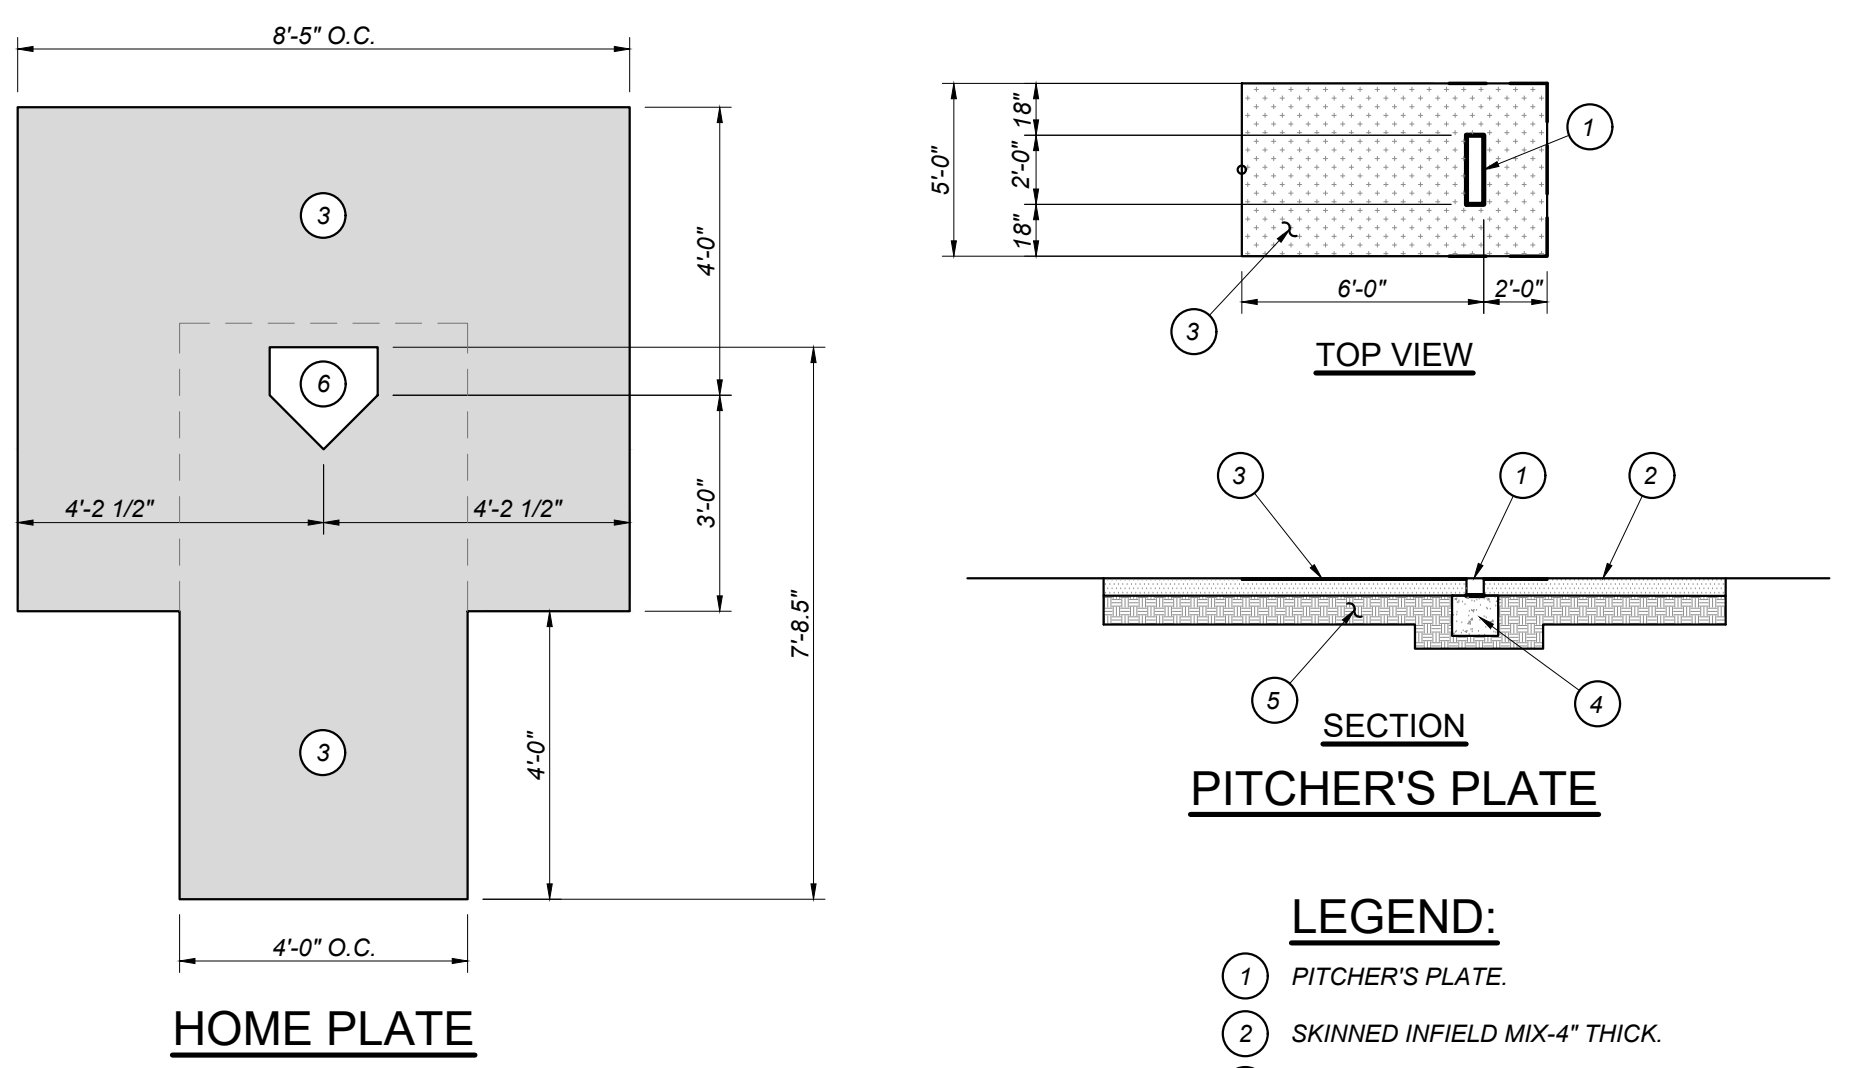

D SOFTBALL PACKING CLAY AT HOME PLATE AND PITCHERS PLATE
SD/X402 NOT TO SCALE

DSA File No.: 15-C1
DSA Application No.: 03-122694
Agency Approval

Blair, Church & Flynn
CONSULTING ENGINEERS
Blair, Church & Flynn Consulting Engineers
461 Clovis Avenue, Suite 200
Clovis, California 93612
Tel (559) 326-1400 Fax (559) 326-1500

Professional Engineer Seal: Robert D. Flynn, No. 57218, State of California, 05.07.2023

Consultant

PORTERVILLE COLLEGE ATHLETIC COMPLEX
PHASE I
100 E COLLEGE AVE.
PORTERVILLE, CA 93257

Project

SOFTBALL DUGOUT DETAILS
Drawing

darden architects
ARCHITECTURE PLANNING INTERIORS
www.dardenarchitects.com
6790 N. West Ave. • Fresno, CA 93711 • T. 559.448.8051


Licensed Architect Seal: Robert L. Peterson, No. L16986, State of California, 05.07.2023

Architect

No.	Revision/Submission	Date
ADDENDUM 02		01/11/2024
Revision		
Scale:	AS NOTED	Drawn By: AH
Project Number:	2118	Checked By: JF
Date:	12/28/2023	Reviewed By: ZH

Designed By: ZH Copyright 2024 Darden Architects

SD/X402
AD2-CX13

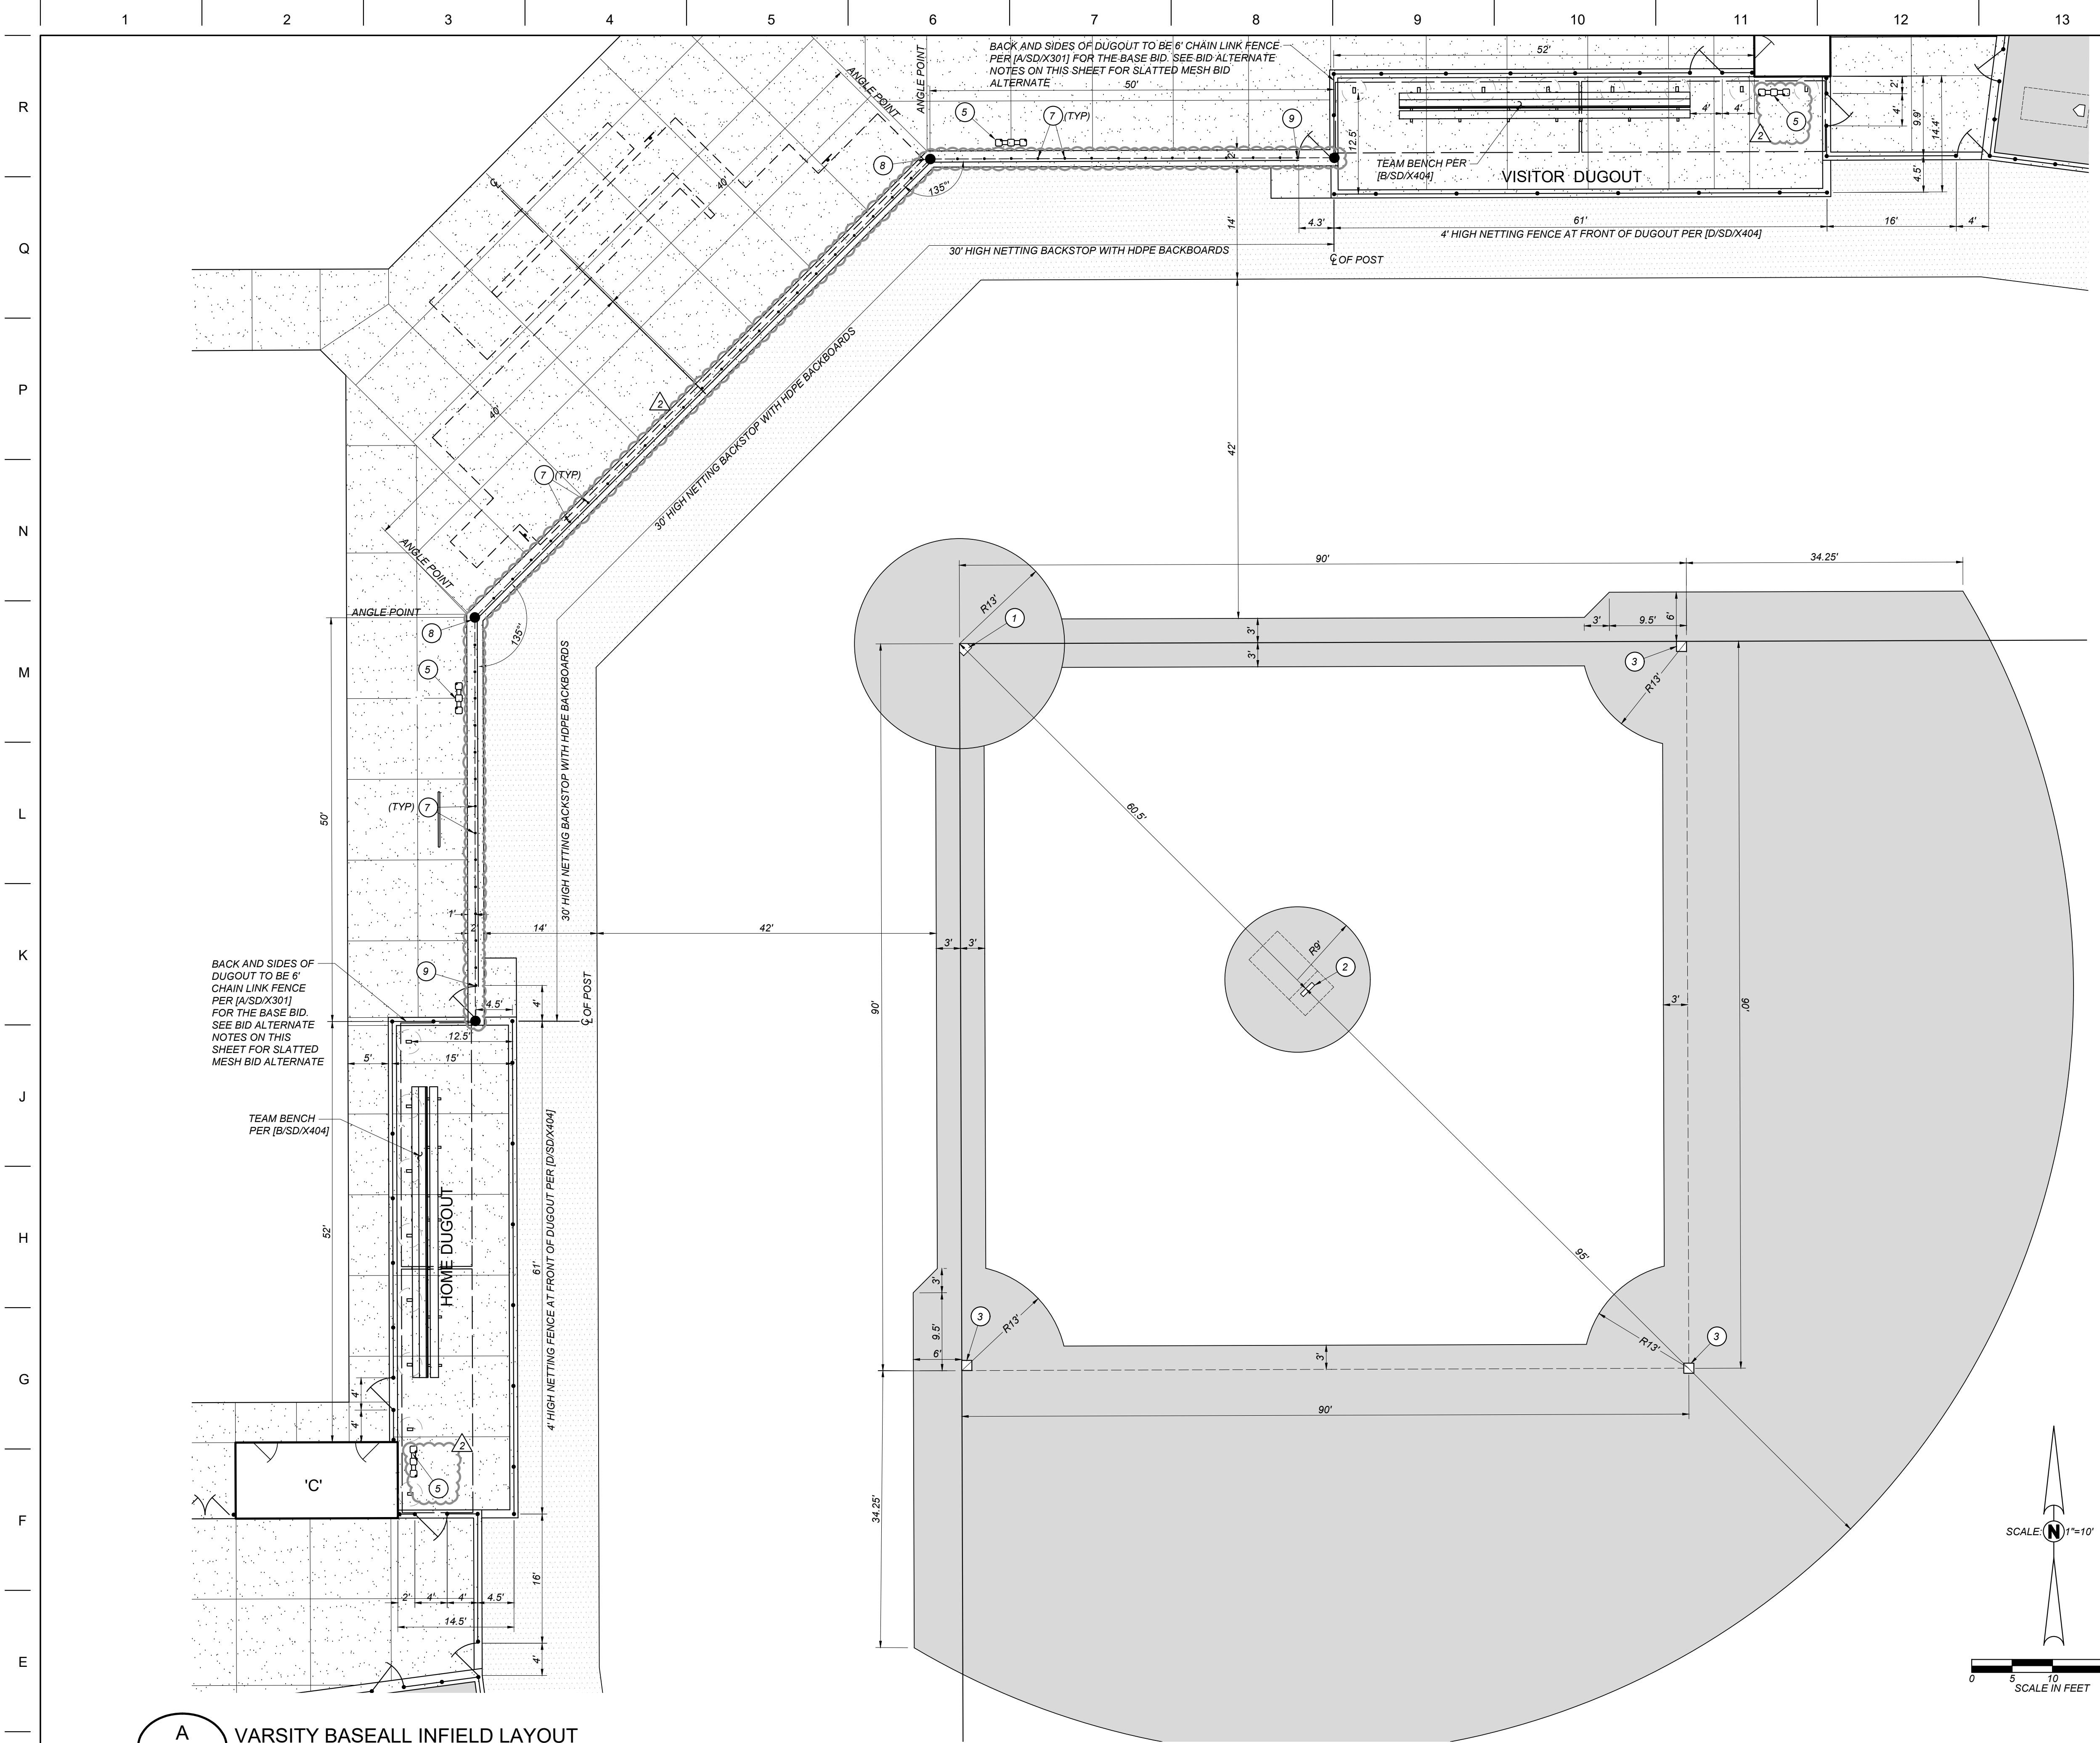

SITE LEGEND:

- 1 HOME PLATE PER [E/SD/X404]
- 2 PITCHER'S PLATE PER [E/SD/X404] CENTERED ON INFIELD DIAGONAL
- 3 INFIELD BASE PER SPECIFICATIONS
- 4 NOT USED
- 5 DRINKING FOUNTAIN PER [B/SD/X202]
- 6 NOT USED
- 7 2-3/8" O.D. MID BRACE POST SEE [H/SD/X501] FOR HDPE BOARD ATTACHMENT DETAIL
- 8 6-5/8" O.D. BACKSTOP ANGLE POST SEE [G/SD/X501] FOR HDPE BOARD ATTACHMENT DETAIL
- 9 2-3/8" O.D. BACKSTOP END POST SEE [D/SD/X501] FOR HDPE BOARD ATTACHMENT DETAIL


NOTES:

1. SEE [B/SD/X403] FOR BACKSTOP ELEVATION VIEW AND ADDITIONAL INFORMATION
2. CONTRACTOR TO PROVIDE BASES, BASE ANCHORS, AND PLATES

DUGOUT FENCING BID ALTERNATE:

1. BASE BID FOR DUGOUTS SHALL INCLUDE OPEN MESH CHAIN LINK FENCING ON THE BACK AND SIDES PER DETAIL [A/SD/X301]
2. BID ALTERNATE FOR DUGOUTS SHALL INCLUDE SLATTED CHAIN LINK FENCING ON THE BACK AND SIDES PER DETAIL [C/SD/X301]

A VARSITY BASEBALL INFIELD LAYOUT
SCALE 1" = 10'

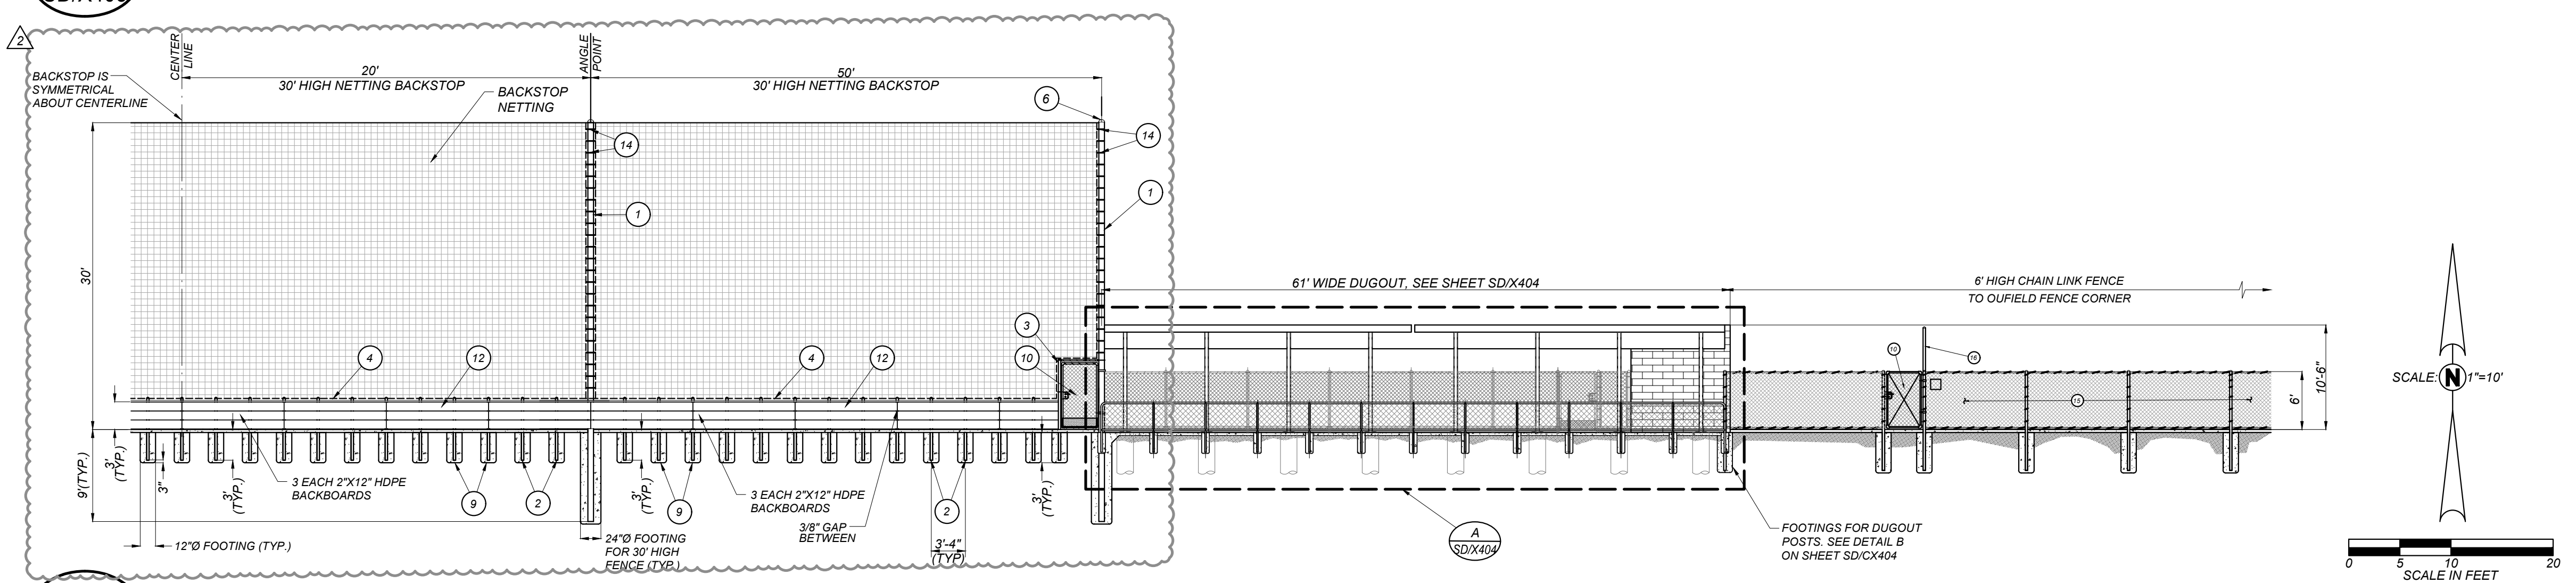

B BASEBALL FIELD ELEVATION VIEW OF BACKSTOP
SCALE 1" = 10'

NOTE: THE BASEBALL BACKSTOP IS EXEMPT FROM DSA REVIEW PER DSA IR A-22 APPENDIX ITEM 11 AND IS NOT PART OF THIS DSA APPROVAL. THE BACKSTOP IS LESS THAN 35 FT ABOVE ADJACENT GRADE AND UTILIZES CANTILEVERED POLES.

FENCING KEYNOTE LEGEND:

- 1 6-5/8" O.D. GALVANIZED STEEL POST (18.97 LB/FT)
- 2 2-3/8" O.D. GALVANIZED STEEL MID-BRACE POST (3.65 LB/FT)
- 3 2-7/8" O.D. GALVANIZED STEEL POST (3.65 LB/FT)
- 4 1-5/8" O.D. GALVANIZED HORIZONTAL RAIL (2.27 LB/FT)
- 5 NOT USED
- 6 RAIN-PROOF POST CAP
- 7 NOT USED
- 8 NOT USED
- 9 CONCRETE POST FOOTING. POUR AGAINST UNDISTURBED SOIL
- 10 ACCESSIBLE WALK GATE PER DETAIL [A/X201], MAXIMUM 48" WIDTH
- 11 NOT USED
- 12 2" X 12" DURAWOOD HDPE BOARDS PER DETAIL [H/SD/X501]
- 13 NOT USED
- 14 NETTING TIE DOWNS PER MANUFACTURER
- 15 6" HIGH CHAIN LINK FENCE PER DETAIL [A/SD/X301]
- 16 10" HIGH CHAIN LINK FENCE PER DETAIL [A/SD/X301]

DSA File No.: 15-C1

DSA Application No.: 03-122694

Agency Approval

General Notes

Blair, Church & Flynn
CONSULTING ENGINEERS
Blair, Church & Flynn Consulting Engineers
461 Clovis Avenue, Suite 200
Clovis, California 93612
Tel (559) 326-1400 Fax (559) 326-1500

Consultant

PORTERVILLE COLLEGE ATHLETIC COMPLEX
PHASE I
100 E COLLEGE AVE.
PORTERVILLE, CA 93257

Project

BASEBALL INFIELD PLAN
Drawing

darden architects
ARCHITECTURE PLANNING INTERIORS
www.dardenarchitects.com
6790 N. West Ave. • Fresno, CA 93711 • T. 559.448.8051


Architect

No.	Revision/Submission	Date
ADDENDUM 02		01/11/2024


Designed By: ZH
Copyright 2024 Darden Architects

Scale: AS NOTED
Drawn By: AH
Project Number: 2118
Checked By: JF
Date: 12/28/2023
Reviewed By: ZH

**SD/X403
AD2-CX14**

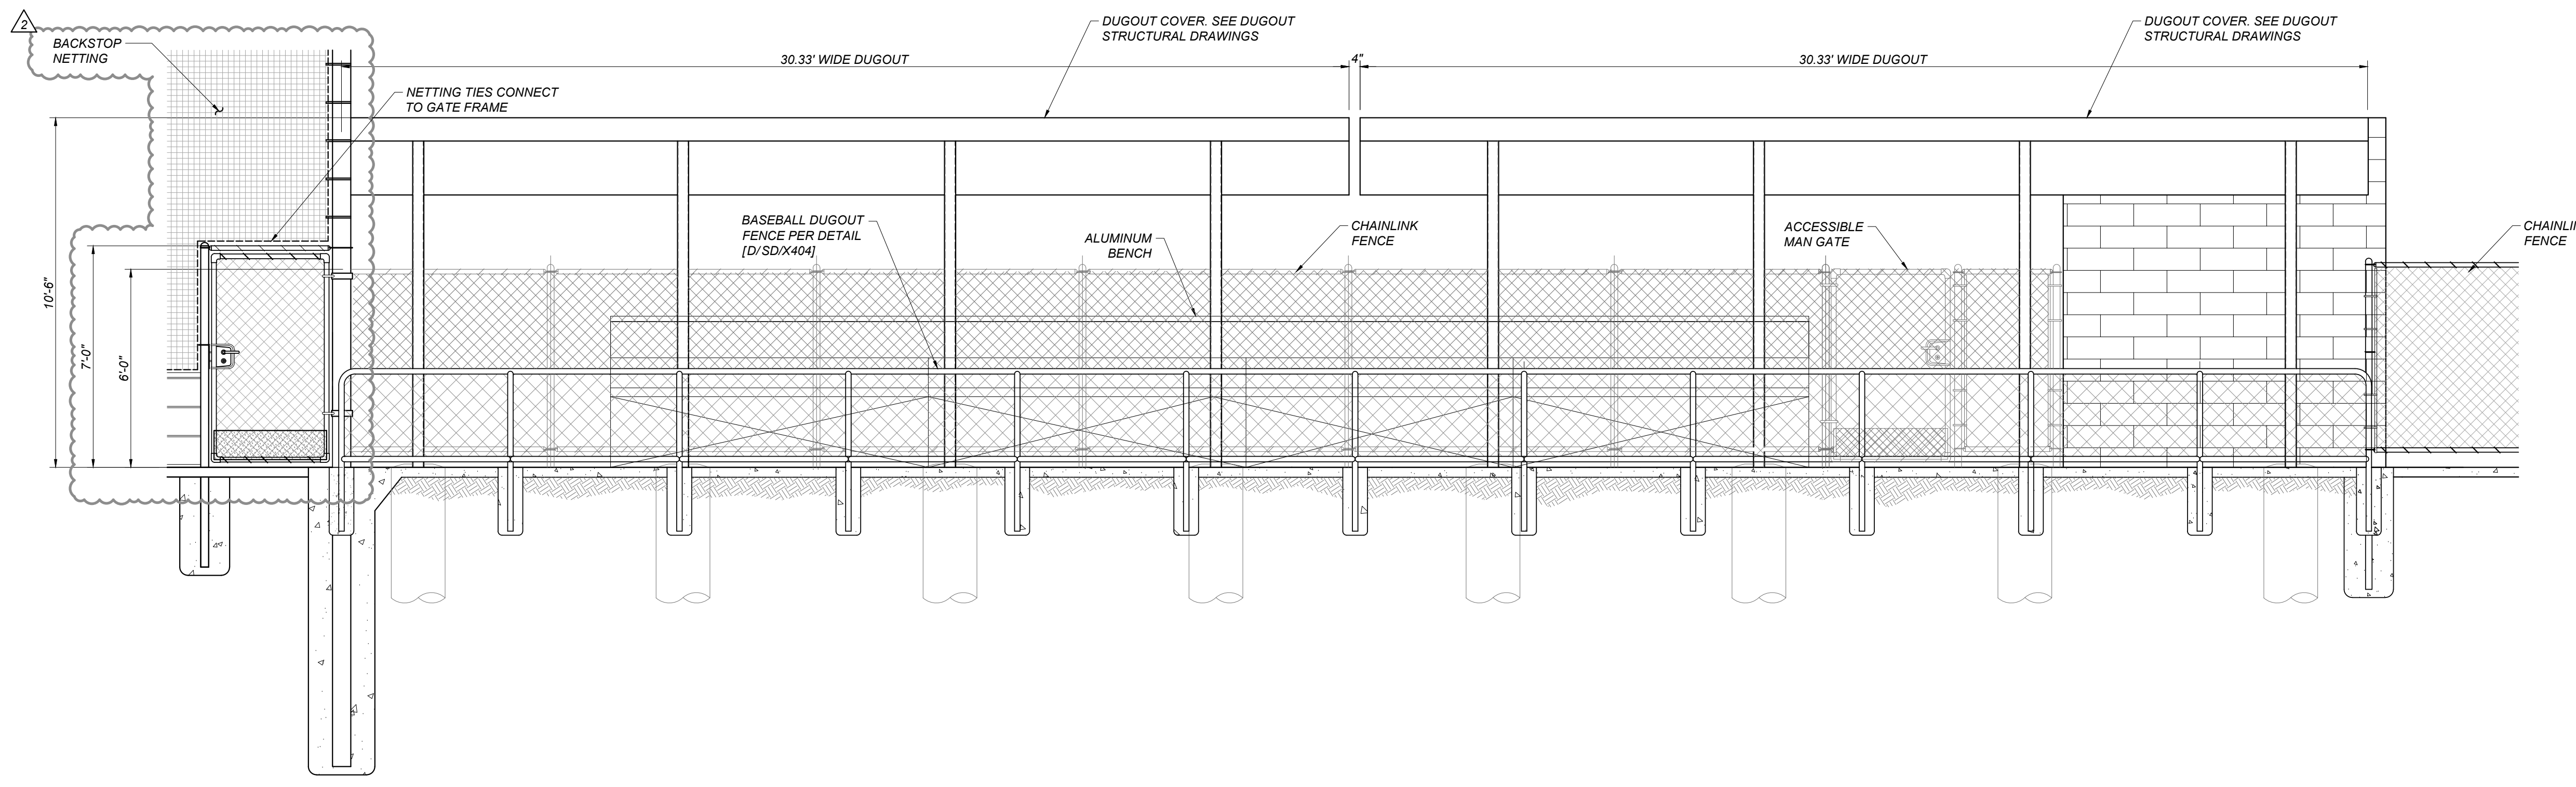


A BASEBALL DUGOUT ELEVATION
SD/X404 NOT TO SCALE

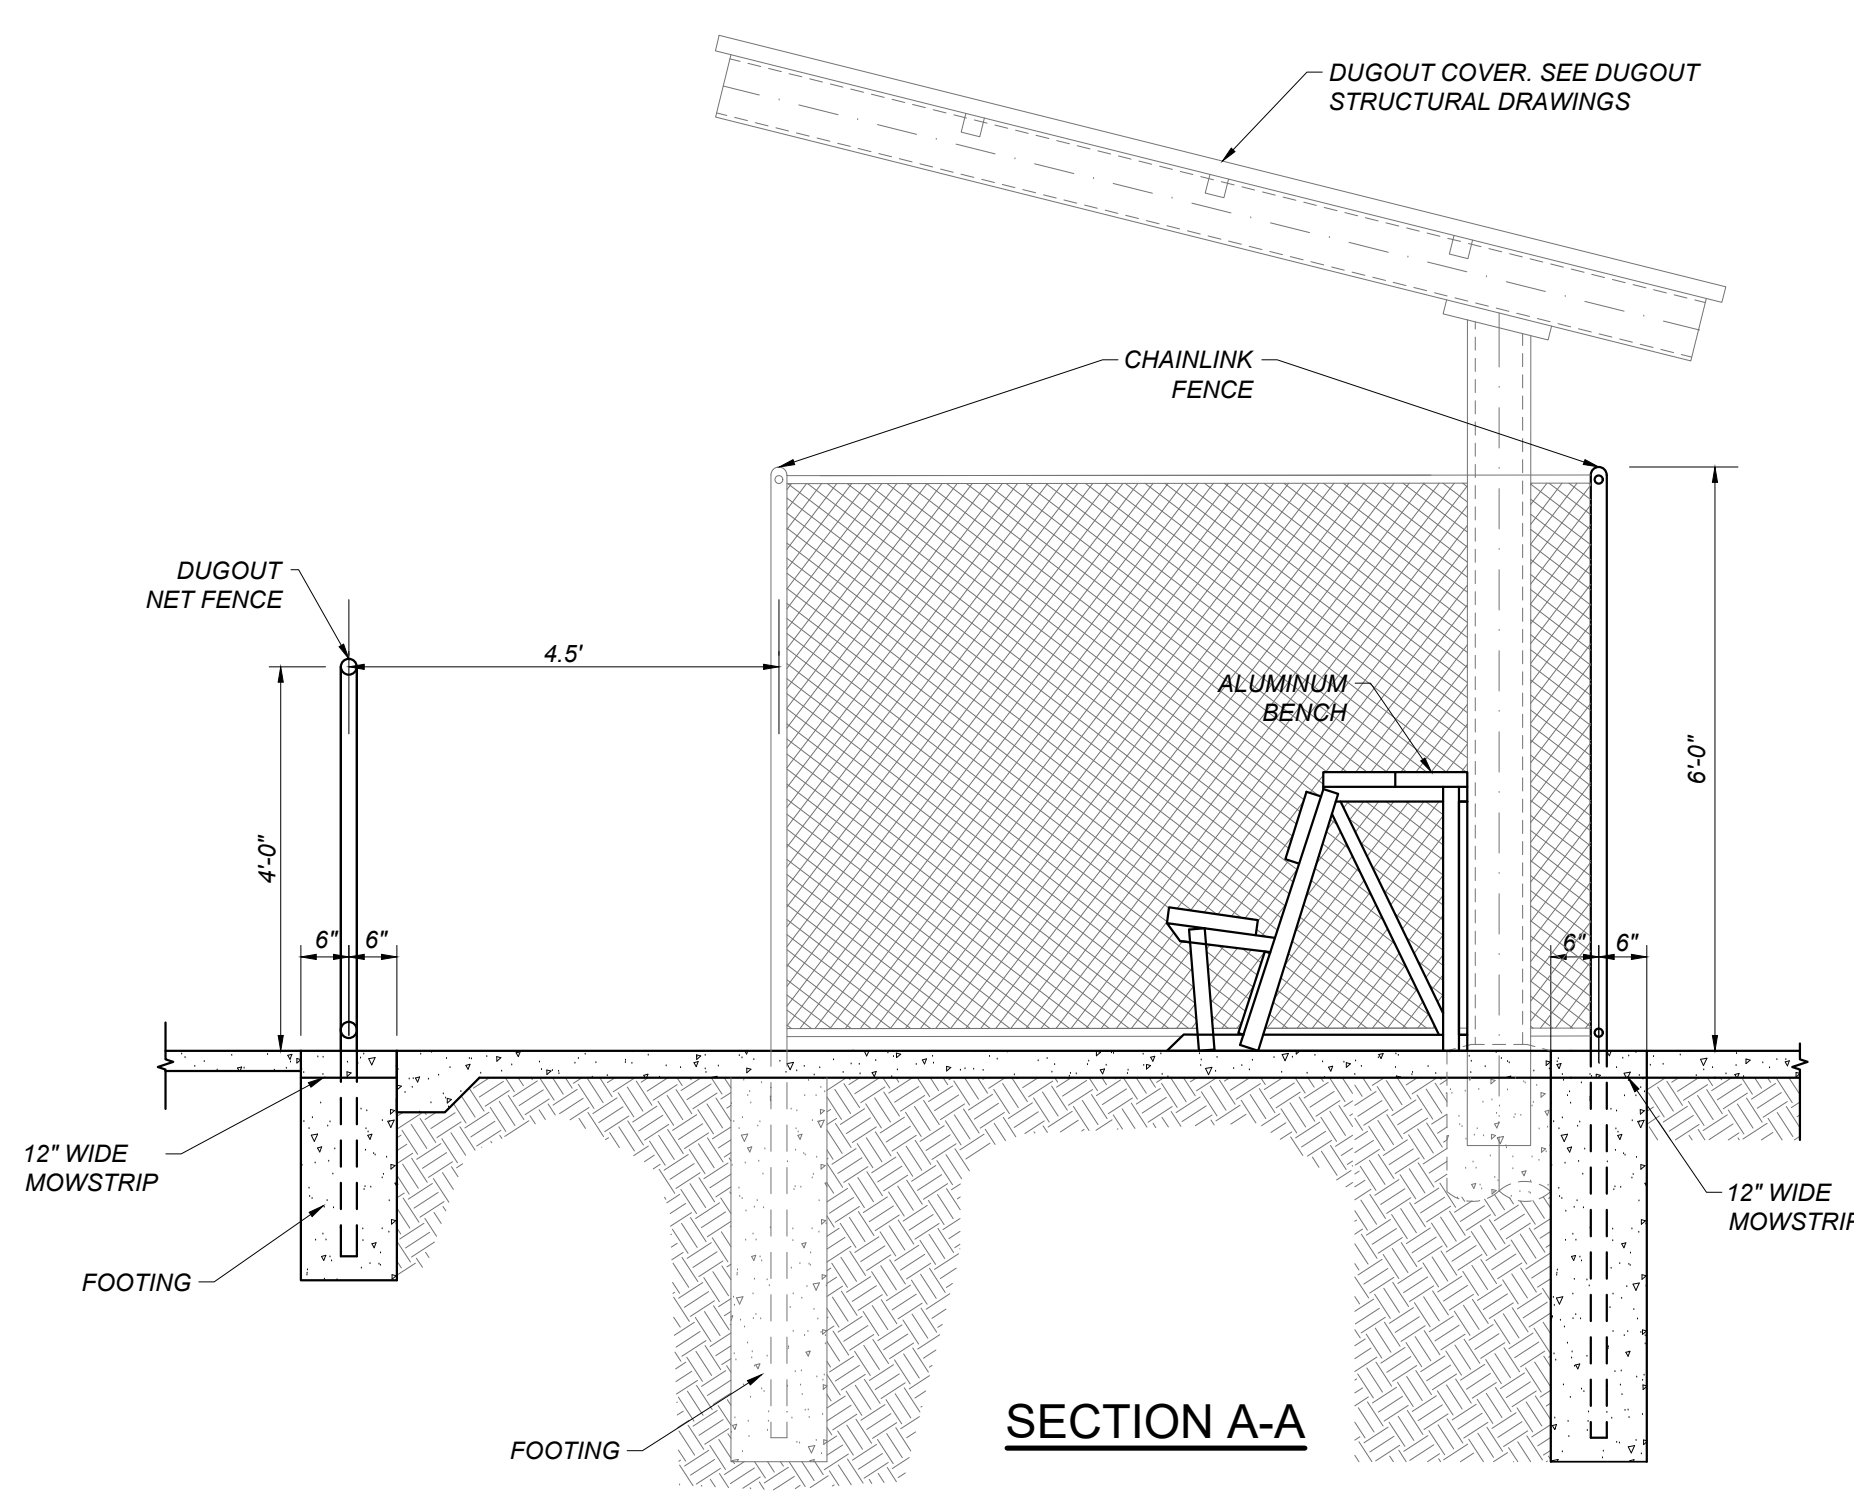


B BASEBALL DUGOUT SECTION VIEW
SD/X404 NOT TO SCALE

- LEGEND:**
- 1 2" O.D. GALVANIZED STEEL PIPE FRAME, WELDED
 - 2 NETTING SHALL BE #32 TWINE SIZE WITH 1-3/4" DIAMOND SHAPED MESH HAVING A TENSILE STRENGTH OF 350 LBS.
 - 3 ATTACH NETTING PANEL TO RAIL USING BLACK NYLON CORD, SPACED EVERY 4"
 - 4 GUARD RAIL PADDING (PROMATS, MODEL BRPBD1, COLOR BY OWNER) OR APPROVED EQUAL ATTACH WITH ZIP TIES.

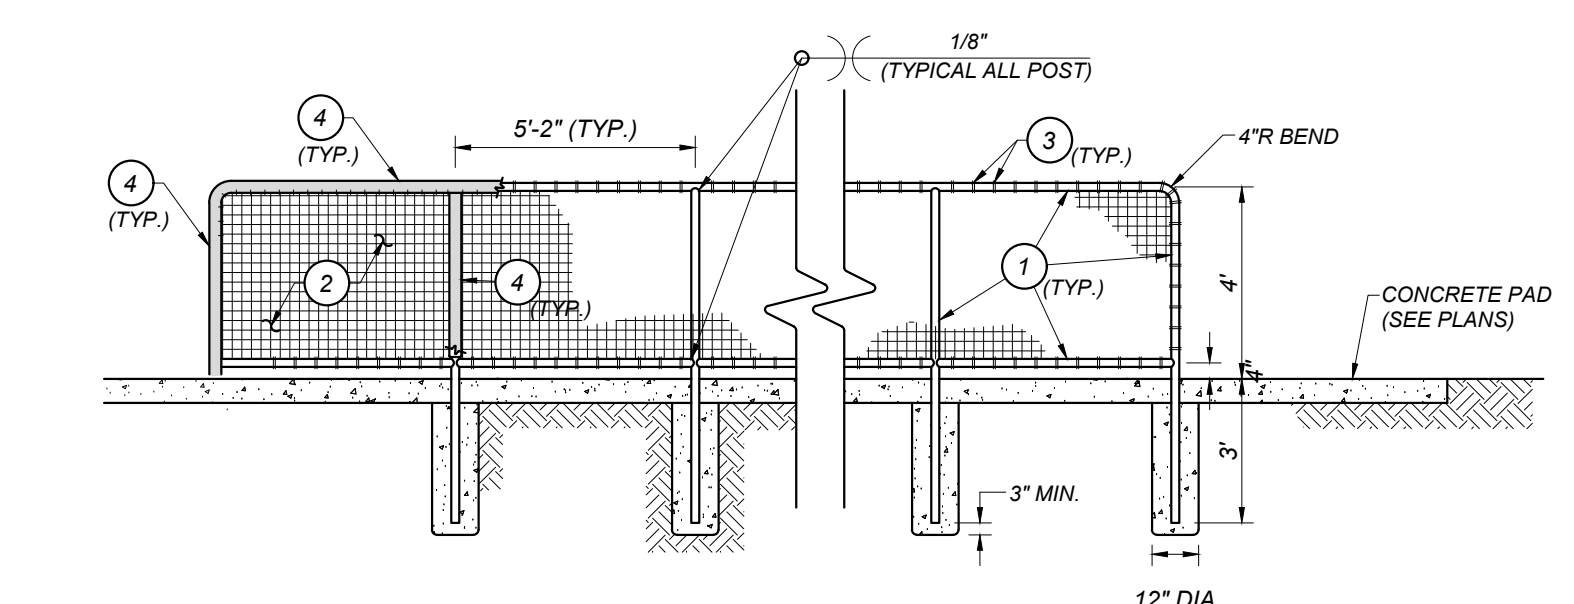


D BASEBALL DUGOUT FENCE
SD/X404 NOT TO SCALE

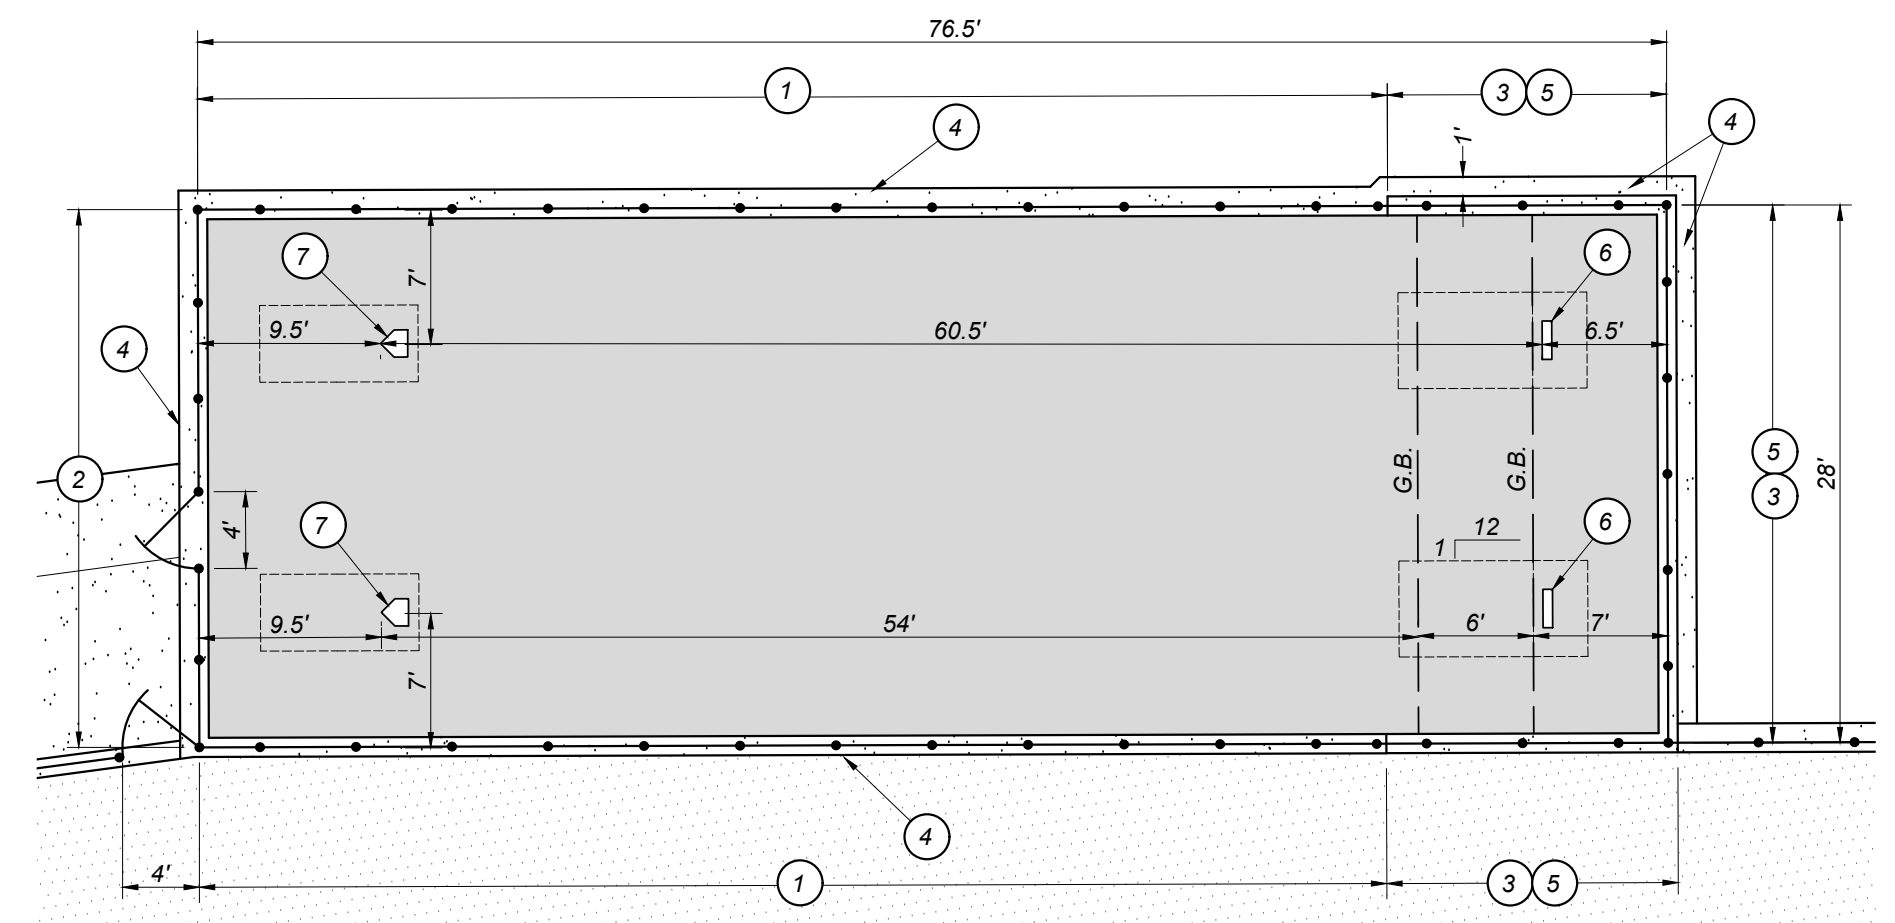

PLAN VIEW

- KEYNOTES LEGEND:**
- 1 INSTALL 6' HIGH CHAIN LINK FENCE PER DETAIL (A/SD/X301)
 - 2 INSTALL 10' HIGH CHAIN LINK FENCE PER DETAIL (A/SD/X301)
 - 3 INSTALL 5' HIGH CHAIN LINK FENCE PER DETAIL (A/SD/X301)
 - 4 CONCRETE MOWSTRIP PER DETAIL (D/SD/X101)
 - 5 RETAINING MOWSTRIP PER DETAIL (F/SD/X404)
 - 6 PITCHER'S PLATE - PER DETAIL (E/SD/X404)
 - 7 HOME PLATE PER DETAIL (E/SD/X404)
- NOTES:**
- 1 ALL AREAS AFFECTED BY WELDING, TRIMMED ENDS OF BOLTS, STRETCHER BARS, OR ANY EXPOSED STEEL SHALL BE PAINTED (GALVANIZED) PER CONTRACT SPECIFICATIONS.
 - 2 CONTRACTOR TO PROVIDE AND INSTALL GATE HOLDBACK FOR EACH GATE. HOLDBACK TO BE INSTALLED IN FENCE MOWSTRIP UNLESS OTHERWISE NOTED.
 - 3 SURFACE OF BULLPEN TO BE SKINNED INFIELD PER DETAIL (H/SD/X101)


C BASEBALL BULLPEN
SD/X404 SCALE: 1" = 10'

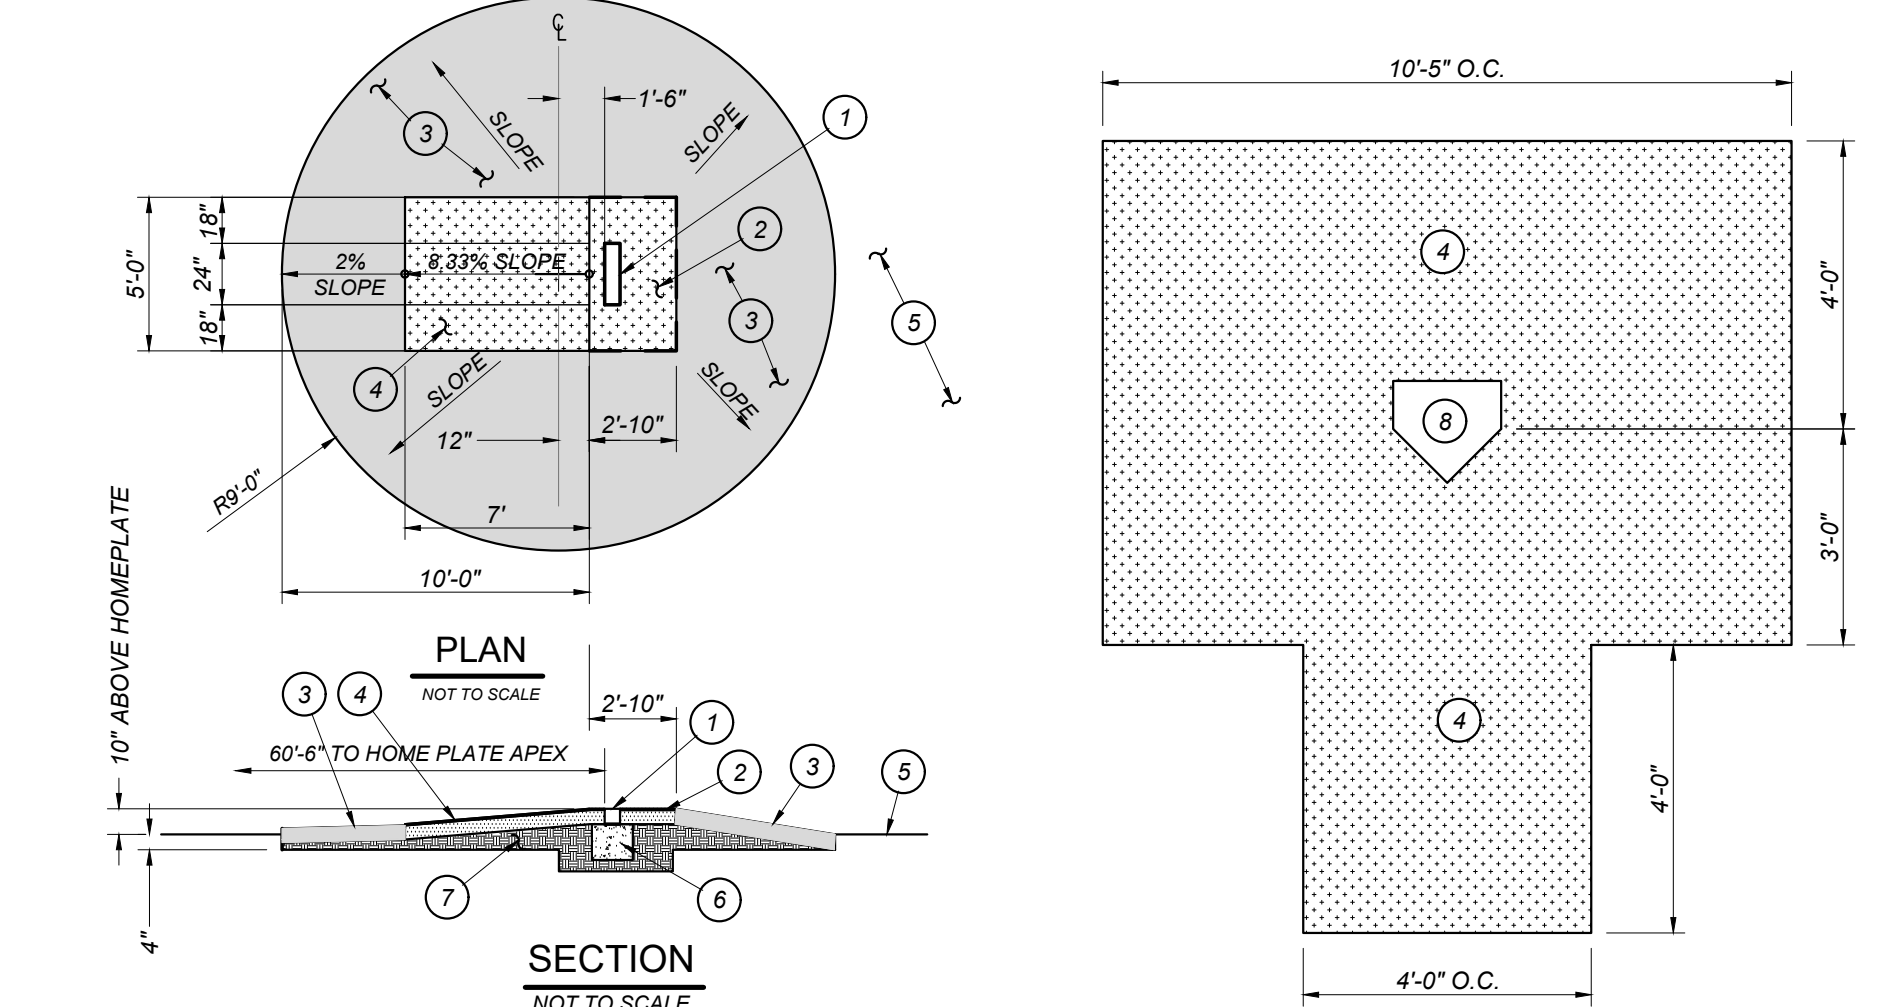


- LEGEND:**
- 1 6"x24" PITCHER'S RUBBER
 - 2 34"x80" LEVEL AREA
 - 3 CLAY INFIELD MIX-4" THICK
 - 4 3-1/2" THICK COMPACTED MOUND PACKING CLAY WITH 1/2" THICK INFIELD MIX TOPPING LAYER
 - 5 INFIELD TURF
 - 6 12"x36" CAST-IN-PLACE CONCRETE SUPPORT
 - 7 COMPACTED SUBGRADE
 - 8 HOMEPLATE

NOTE:
ALL BASEBALL LAYOUT AND DIMENSIONS MUST CONFORM TO 2006 NFHS/CIF BASEBALL RULES.

E PITCHERS MOUND/PACKING CLAY DETAIL
SD/X404 NOT TO SCALE

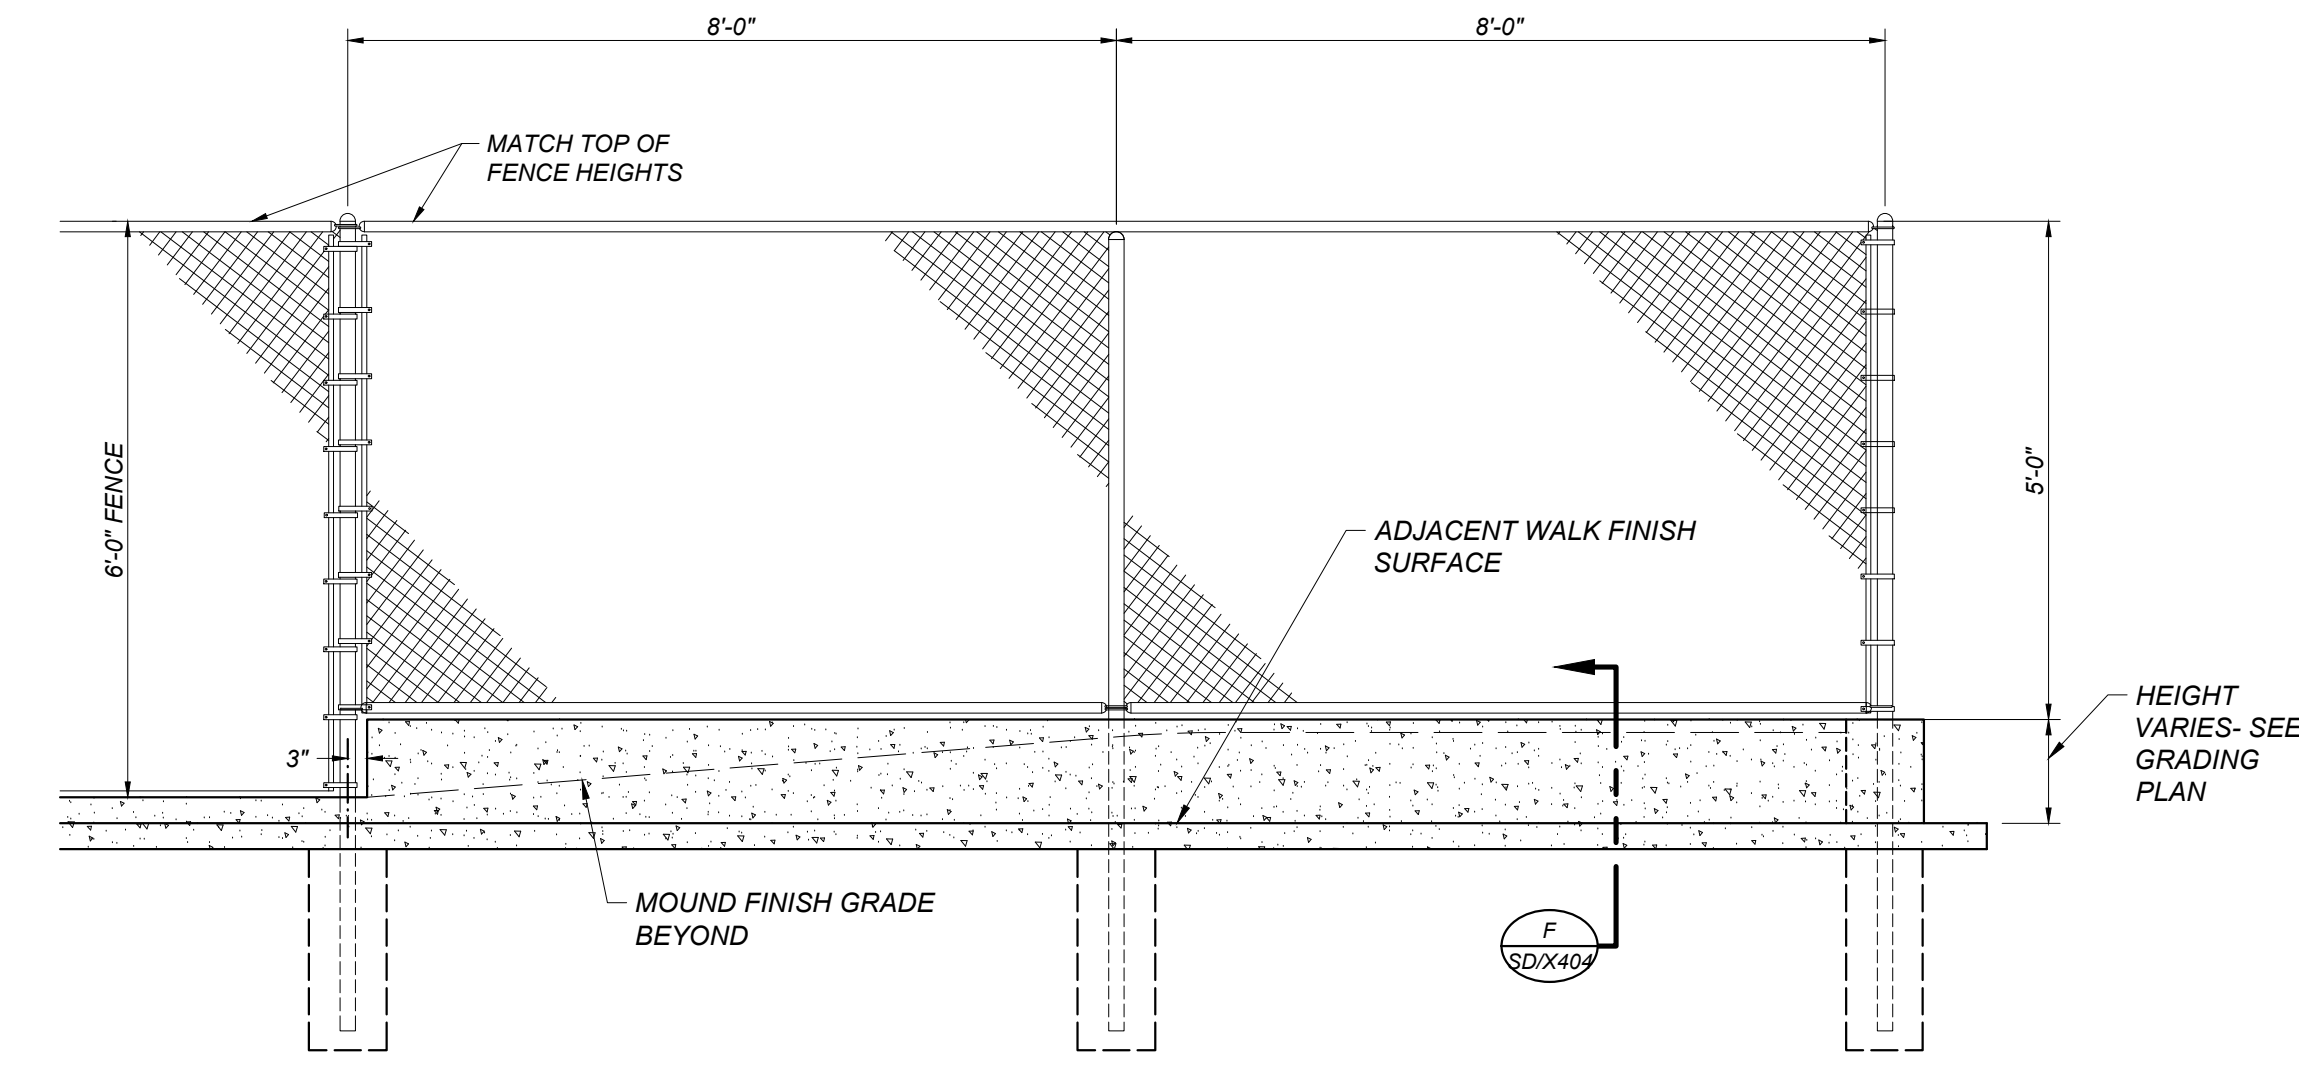

TYPICAL BULLPEN ELEVATION AT BASEBALL

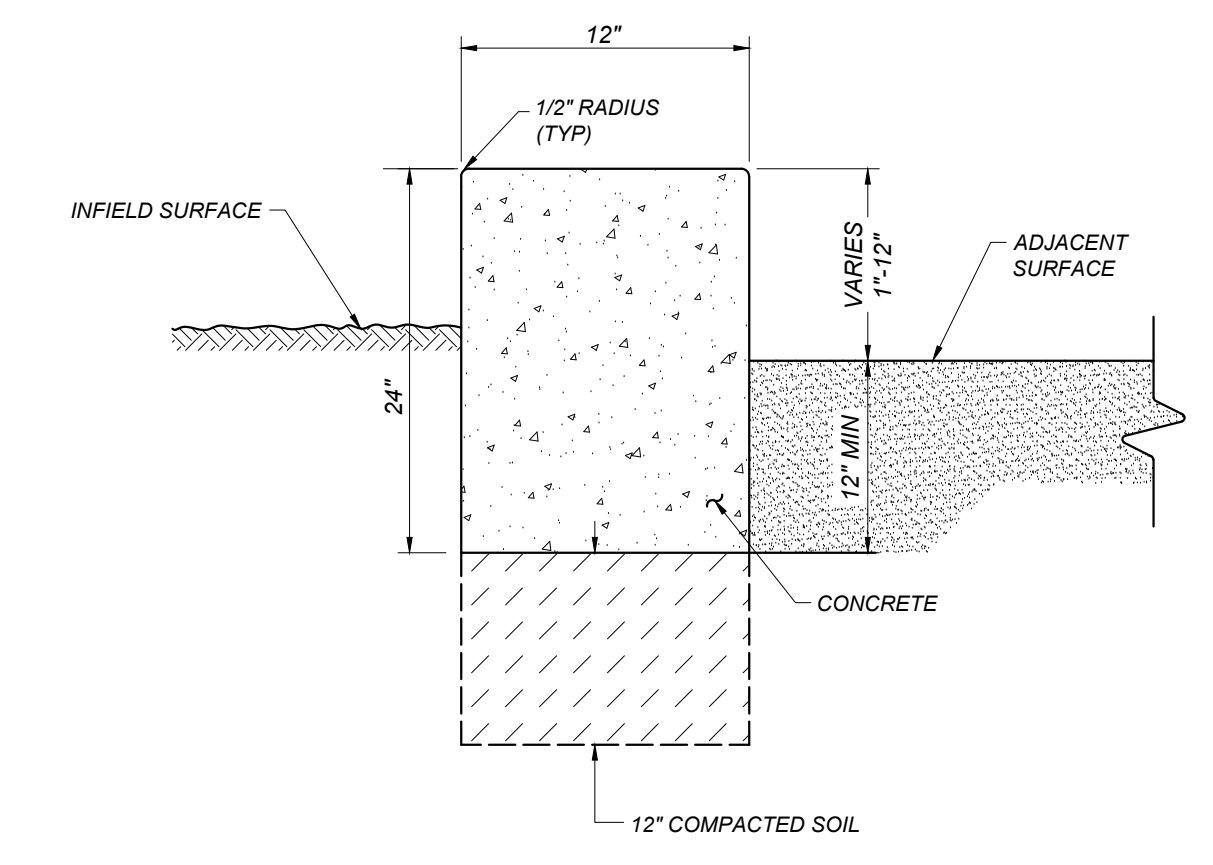

F RETAINING MOWSTRIP AT BULLPEN
SD/X404 NOT TO SCALE

DSA File No.: 15-C1
DSA Application No.: 03-122694

Agency Approval

General Notes

Blair, Church & Flynn
Consulting Engineers
461 Clovis Avenue,
Suite 200
Clovis, California 93612
Tel (559) 326-1400
Fax (559) 326-1500

Professional Engineer
Blair, Church & Flynn
No. 51218
Exp. 11/2024
STATE OF CALIFORNIA

Consultant

PORTERVILLE COLLEGE ATHLETIC COMPLEX
PHASE I
100 E COLLEGE AVE.
PORTERVILLE, CA 93257

Project

BASEBALL DUGOUT DETAILS
Drawing


Darden Architects
ARCHITECTURE
PLANNING
INTERIORS
www.dardenarchitects.com
6790 N. West Ave. • Fresno, CA 93711 • T. 559.448.8051

Licensed Architect
Darden L. Darden
No. L15988
Exp. 11/2024
STATE OF CALIFORNIA



Architect

No.	Revision/Submission	Date
1	ADDENDUM 02	01/11/2024
Revision		
Designed By:	ZH	Copyright 2024 Darden Architects
Scale:	AS NOTED	Drawn By: AH
Project Number:	2118	Checked By: JF
Date:	12/28/2023	Reviewed By: ZH


SD/X404
AD2-CX15

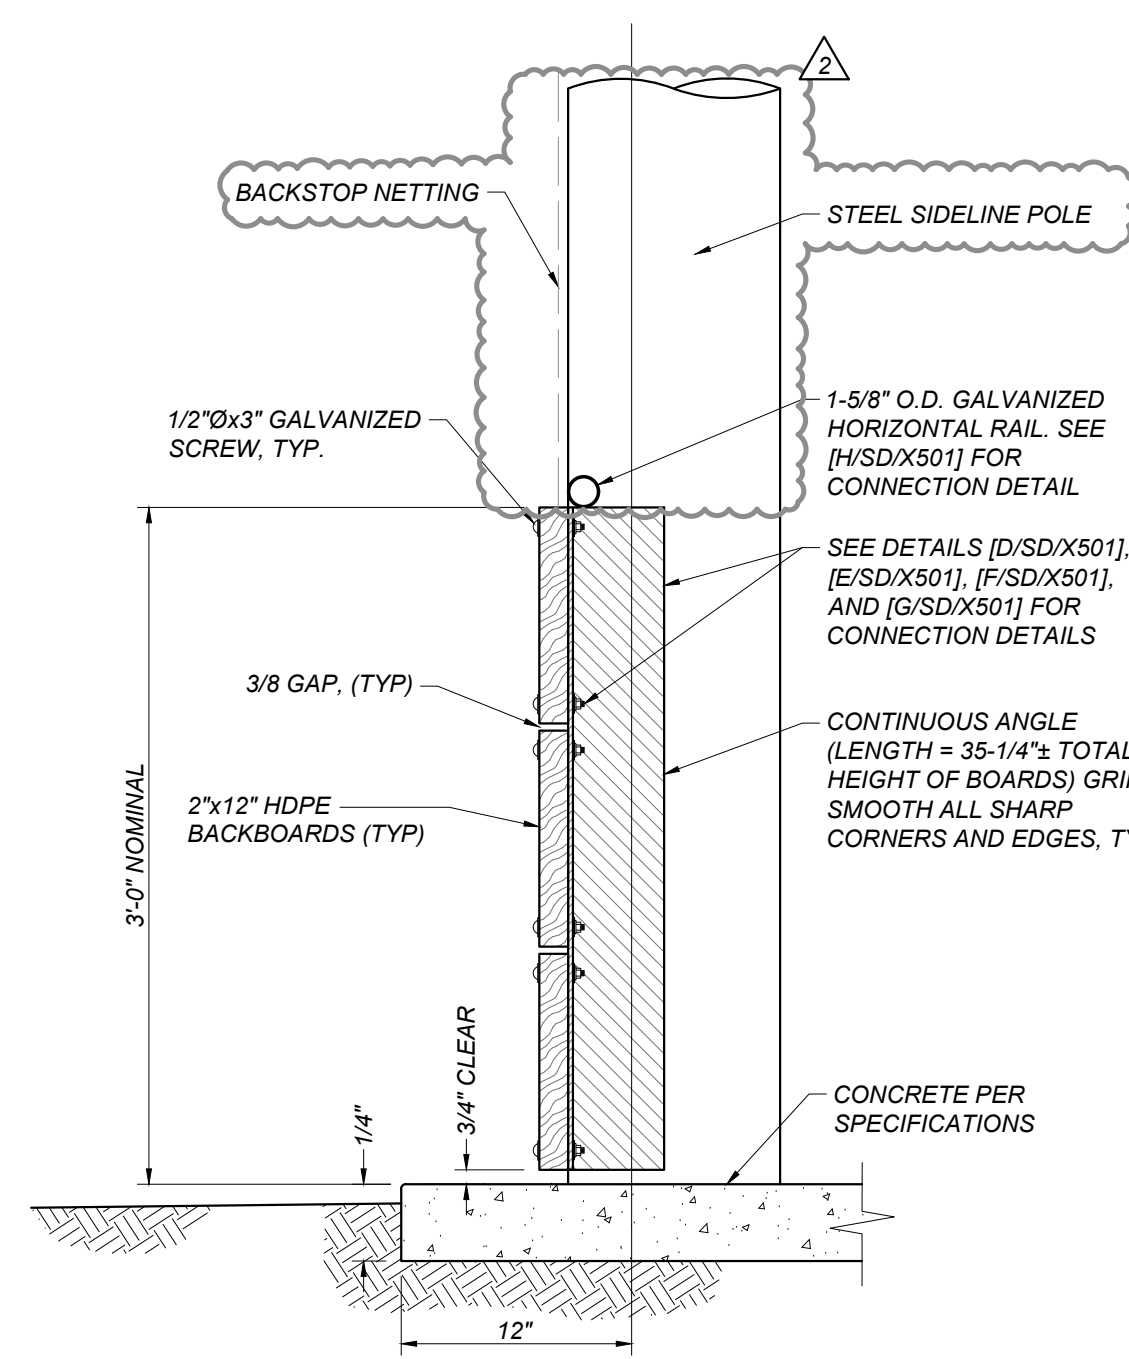


A BACKSTOP SECTION AT BOARDS
SD/X501 NOT TO SCALE

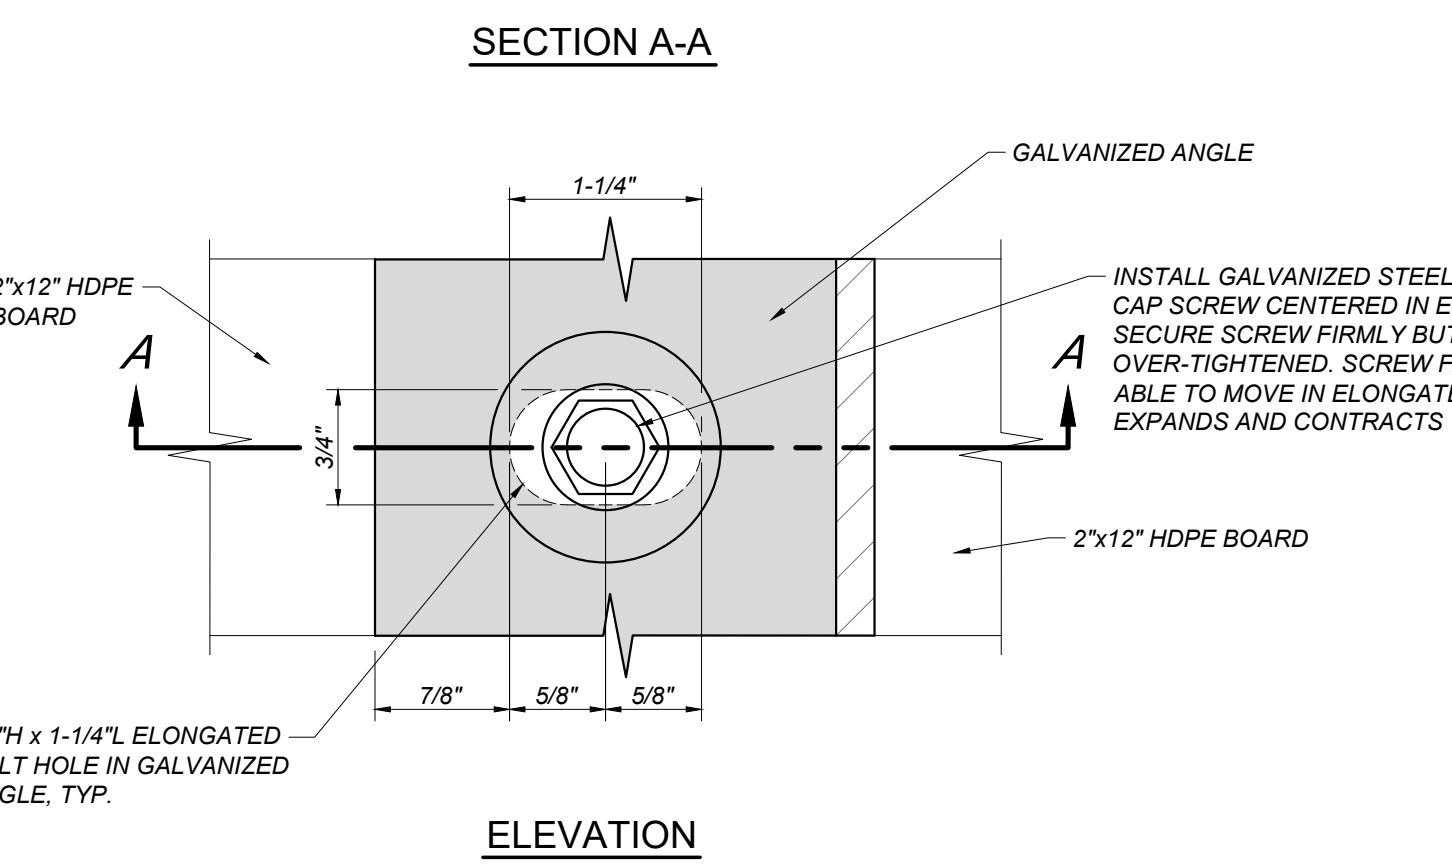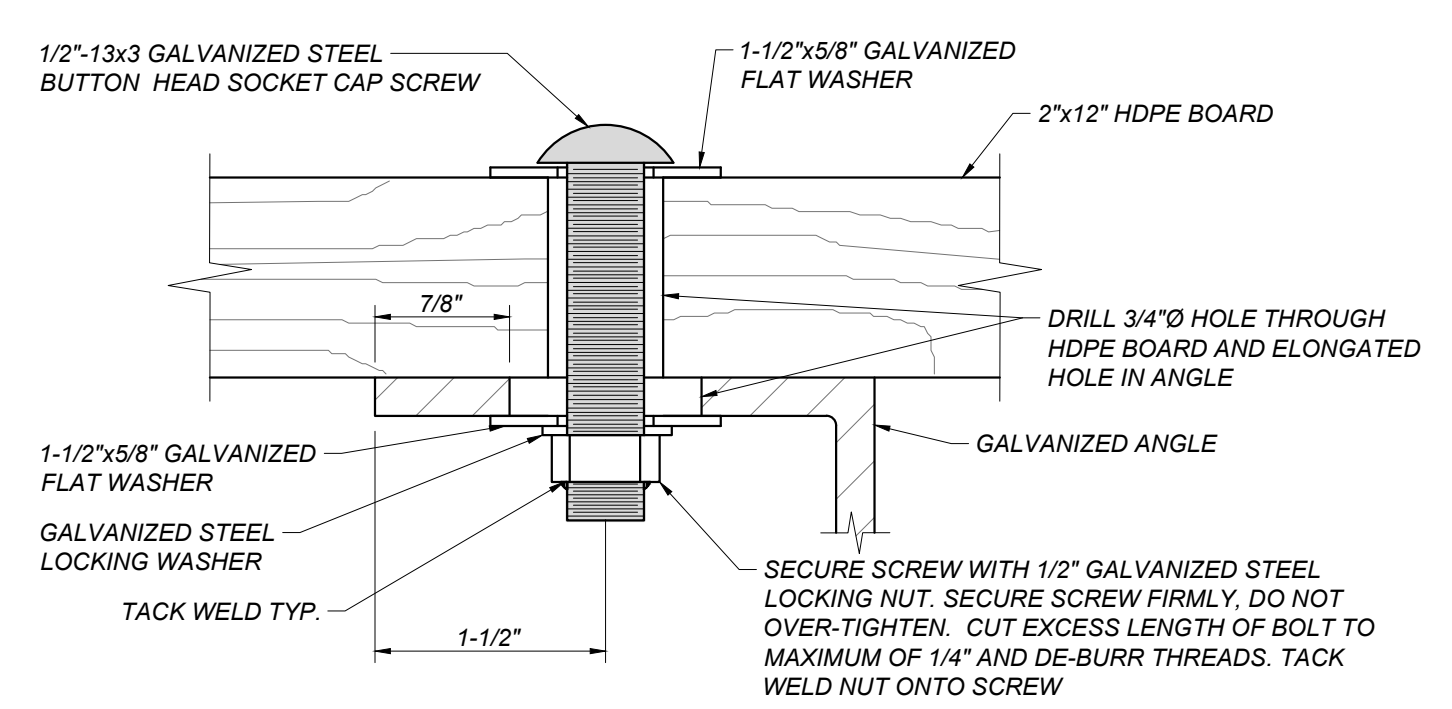


B BOARD FASTENER
SD/X501 NOT TO SCALE

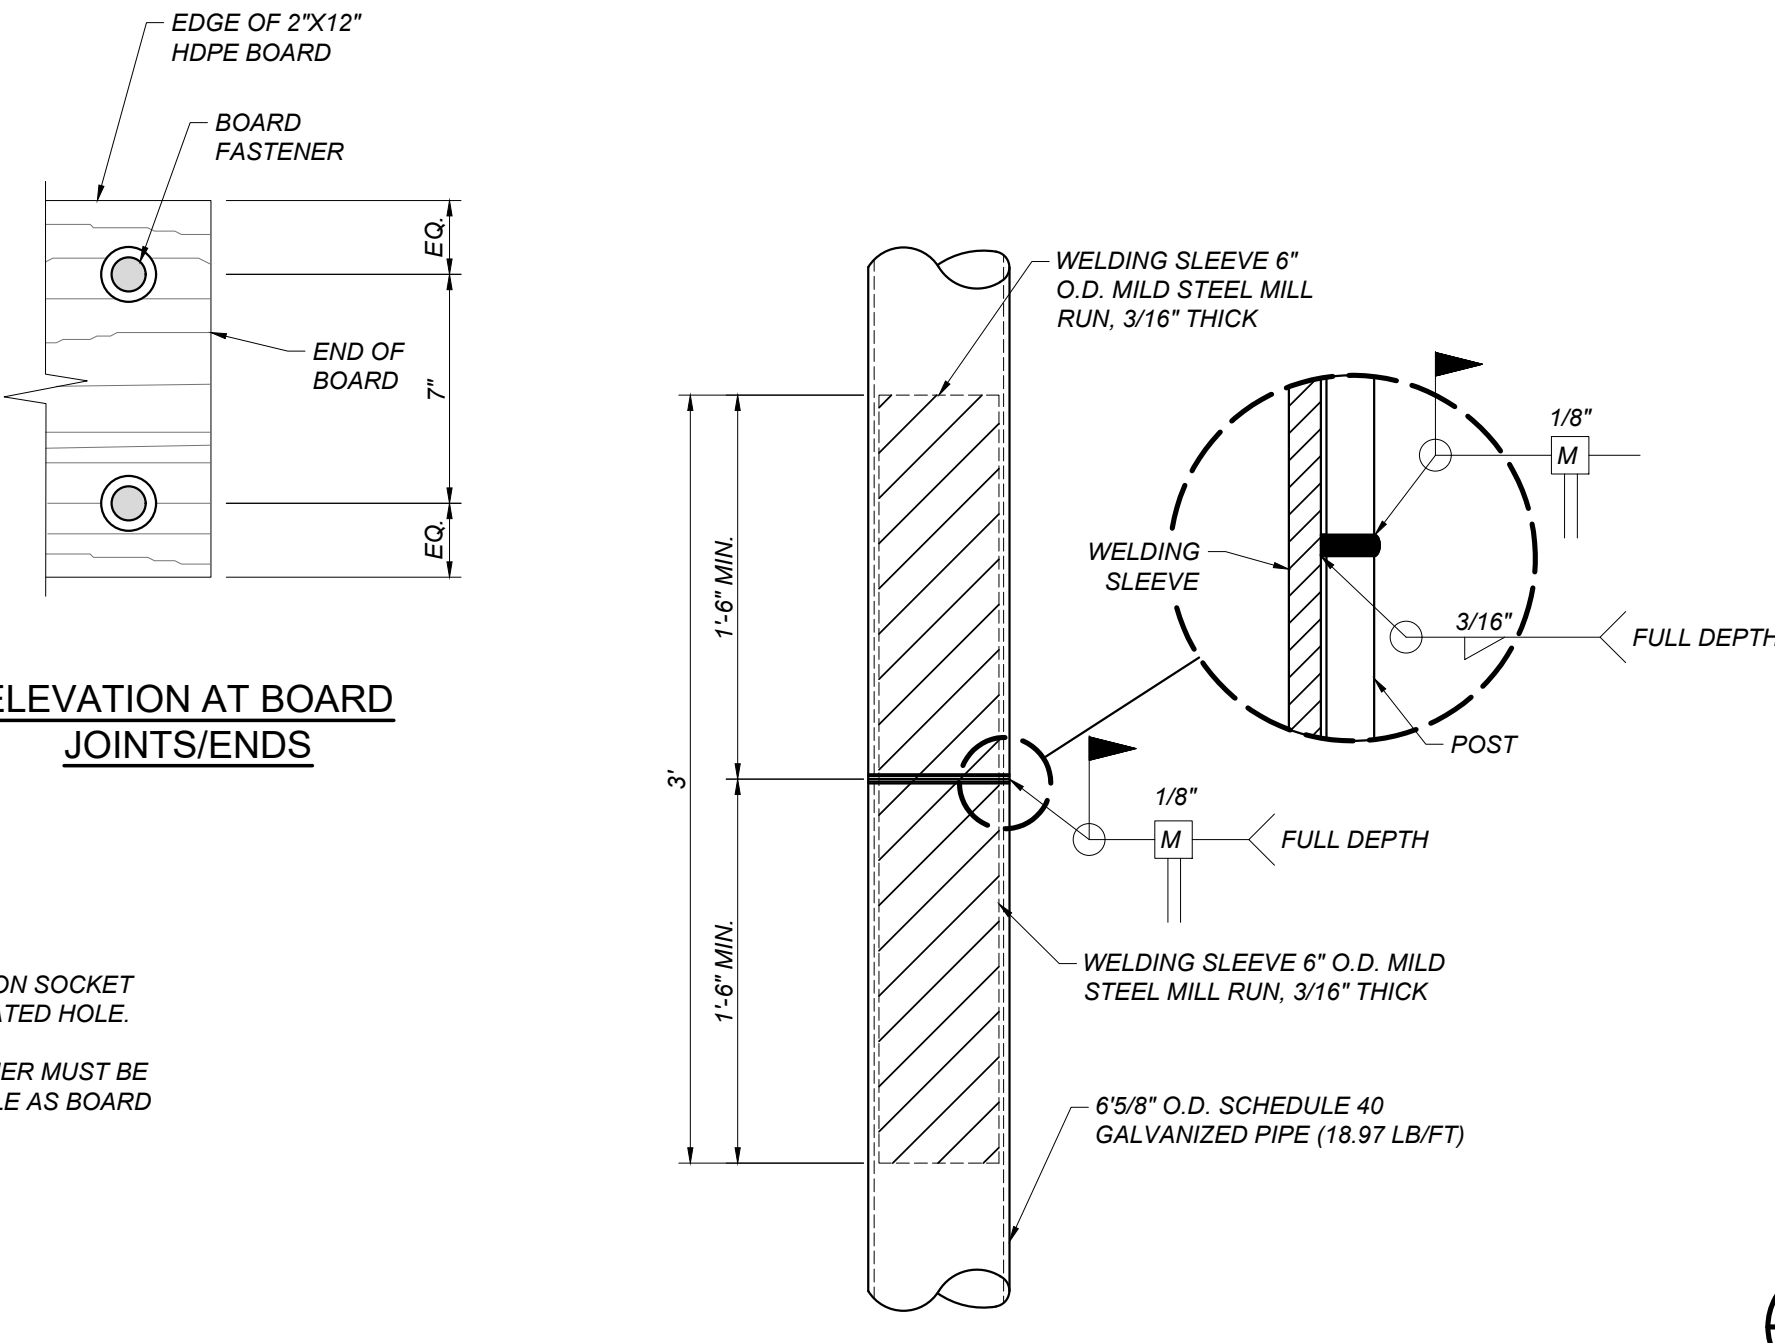


D BOARD END ATTACHMENT AT FENCE END POST
SD/X501 NOT TO SCALE

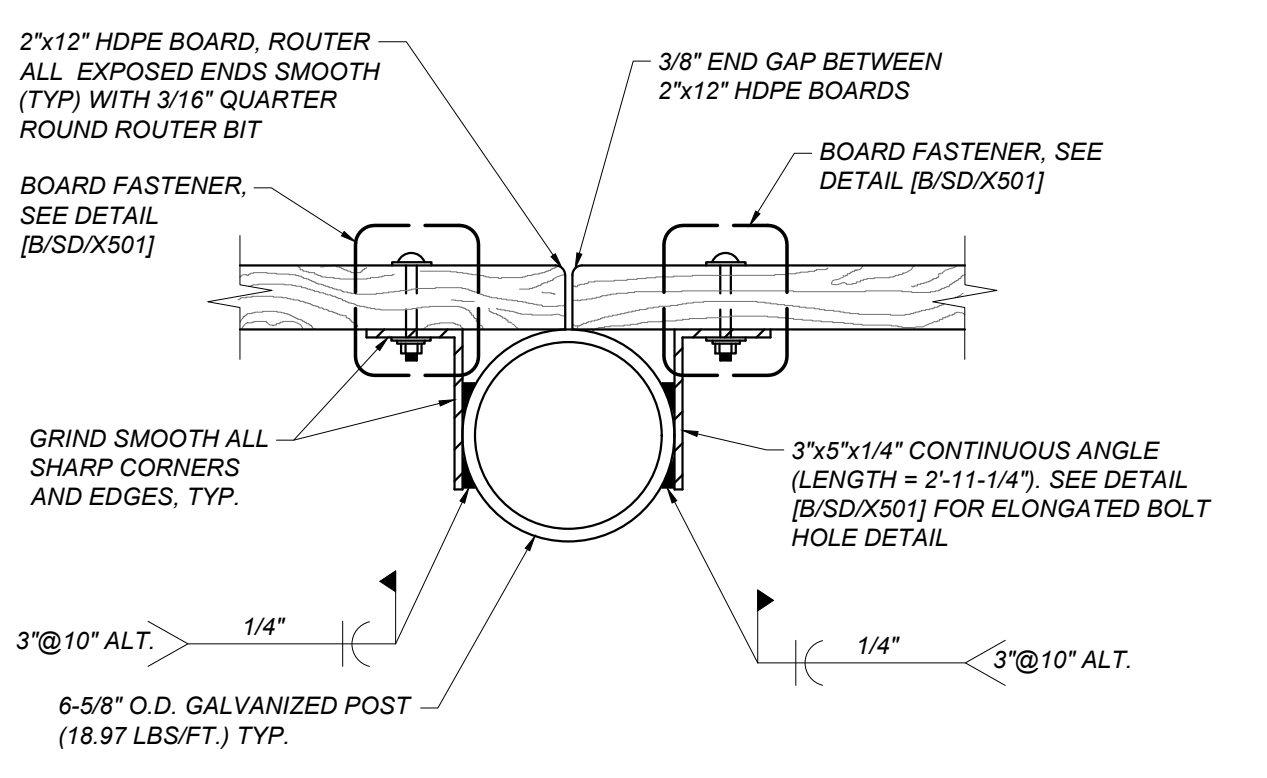


E BOARD ATTACHMENT AT BACKSTOP POST
SD/X501 NOT TO SCALE

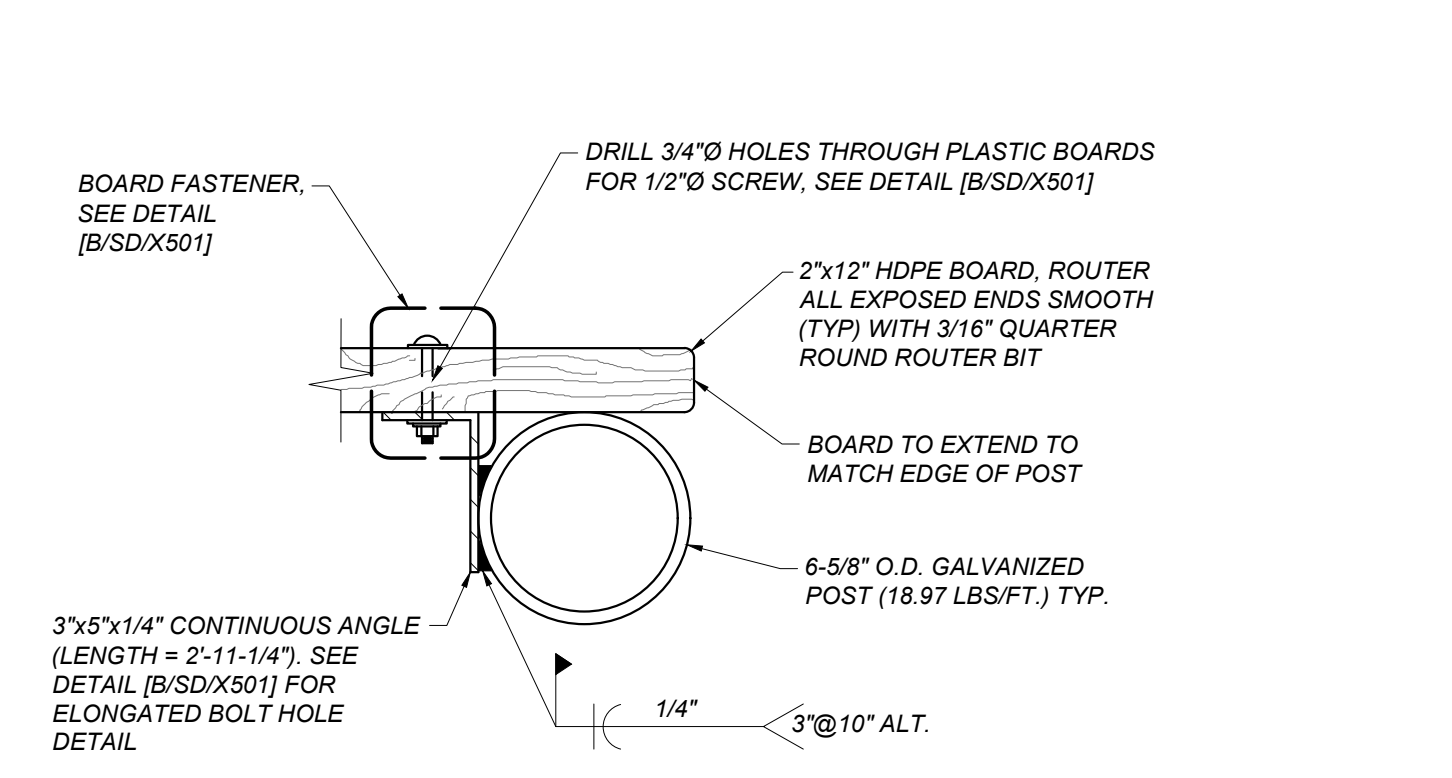

F BOARD END ATTACHMENT AT BACKSTOP POST
SD/X501 NOT TO SCALE

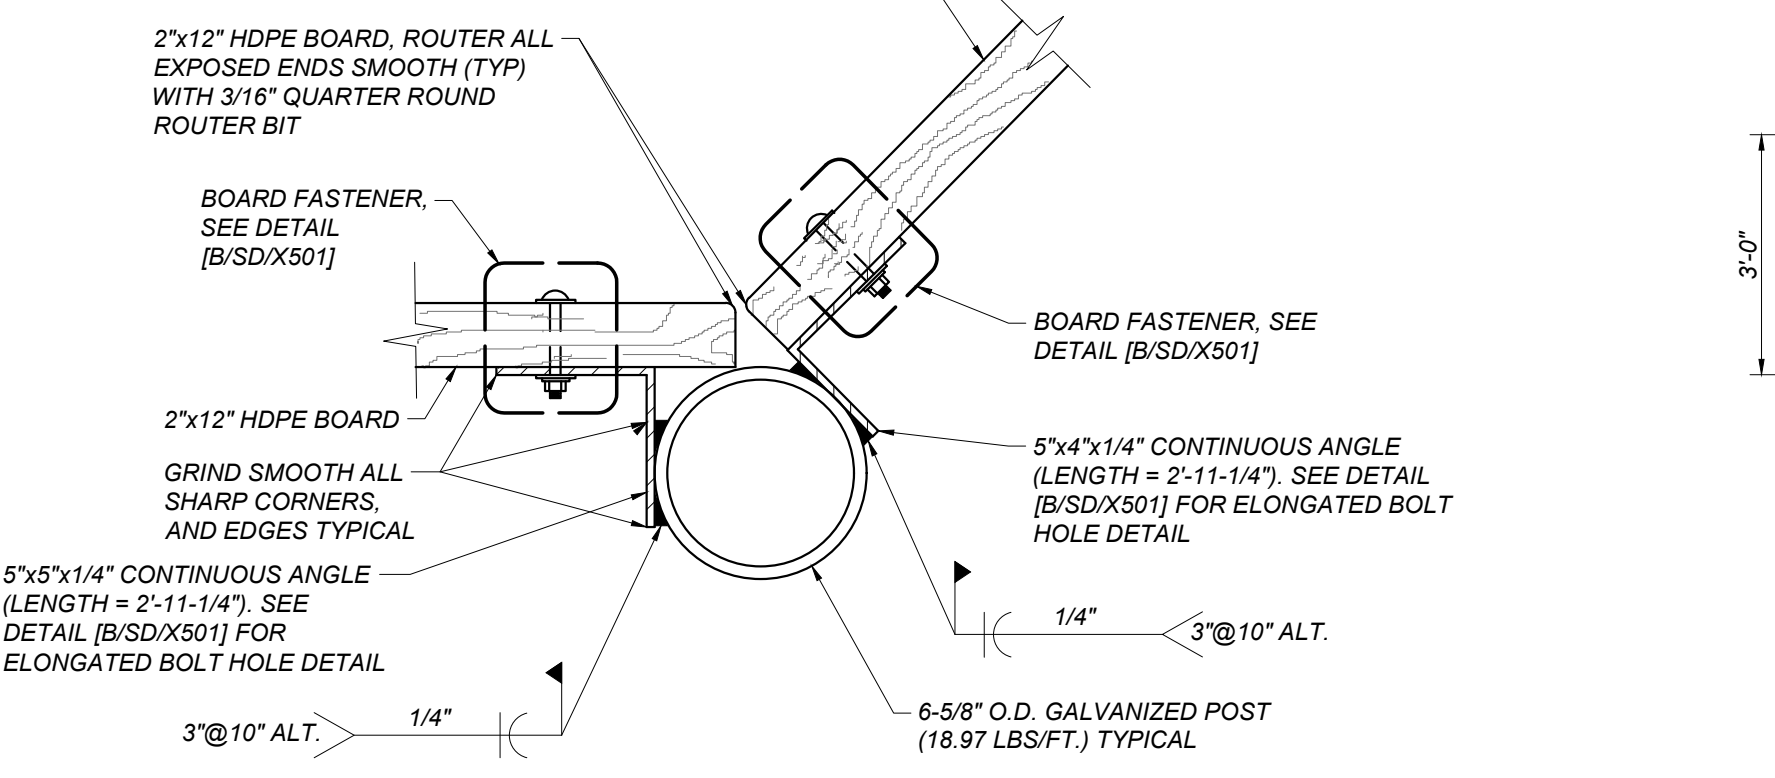

G BOARD ATTACHMENT AT BACKSTOP ANGLE POST
SD/X501 NOT TO SCALE

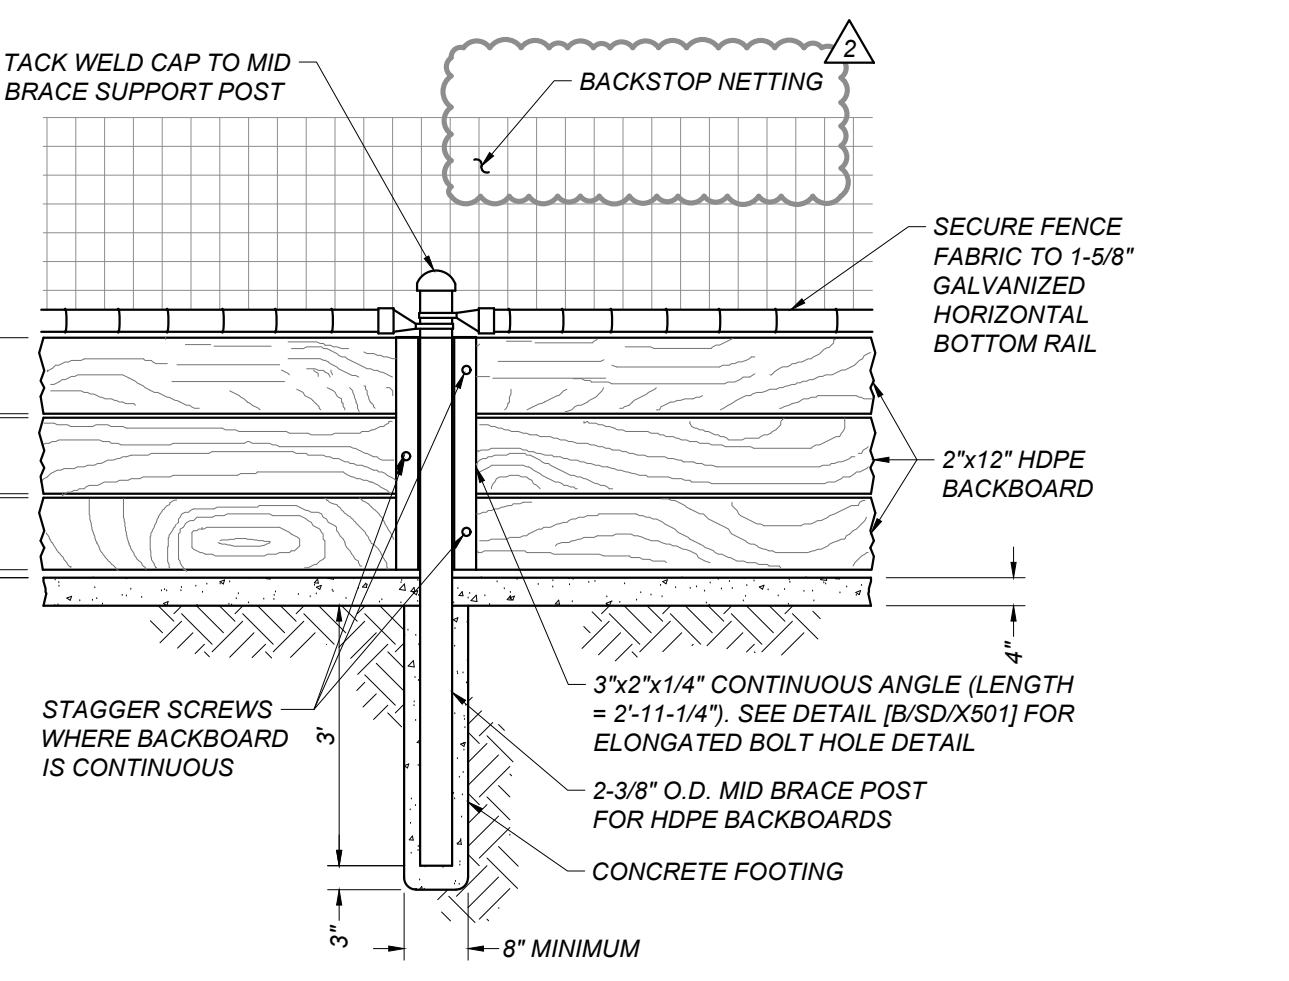

H BACKSTOP ELEVATION AT BOARDS
SD/X501 NOT TO SCALE

**DETAIL
NOT USED**

I SOFTBALL/ BASEBALL BACKSTOP WALL SECTION
SD/X501 NOT TO SCALE

DSA File No.: 15-C1
DSA Application No.: 03-122694
Agency Approval

- BACKSTOP NOTES:**
- 30 FT. HIGH FENCE SHALL BE CONSTRUCTED WITH MINIMUM 30 FT. LONG GALVANIZED STEEL POST WITH WELDING SLEEVE INSERT. ONE SLEEVE PER POST ALLOWED. SEE DETAIL [C/SD/X501] FOR WELD SLEEVE DETAIL. (POST MAY BE IN ONE PIECE.)
 - BACKBOARDS SHALL BE TANGENT WOOD HIGH DENSITY POLYETHYLENE (HDPE) RECYCLED GREEN DURAWOOD PLASTIC BOARD REPRESENTED: CONTACT STEVE ANDERSON AT TANGENT TECHNOLOGIES FOR LOCAL DISTRIBUTOR, 1001 SULLIVAN ROAD, AURORA, ILLINOIS, 60506, PHONE (630)264-1110, FAX (630)264-6881.
 - ALL SCREWS, NUTS, AND WASHERS SHALL BE GALVANIZED STEEL.
 - ALL DAMAGED GALVANIZED SURFACES AND WELDED AREAS SHALL BE CLEANED AND PAINTED WITH A MINIMUM OF TWO (2) COATS OF ZINC OXIDE PER THE REQUIREMENTS OF FEDERAL SPECIFICATION MIL-P-15145 AND TWO ALUMINUM COLOR COATS.
 - ALL STEEL ANGLES FOR BACKBOARDS TO BE GALVANIZED STEEL.
 - SEE DETAIL [C/SD/X501] FOR POST WELDING DETAILS.
 - FACE OF ALL BACKSTOPS POSTS ARE TO ALIGN WITH THE FACE OF 6-5/8" O.D. POSTS. THE CENTER OF 6-5/8" O.D. POST TO BE 9" FROM EDGE OF CONCRETE.
 - ALL EXPOSED EDGES OF GALVANIZED ANGLE IRON SHALL BE ROUNDED SMOOTH OR GRIND SMOOTH.
 - MINIMUM LENGTH OF BACKSTOP BACKBOARDS TO BE 7' OR 10' (POST TO POST). MAXIMUM LENGTH TO BE 10'.
 - PROVIDE 3/8" GAP BETWEEN HDPE BOARDS. BOARDS NOT TO BE BUTTED TOGETHER.
 - ALL CONCRETE TO BE IN CONFORMANCE WITH SPECIFICATIONS.
 - AFTER INSTALLATION, CUT END OF SCREWS SO THAT MAXIMUM EXTENSION BEYOND NUT IS NO MORE THAN 1/4".
 - DRILL 3/4" MINIMUM HOLES THROUGH PLASTIC BOARDS AND ANGLES FOR 1/2" GALVANIZED STEEL SCREWS. CONTINUOUS ANGLES SHALL HAVE ELONGATED HOLES. SEE DETAIL [B/SD/X501].
 - ALL EXPOSED ENDS OF THE BACKSTOP BACKBOARDS TO BE ROUNDED SMOOTH WITH 3/16" QUARTER ROUND ROUTER BIT.
 - TACK WELD ALL NUTS ONTO BOLTS BELOW 8' IN HEIGHT.

General Notes

Blair, Church & Flynn
Consulting Engineers
451 Clovis Avenue,
Suite 200
Clovis, California 93612
Tel (559) 326-1400 Fax (559) 326-1500

Professional Engineer
D. J. Flynn
No. 51218
CIVIL
STATE OF CALIFORNIA

Consultant

PORTERVILLE COLLEGE ATHLETIC COMPLEX
PHASE I
100 E COLLEGE AVE.
PORTERVILLE, CA 93257

Project

BACKSTOP DETAILS

Drawing

darden architects
ARCHITECTURE
PLANNING
INTERIORS
www.dardenarchitects.com
6790 N. West Ave. • Fresno, CA 93711 • T. 559.448.8051

Licensed Architect
Robert L. Pettibone
No. L15986
Exp. 11-2025
STATE OF CALIFORNIA

Architect




No.	Revision/Submission	Date
1	ADDENDUM 02	01/11/2024
Revision		
Designed By:	ZH	Copyright 2024 Darden Architects
Scale:	AS NOTED	Drawn By: AH
Project Number:	2118	Checked By: JF
Date:	12/28/2023	Reviewed By: ZH

**SD/X501
AD2-CX16**

DSA File No.: 15-C1


DSA Application No.: 03-122694

Agency Approval

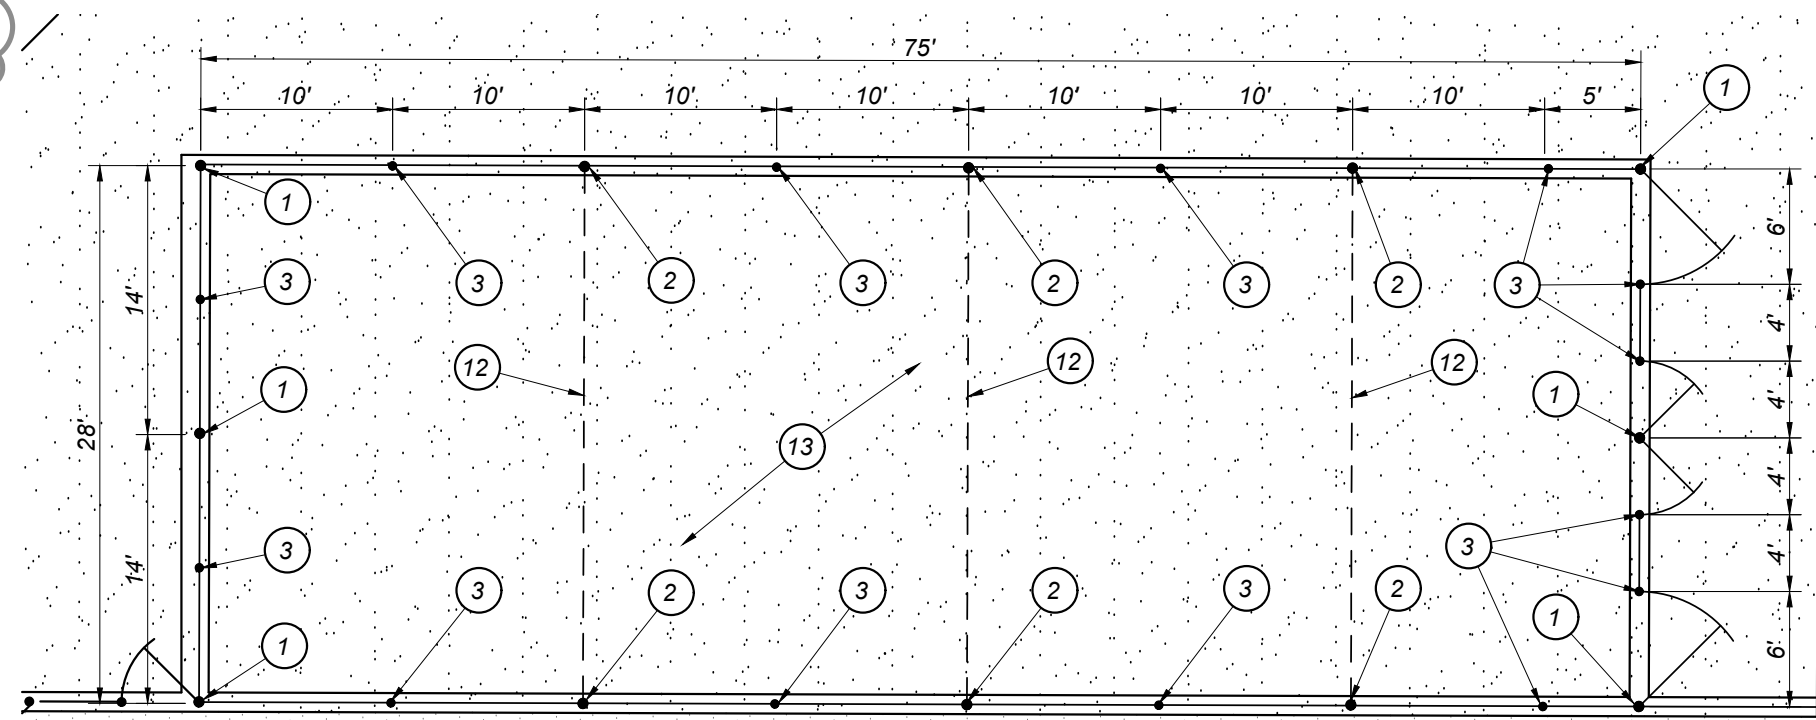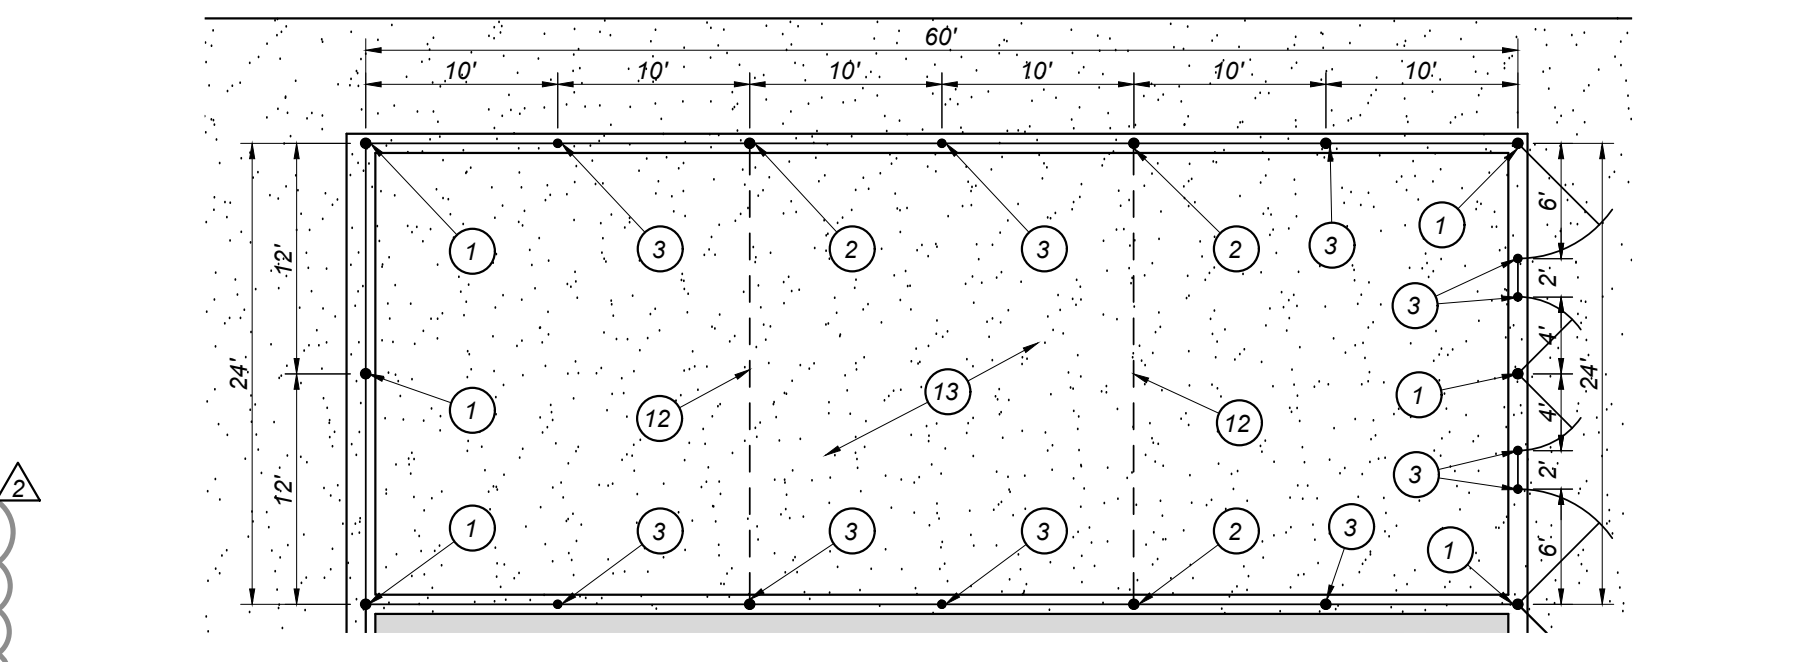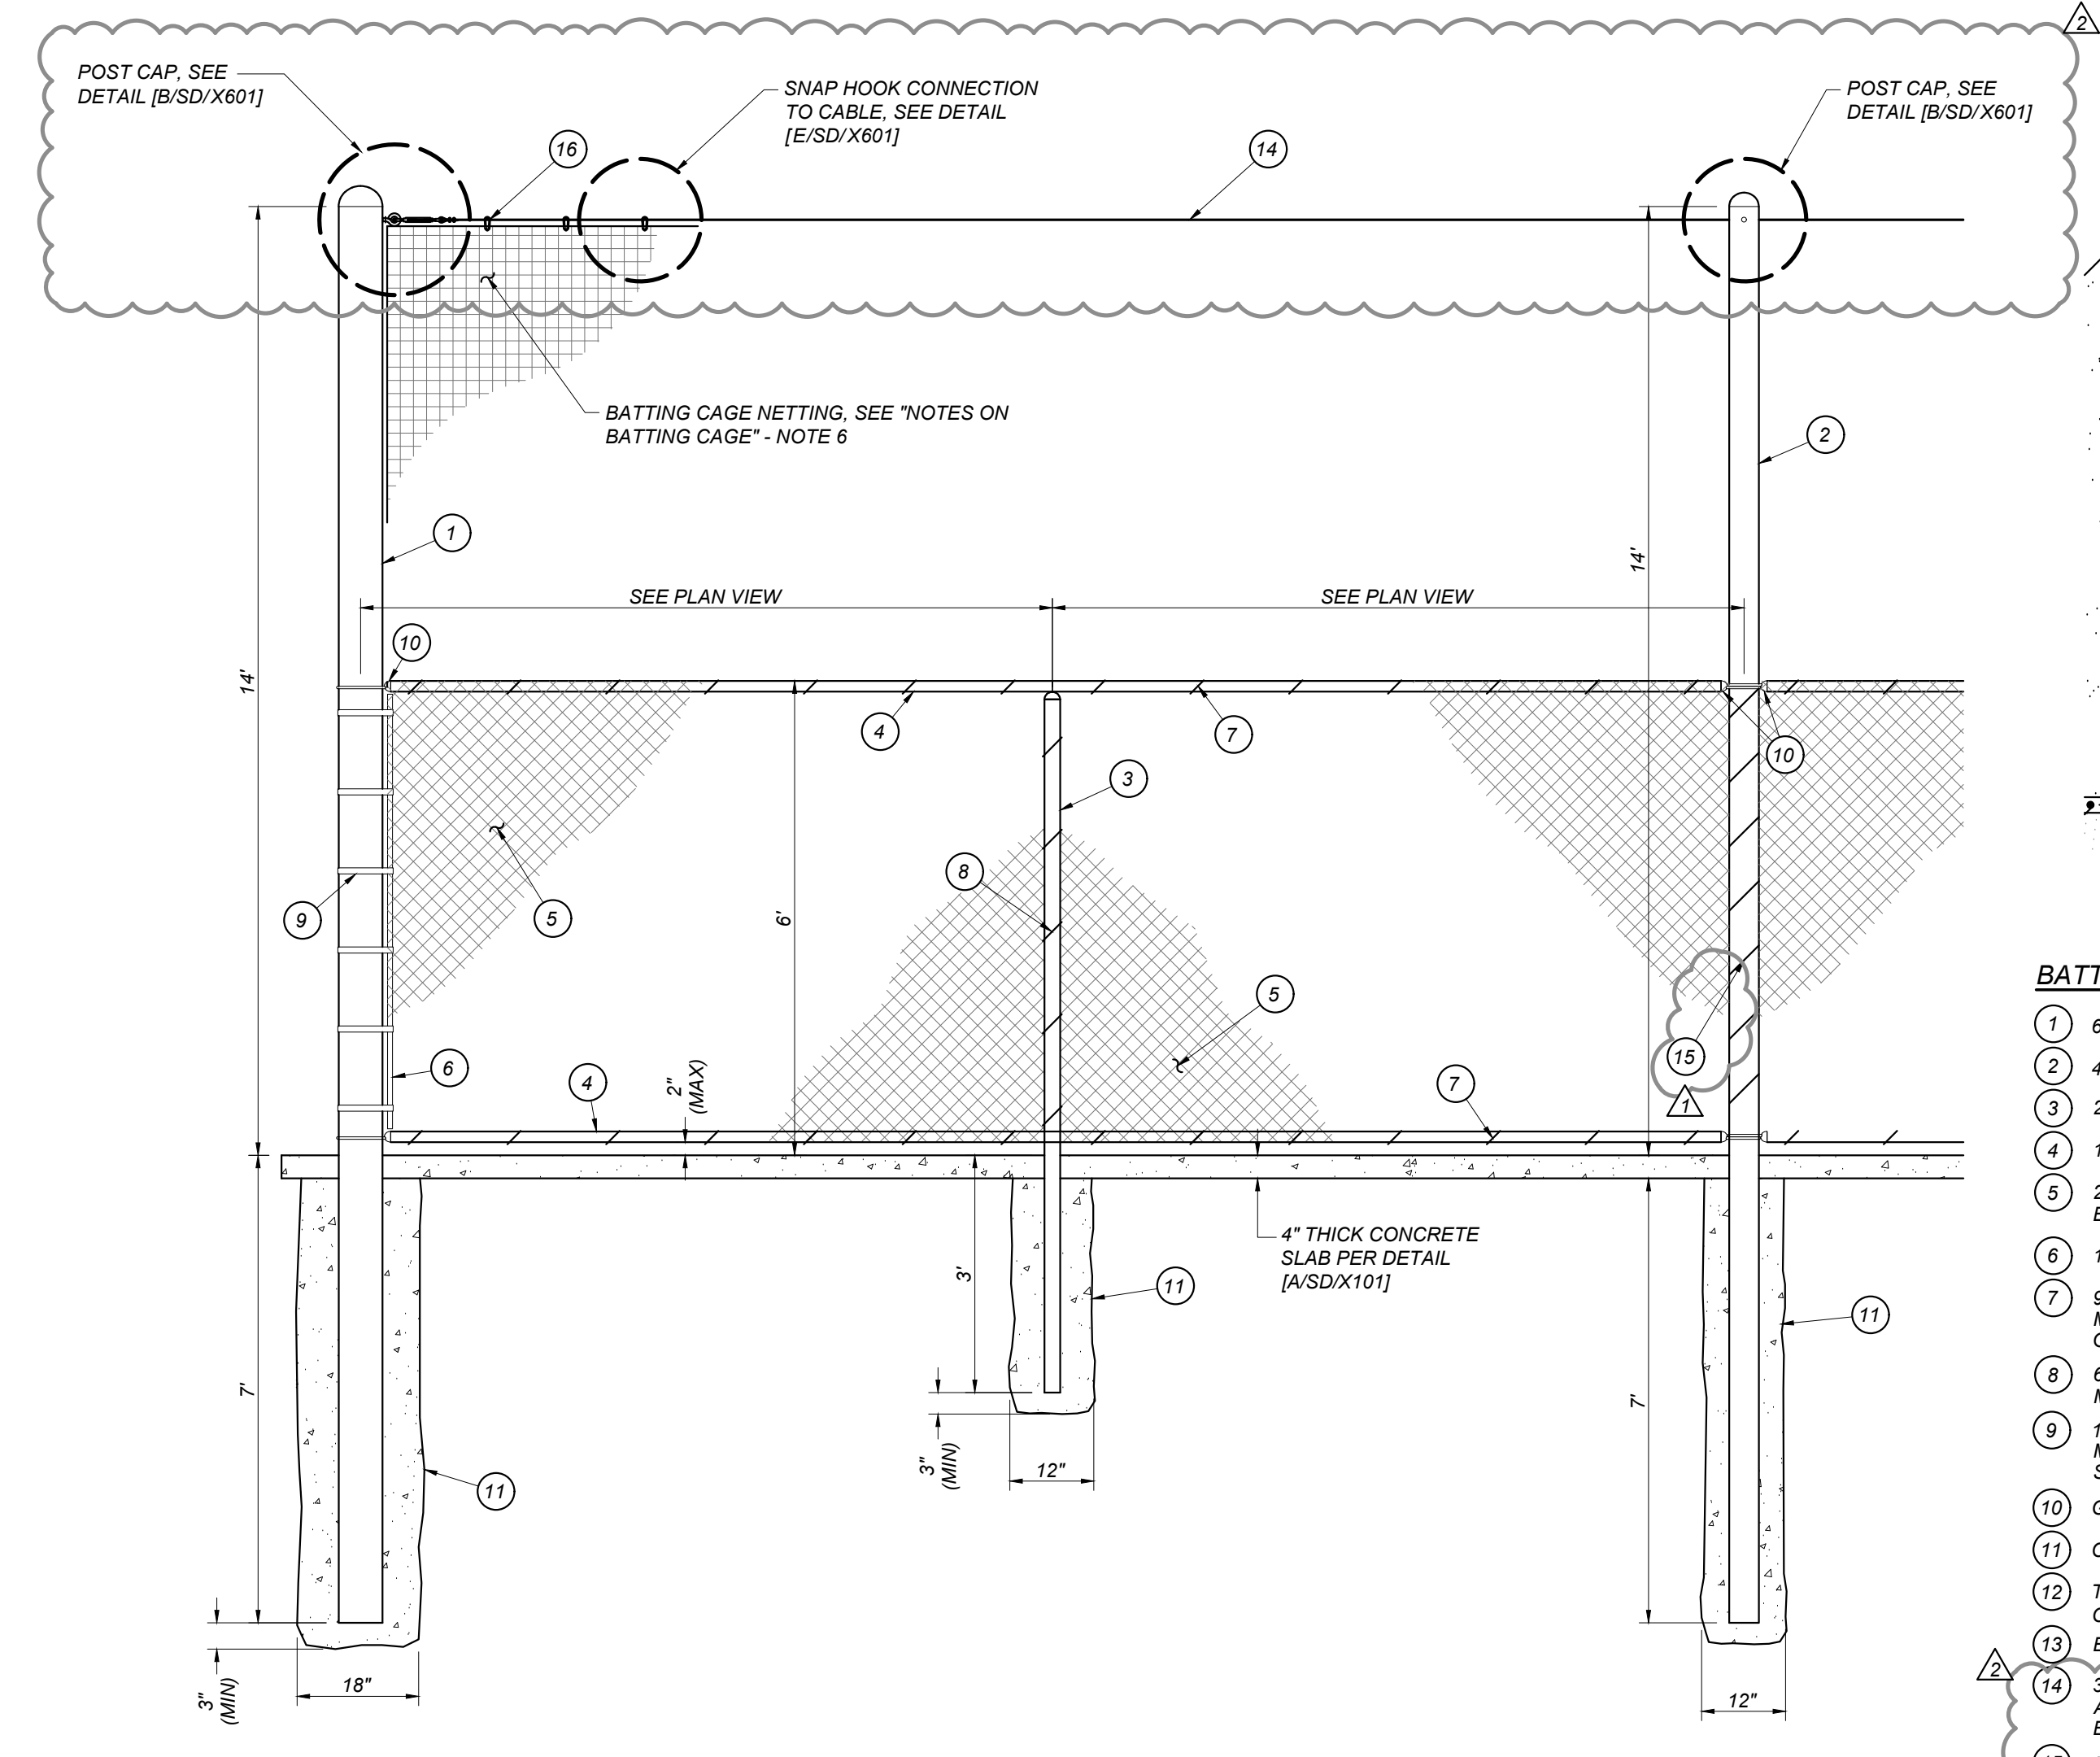


- BATting CAGE LEGEND**
- 1 6-5/8" O.D. GALVANIZED STEEL NET CORNER POST (18.99 LB/FT)
 - 2 4-1/2" O.D. GALVANIZED STEEL NET LINE POST (10.79 LB/FT)
 - 3 2-3/8" O.D. GALVANIZED STEEL LINE POST (3.65 LB/FT)
 - 4 1-5/8" O.D. GALVANIZED STEEL HORIZONTAL RAIL (2.27 LB/FT)
 - 5 2" x 2" MESH x 9 GAUGE GALVANIZED FENCE FABRIC WITH KNUCKLED TOP AND BOTTOM SELVAGE. FENCE FABRIC TO BE GALVANIZED BEFORE WEAVING (GBW).
 - 6 1/4" x 3/4" GALVANIZED STEEL STRETCHER BAR
 - 7 9 GAUGE (0.148" DIA) GALVANIZED STEEL TIE WIRES OR HOG RINGS AT 15" MAXIMUM SPACING. MINIMUM OF 8 TIE WIRES PER EACH 10' HORIZONTAL RAIL OR TENSION WIRE.
 - 8 6 GAUGE (0.192" DIA) GALVANIZED STEEL POST CLIPS AT 14" MAXIMUM SPACING. MINIMUM 5 POST CLIPS FOR EACH 6' POST.
 - 9 1/8" THICK GALVANIZED STEEL STRETCHER BAR TENSION BAND AT 12" MAXIMUM SPACING. MINIMUM OF 6 TENSION BANDS FOR EACH 6' POST SECTION AND 12 TENSION BANDS FOR EACH 12' POST SECTION.
 - 10 GALVANIZED RAIL ENDS.
 - 11 CONCRETE FOOTING, TYPICAL.
 - 12 TRANSVERSE CROSS CABLES TO BE PROVIDED UNDERNEATH LONGITUDINAL CABLES. SEE NOTE 5.
 - 13 BATting CAGE SURFACING, SEE NOTES 7 & 8.
 - 14 3/8" GALVANIZED WIRE ROPE WITH GALVANIZED WIRE ROPE CLIPS, POST TO POST, ALL DIRECTIONS. PROVIDE GALVANIZED TURN BUCKLE FOR CABLE TENSIONING AT EACH CABLE RUN (2 MINIMUM RUNS AND TURNBUCKLE)
 - 15 9 GAUGE (0.148") GALVANIZED STEEL TIE WIRES AT 15" MAXIMUM SPACING
 - 16 2-3/4" 1000LB MINIMUM BREAK STRENGTH SNAP HOOK, 24" MINIMUM SPACING BETWEEN SNAPHOOKS

- NOTES ON BATting CAGE**
- 1 ALL AREAS AFFECTED BY WELDING, TRIMMED ENDS OF BOLTS, STRETCHER BARS, OR ANY EXPOSED STEEL SHALL BE PAINTED (GALVANIZED) PER CONTRACT SPECIFICATIONS.
 - 2 PROVIDE GATE HOLDBACK FOR EACH GATE. LOCATE HOLDBACK IN FENCE MOWSTRIP UNLESS OTHERWISE NOTED.
 - 3 SEE SITE AND DIMENSION PLAN FOR THE FOLLOWING:
 - DIMENSIONAL LAYOUT OF CHAIN LINK FENCING AND GATES
 - GATE WIDTHS
 - LOCATIONS AND DETAILS OF ACCESSIBLE GATE HARDWARE AND STEEL PLATES
 - 4 INSTALL EYE BOLTS ON THE INSIDE OF NET LINE POSTS.
 - 5 WHERE BATting CAGES ARE SIDE-TO-SIDE, PROVIDE CROSS CABLES TRANSVERSE UNDERNEATH THE CENTER LONGITUDINAL CABLE.
 - 6 BATting CAGE PROVIDED BY CONTRACTOR AND INSTALLED PER MANUFACTURER'S RECOMMENDATIONS - SEE SPECIFICATIONS.
 - 7 IF THE SYNTHETIC TURF BID ALTERNATE IS ACCEPTED, REFER TO DETAIL [U/S/D/X101] FOR BATting CAGE SURFACING.
 - 8 IF THE SYNTHETIC TURF BID ALTERNATE IS REJECTED, REFER TO DETAIL [U/S/D/X101] FOR BASE BID BATting CAGE SURFACING.


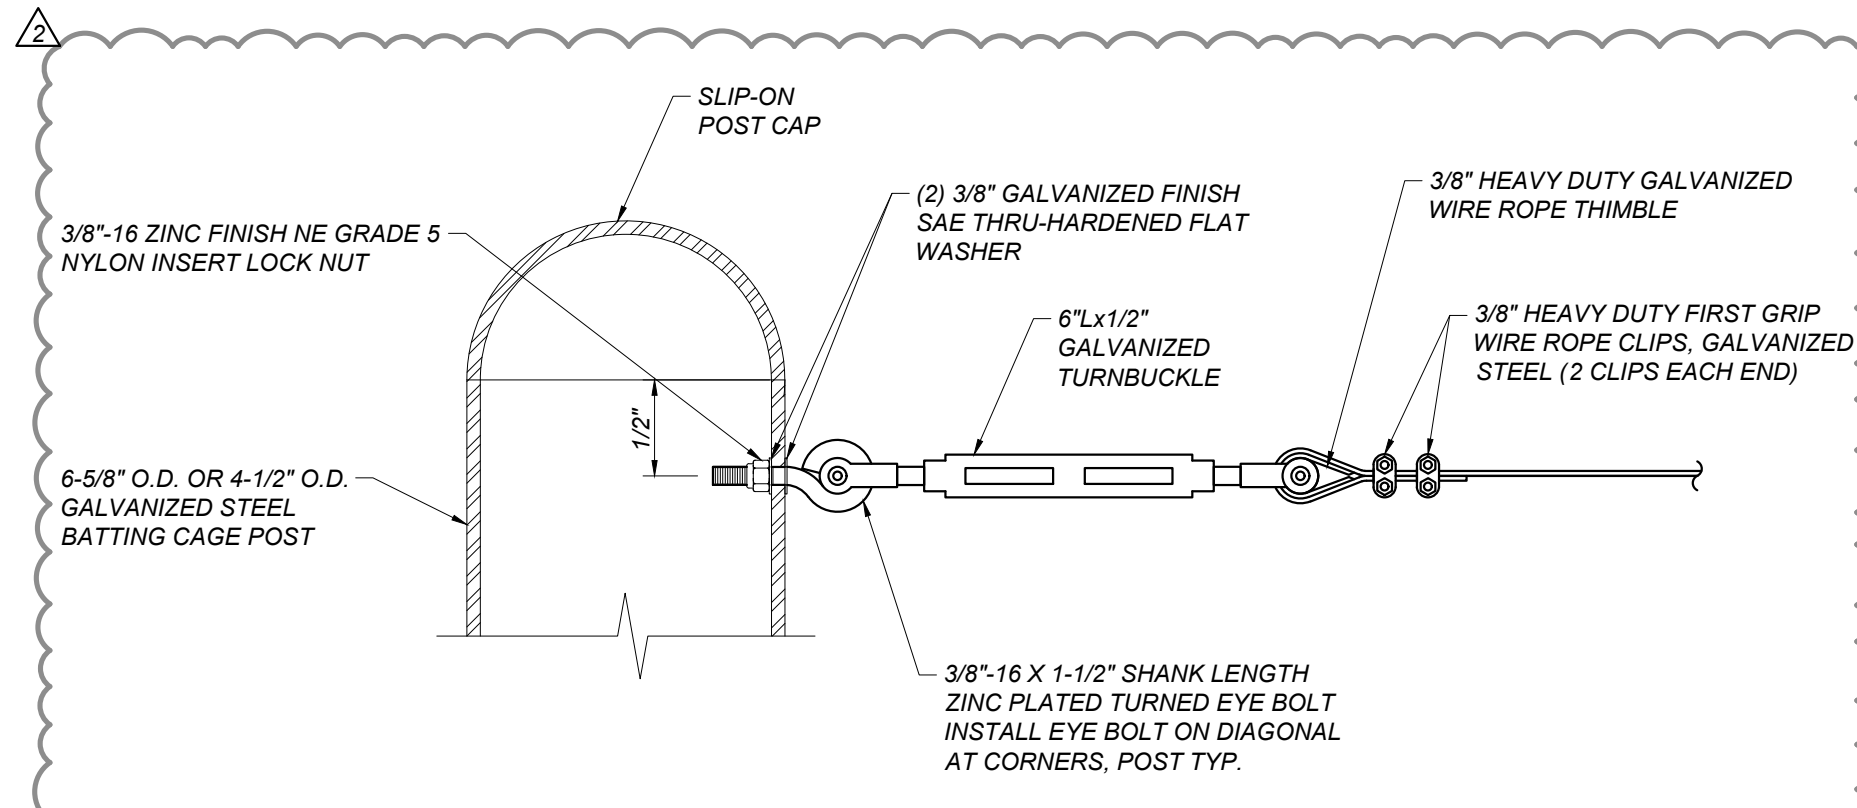


B WIRE EYE BOLT
SD/X601 NOT TO SCALE

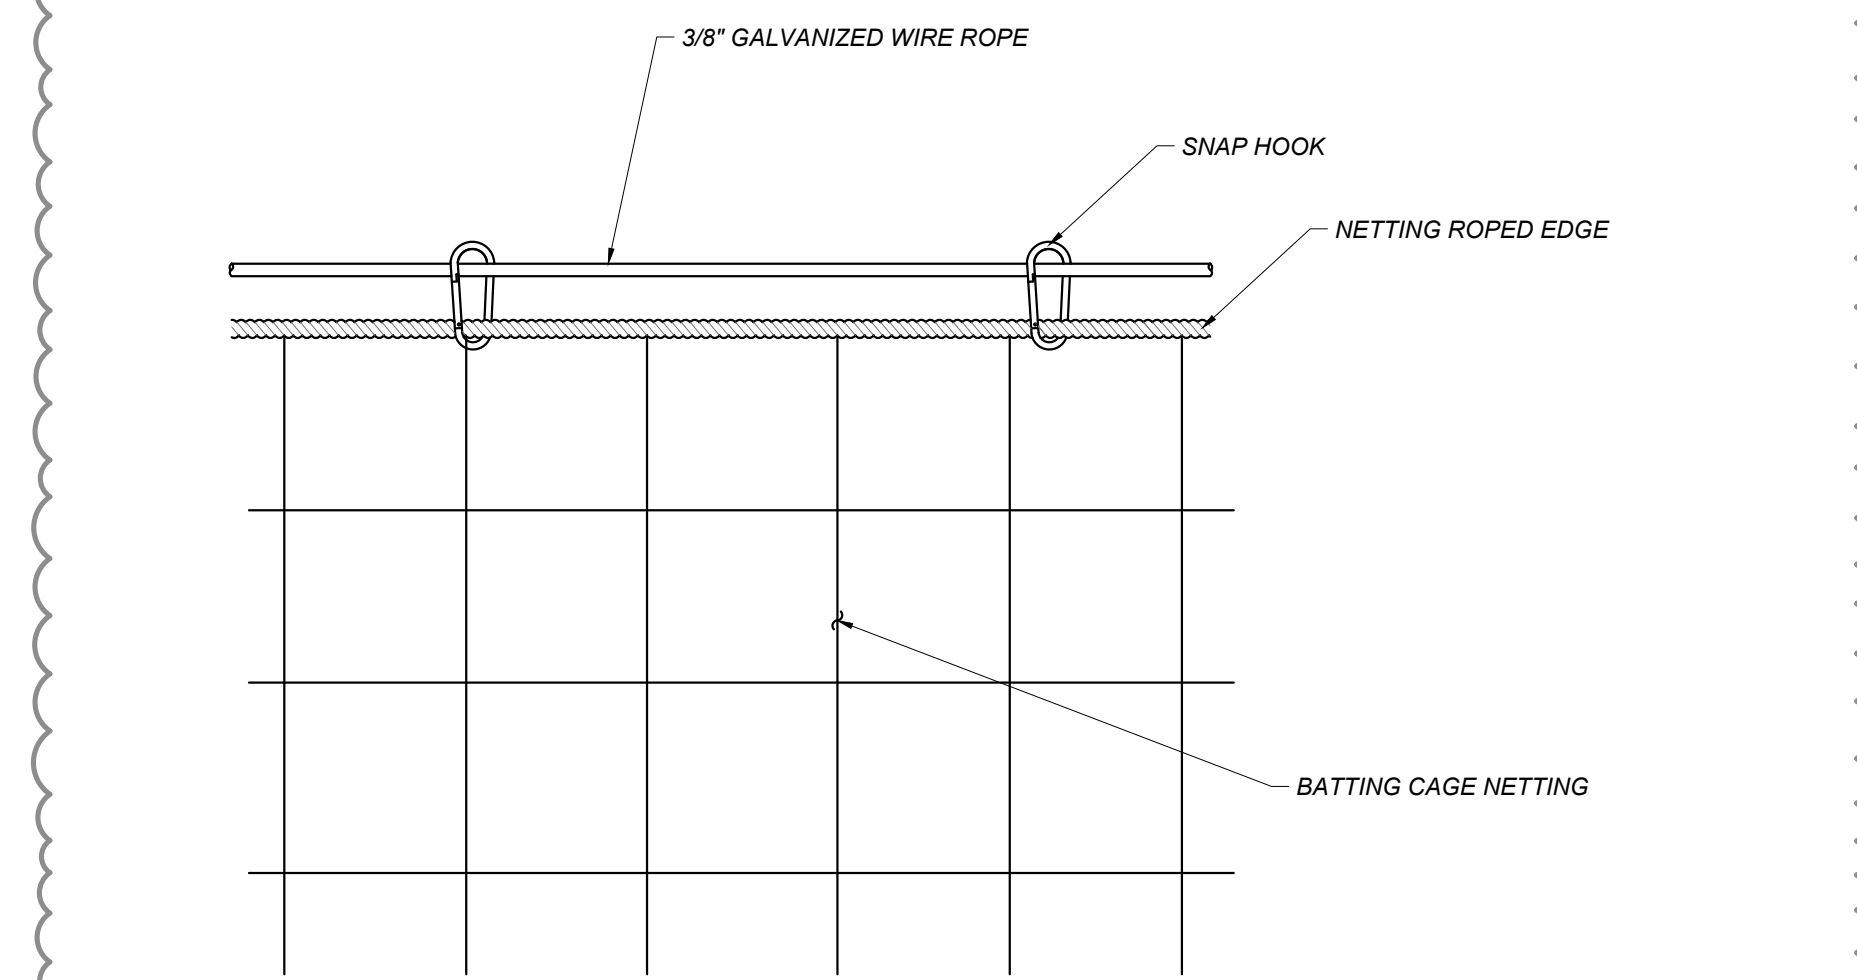


E SNAP HOOK CONNECTION TO CABLE
SD/X601 NOT TO SCALE


A BATting CAGE SOFTBALL AND BASEBALL
SD/X601 NOTE: THIS DETAIL IS EXEMPT FROM DSA REVIEW PER DSA IR-A22 APPENDIX ITEM 23 AND IS NOT PART OF THIS DSA APPROVAL

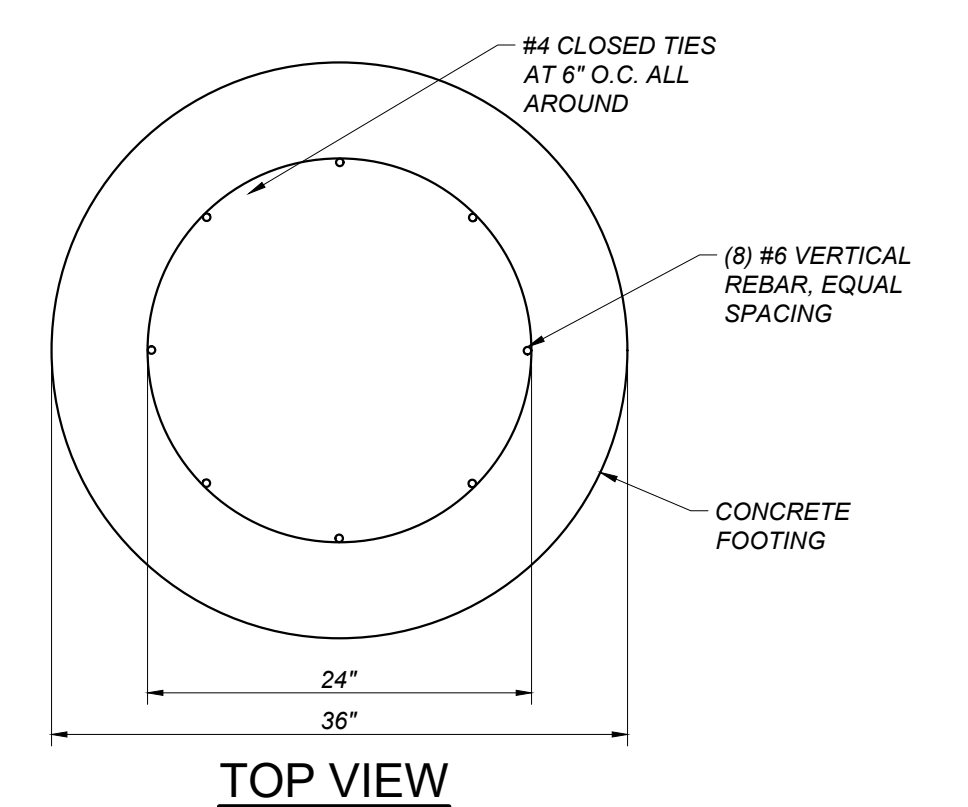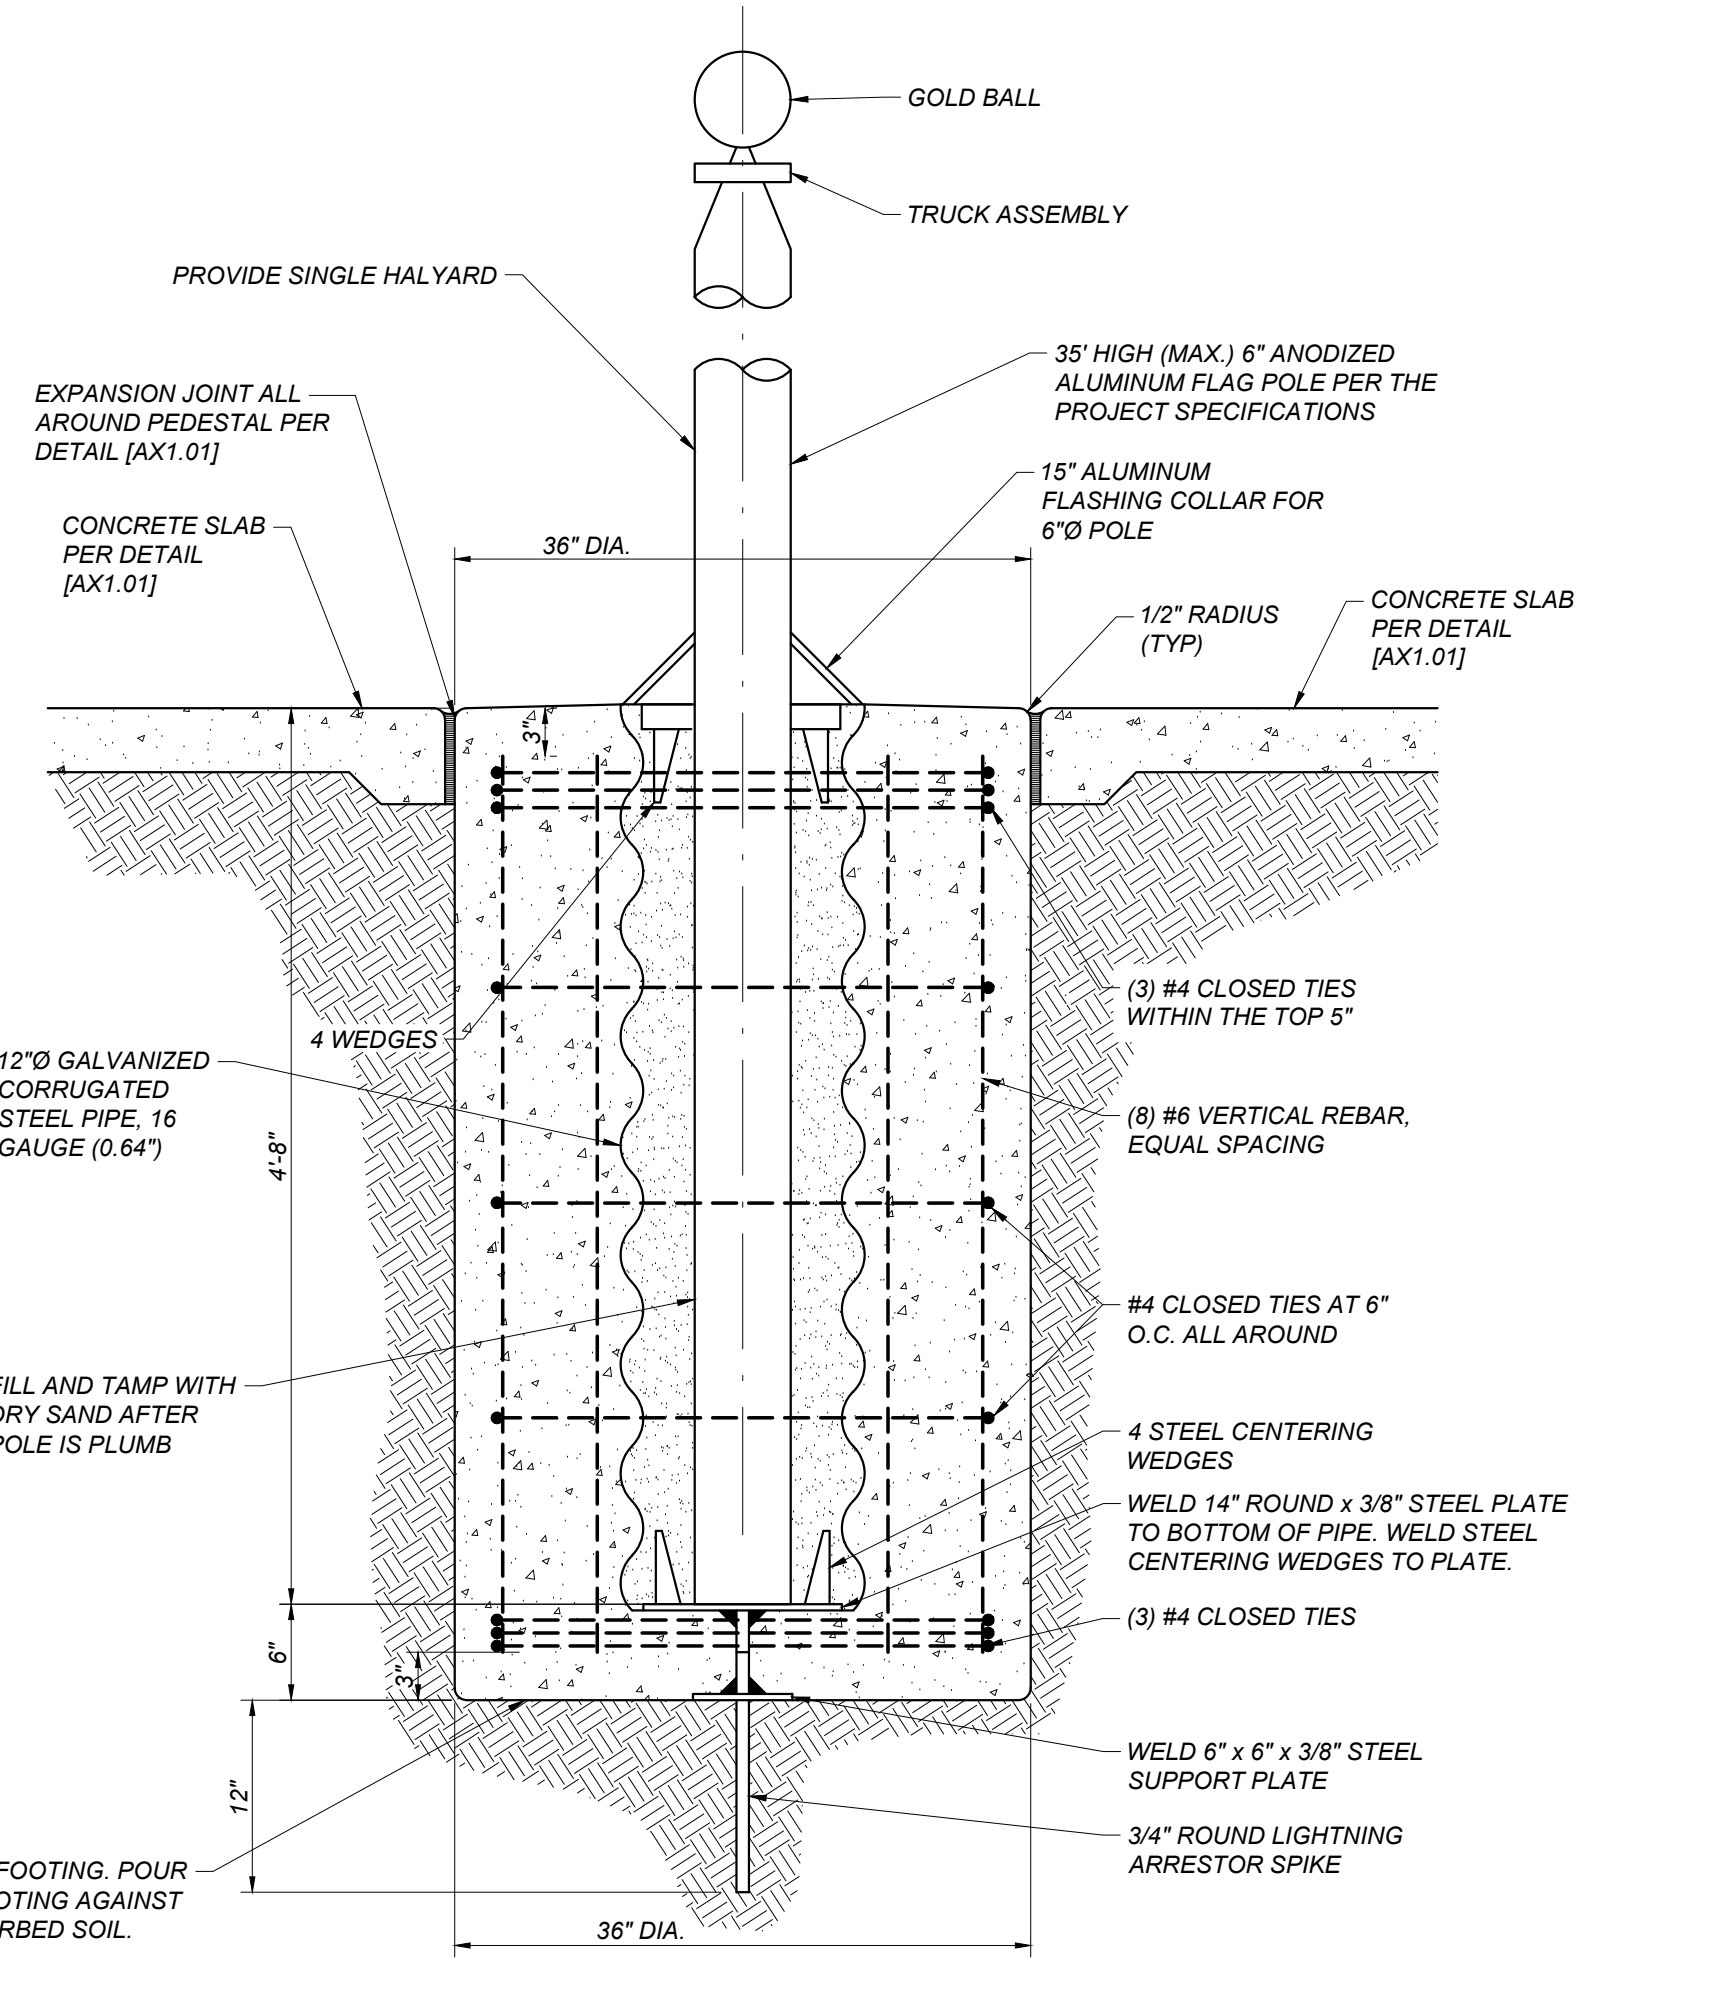

C FLAG POLE DETAIL
SD/X601 NOTE: THIS DETAIL IS EXEMPT FROM DSA REVIEW PER DSA IR-A22 APPENDIX ITEM 1 AND IS NOT PART OF THIS DSA APPROVAL

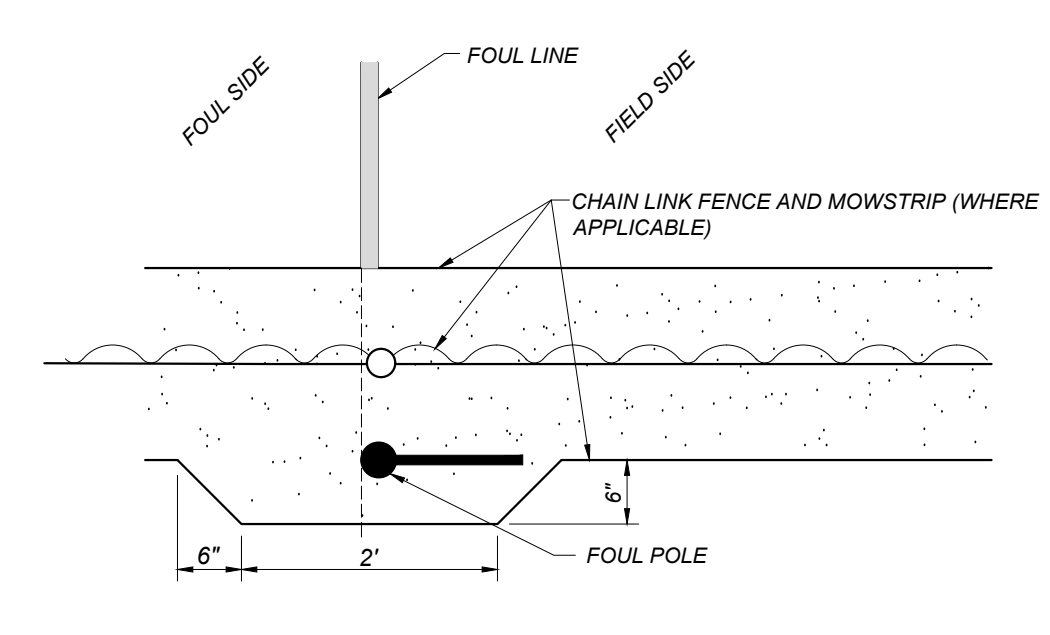

D FOUL LINE POLE
SD/X601 NOTE: THIS DETAIL IS EXEMPT FROM DSA REVIEW PER DSA IR-A22 APPENDIX ITEM 1 AND IS NOT PART OF THIS DSA APPROVAL

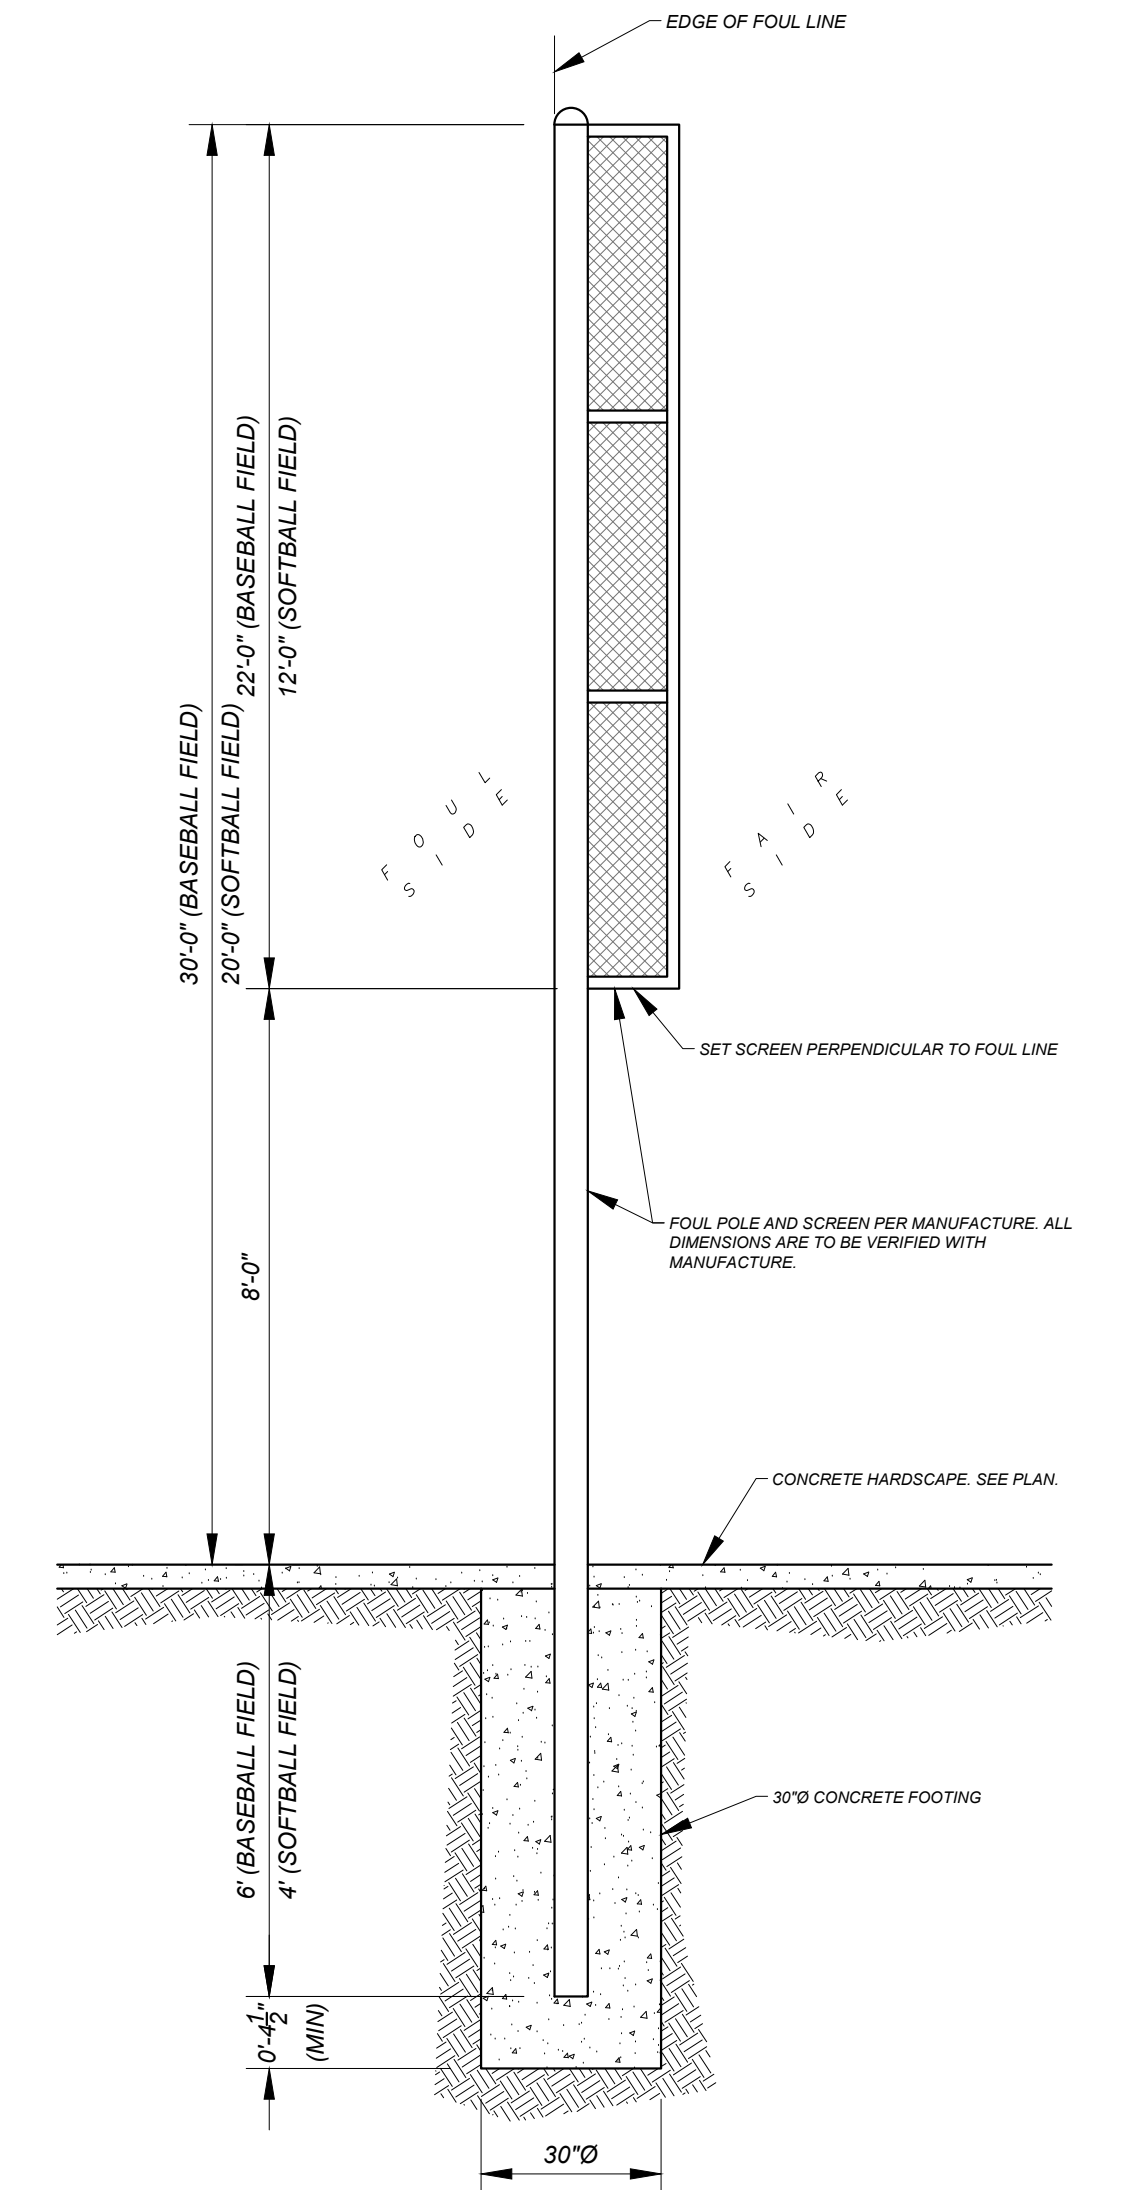

General Notes

Blair, Church & Flynn Consulting Engineers
461 Clovis Avenue, Suite 200
Clovis, California 93612
Tel (559) 326-1400 Fax (559) 326-1500

ARCHITECTURE PLANNING INTERIORS
www.dardenarchitects.com
6790 N. West Ave. • Fresno, CA 93711 • T. 559.448.8051

PORTERVILLE COLLEGE ATHLETIC COMPLEX
PHASE I
100 E COLLEGE AVE.
PORTERVILLE, CA 93257

BALLFIELD DETAILS


Darden Architects
ARCHITECTURE PLANNING INTERIORS
www.dardenarchitects.com
6790 N. West Ave. • Fresno, CA 93711 • T. 559.448.8051

No.	Revision/Submission	Date
1	ADDENDUM 02	01/11/2024

Revision		
Designed By:	Checked By:	Reviewed By:
ZH	JF	ZH

Scale:	AS NOTED	Drawn By:	AH
Project Number:	2118	Checked By:	JF
Date:	12/28/2023	Reviewed By:	ZH

SD/X601
AD2-CX17

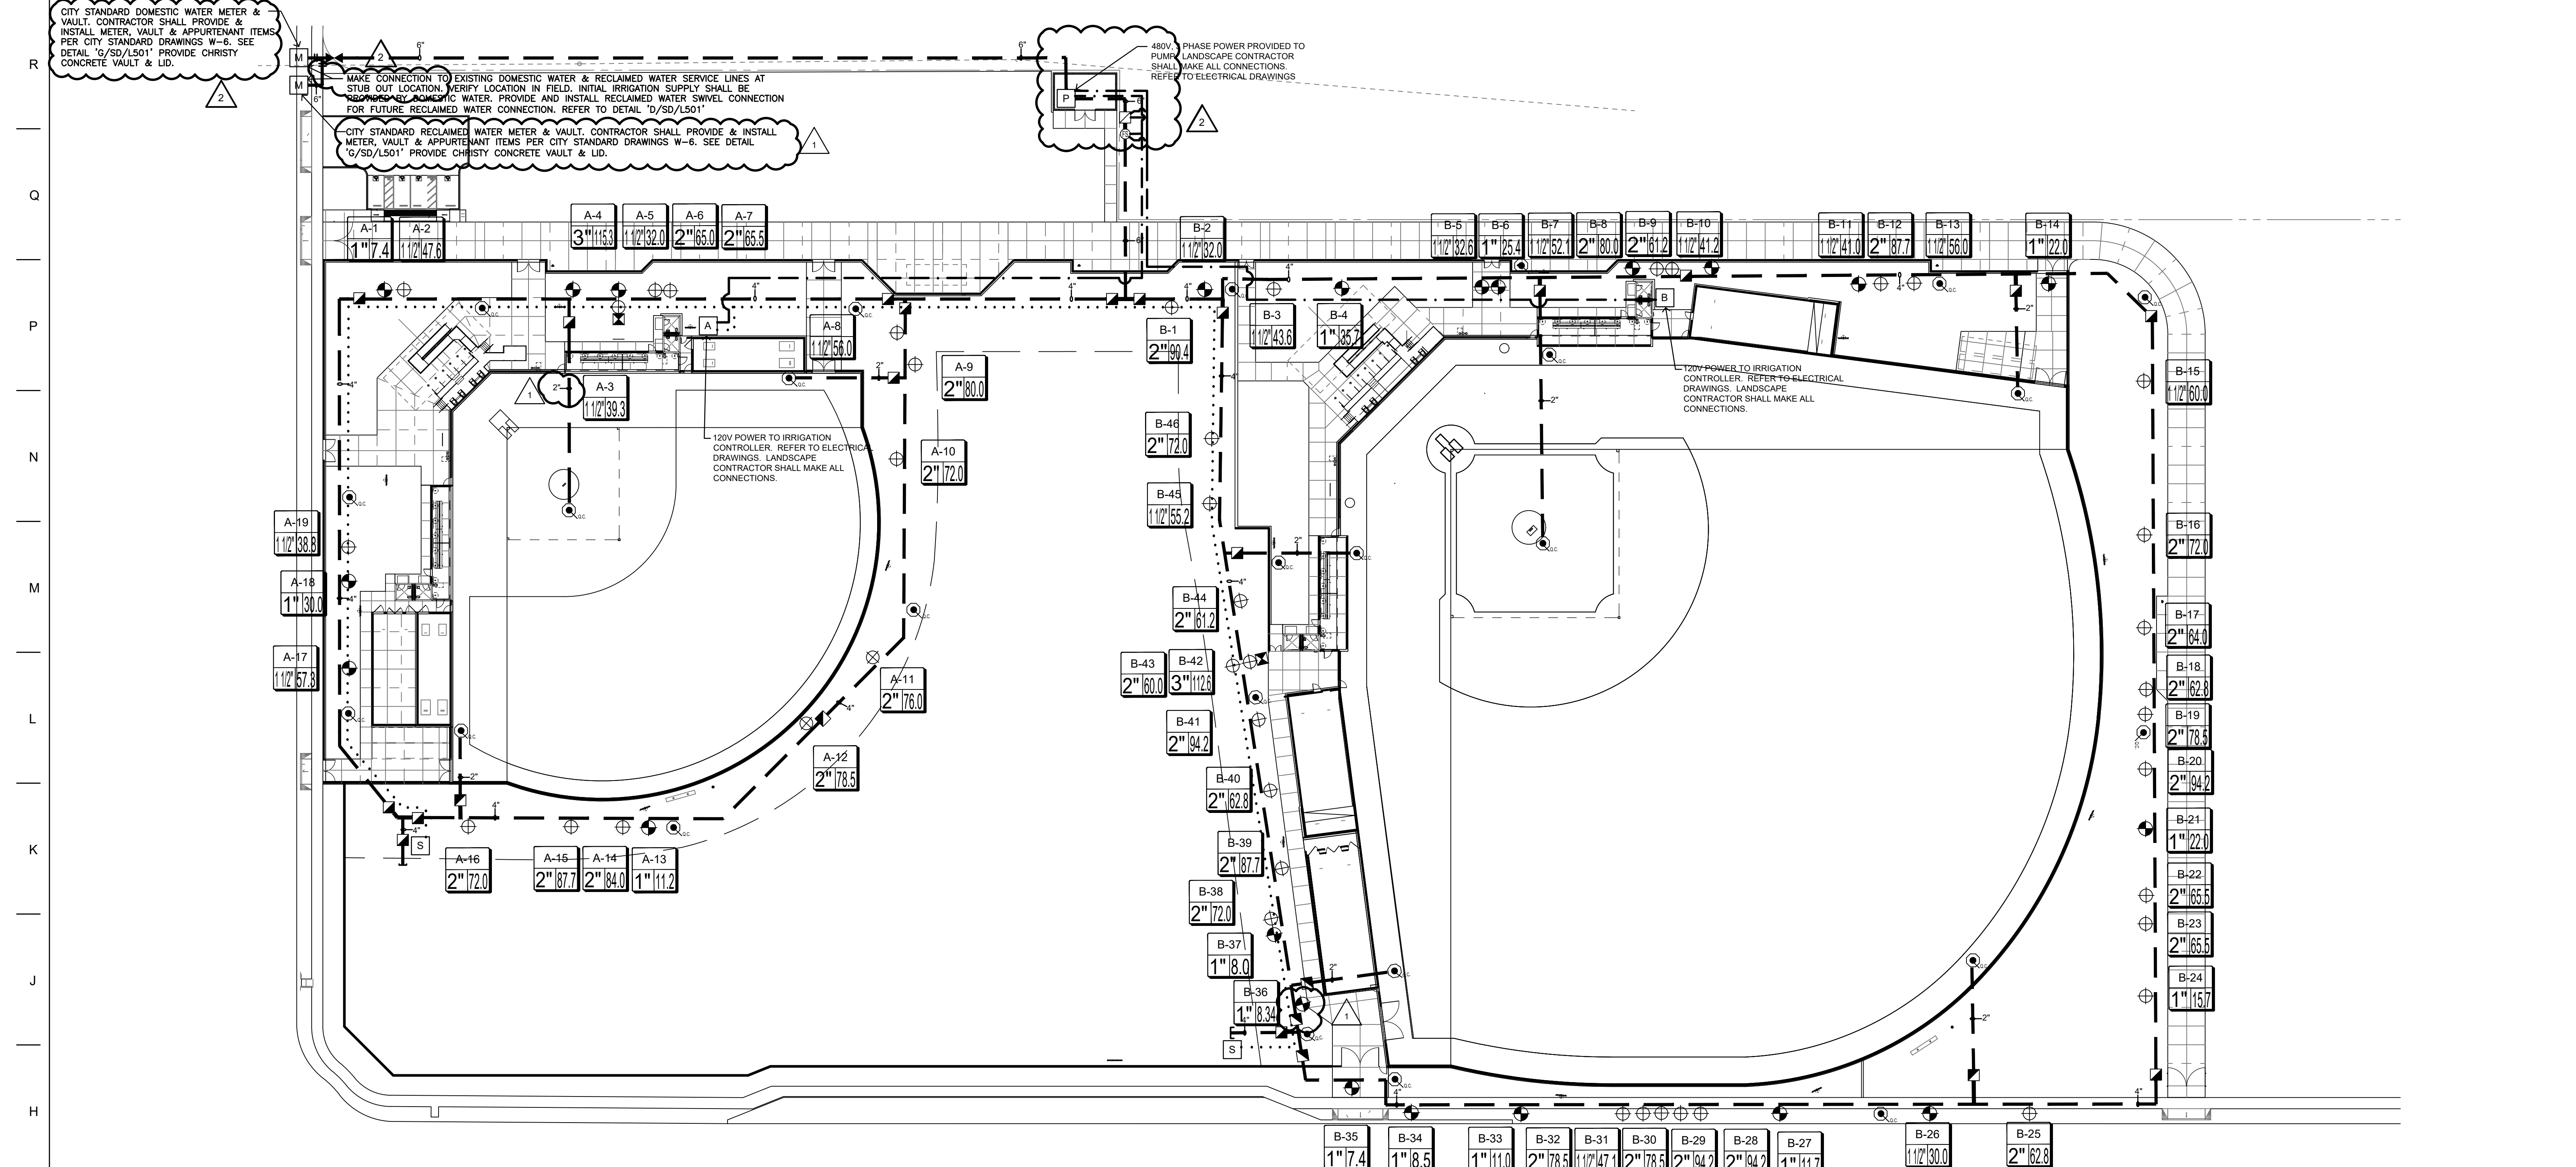

IRRIGATION LEGEND

SYM	MANUFACTURER & DESCRIPTION	NOZZLE	GPM PSI	DETAIL
●	HUNTER 125-06-SS-R POP-UP ROTOR W/ STANDARD NOZZLE	18	15.7 @ 60 PSI	ISDL500
○	HUNTER 125-06-SS-R POP-UP ROTOR W/ STANDARD NOZZLE	8	9.2 @ 60 PSI	ISDL500
⊙	HUNTER 125-06-SS-R-HS POP-UP ROTOR W/ HIGH SPEED NOZZLE	18	15.7 @ 60 PSI	ISDL500
⊙	HUNTER 125-06-SS-R-HS POP-UP ROTOR W/ HIGH SPEED NOZZLE	8	9.2 @ 60 PSI	ISDL500
⊙	HUNTER 120-06-SS-R-PRB POP-UP ROTOR W/ BLUE STANDARD NOZZLE	8.0	8.0 @ 45 PSI	ISDL500
⊙	HUNTER 120-06-SS-R-PRB POP-UP ROTOR W/ BLUE STANDARD NOZZLE	8.0	8.0 @ 45 PSI	ISDL500
⊙	HUNTER 120-06-SS-R-PRB POP-UP ROTOR W/ BLUE STANDARD NOZZLE	4.0	4.0 @ 45 PSI	ISDL500
⊙	HUNTER 120-06-SS-R-PRB POP-UP ROTOR W/ GRAY LOW ANGLE NOZZLE	4.5 LA	4.4 @ 50 PSI	ISDL500
⊙	HUNTER 120-06-SS-R-PRB POP-UP ROTOR W/ GRAY LOW ANGLE NOZZLE	4.5 LA	4.4 @ 50 PSI	ISDL500
⊙	HUNTER 120-06-SS-R-PRB POP-UP ROTOR W/ GRAY LOW ANGLE NOZZLE	2.5 LA	2.8 @ 50 PSI	ISDL500
⊙	HUNTER 120-06-SS-R-PRB POP-UP ROTOR W/ GRAY LOW ANGLE NOZZLE	15-F.H.Q	3.75, 1.88, 0.97 @ 30 PSI	HSDL500
⊙	HUNTER PRO3-04-PR30-R 4" POP-UP SPRAY W/ PRO-SPRAY NOZZLE	12-F.H.Q	2.70, 1.35, .67 @ 30 PSI	HSDL500
⊙	HUNTER PRO3-04-PR30-R 4" POP-UP SPRAY W/ PRO-SPRAY NOZZLE	10-F.H.Q	1.55, .88, .42 @ 30 PSI	HSDL500
⊙	HUNTER PRO3-04-PR30-R 4" POP-UP SPRAY W/ PRO-SPRAY NOZZLE	8-F.H.Q	0.91, 0.41, 0.24 @ 30 PSI	HSDL500
⊙	RAINBIRD RV8-B-1004-P-SOCK-GRATE ROOT ZONE WATERING SYSTEM		1.0 @ 30 PSI	PSDL500
⊙	NISCO 1418 SW-SON CAST IRON RESILIENT WEDGE GATE VALVE W/ 2" OPERATING NUT SIZE EQUAL TO MAINLINE			CSDL500
⊙	RAINBIRD 44-NP QUICK COUPLING VALVE. INSTALL IN VALVE BOX.			BSDL500
⊙	IRRTROL 700 SERIES ELECTRIC CONTROL VALVE W/ OMR-100 OMNI REG PRESSURE REGULATOR & W/ RW60-KIT RECYCLED WATER SOLENOID KIT. SIZE AS NOTED. INSTALL IN VALVE BOX			ASDL500
⊙	IRRTROL 100-S SERIES ELECTRIC CONTROL VALVE & W/ RW60-KIT RECYCLED WATER SOLENOID KIT. SIZE AS NOTED. INSTALL IN VALVE BOX			ASDL500
⊙	FEBCO 800L7 4" REDUCED PRESSURE BACKFLOW PREVENTER W/ VALVE SETTER.			LSDL500
⊙	RAINBIRD ESP-LAMEE ESP-FIX-MEM 12 STATION CONTROLLER. INSTALL IN STRENGTHBOX SB2433 STAINLESS STEEL ENCLOSURE W/ DISCONNECT SWITCH. PROVIDE (3) RAINBIRD ESP-MEM 12, 12 STATION EXPANSION MODULES. PROVIDE FLOW SENSING MASTER VALVE & PUMP START WIRING TO CONTROLLER 'A' & 'B'. PROVIDE RAINBIRD WFC-RFC WIRELESS RAINFRETENSE SENSOR. PROVIDE (1) NCC-EN ETHERNET CABLE/ROD.			ISDL500
⊙	WATERTRONICS SKID MOUNTED IRRIGATION BOOSTER PUMP (WMBV-5000-7A-20-480-3-80) W/ VFD CONTROLS & PUMP START PANEL. PROVIDE (1) PUMP START WIRE TO CONTROLLER 'A' & 'B'.			USDL500
⊙	BERMAD 6" 410 NORMALLY OPEN FLANGED END MASTER VALVE W/ 24 VOLT SOLENOID. WIRE TO MASTER VALVE TERMINAL IN CONTROLLER 'A' & 'B'. INSTALL IN VALVE BOX.			ASDL500 SIM
⊙	FLO-MEC QS200-3" FLOW SENSOR. WIRE TO FLOW SENSOR TERMINAL IN CONTROLLER 'A' & 'B'.			MSDL500
⊙	CLASS 200 TO RING GASKETED RING TITE 'PURPLE TINTED' NON POTABLE PVC MAINLINE. SEE PLAN FOR SIZE.			DSDL500
⊙	SCHEDULE 40 'PURPLE TINTED' NON POTABLE PVC LATERAL LINE. SEE PLAN FOR SIZE.			DSDL500
⊙	PVC SLEEVE. SEE LEGEND FOR SIZE.			DSDL500
⊙	TORO DL200 RGP-412 DRIPLINE. INSTALL ON FINISH GRADE OF DIRT AT 12" O.C.			OSDL500
⊙	TORO T-YD-500-34 AIR RELIEF VALVE. INSTALL IN VALVE BOX.			SSDL500
⊙	TORO T-FOH-H-FIPT FLUSH VALVE. INSTALL IN VALVE BOX.			OSDL500
⊙	TORO T-ALS FS 75150-S FILTER W/ 150 MESH STAINLESS STEEL SCREEN			RSDL500
⊙	CHAMPION 3" 109RS-300 STRAIGHT VALVE W/ HAND WHEEL. INSTALL IN VALVE BOX			RSDL500
⊙	PROPOSED ROUTE OF IRRIGATION FLOW SENSOR, SPARE PUMP START WIRES, & MASTER VALVE WIRES. RUN CONTINUOUS FROM IRRIGATION PUMP ENCLOSURE TO CONTROLLER 'A' & 'B'.			OSDL500

- LATERAL LINES SHALL BE SCHEDULE 40 PVC.
- ADJUST ALL IRRIGATION HEADS TO ELIMINATE OVERSPRAY ON ADJACENT HARD SURFACE AREAS. PROVIDE ADJUSTABLE ARC NOZZLE FOR IRRIGATION HEADS WHERE OVERSPRAY IS EXCESSIVE. PROVIDE CHECK VALVES WHERE NEEDED TO PREVENT LOW HEAD DRAINAGE.
- PIPING, VALVES, ETC. SHOWN WITHIN PAVED AREAS ARE FOR DESIGN CLARIFICATION ONLY AND SHALL BE INSTALLED IN PLANTING AREAS WHERE POSSIBLE.
- IRRIGATION SYSTEM DESIGN: 300 G.P.M. @ 80 PSI AT POINT OF CONNECTION DOWNSTREAM FROM IRRIGATION BOOSTER PUMP. 53 PSI PROVIDED AT STREET CONNECTION. 47 PSI BOOST PRESSURE BY PUMP.
- DO NOT WILLFULLY INSTALL THE IRRIGATION SYSTEM AS SHOWN ON THE DRAWINGS WHEN IT IS OBVIOUS IN THE AREA DIMENSIONS EXIST THAT MIGHT NOT HAVE BEEN CONSIDERED IN THE ENGINEERING. SUCH OBSTRUCTIONS OR DIFFERENCES SHOULD BE BROUGHT TO THE ATTENTION OF THE LANDSCAPE ARCHITECT IN THE EVENT THIS NOTIFICATION IS NOT PERFORMED, THE CONTRACTOR SHALL ASSUME FULL RESPONSIBILITY FOR ANY REVISIONS NECESSARY AT NO EXPENSE TO THE OWNER.
- SPLICING OF 24 VOLT WIRES WILL NOT BE PERMITTED EXCEPT IN VALVE BOXES. LEAVE A 24" COIL OF EXCESS WIRE AT EACH SPLICE. LABEL ALL WIRES W/ WATERPROOF MARKERS AT ALL SPLICES. VALVE MANIFOLDS AND CONTROLLER.
- INSTALL VALVE BOXES 12" FROM AND PERPENDICULAR TO WALKS, CURBS, LAWN, BUILDINGS OR LANDSCAPE FEATURES. AT MULTIPLE VALVE BOX GROUPS, EACH BOX SHALL BE AN EQUAL DISTANCE FROM THE WALK, CURB, LAWN, ETC. AND EACH BOX SHALL BE 4" APART. SHORT SIDE OF THE VALVE BOX SHALL BE PARALLEL TO WALK, CURB, LAWN ETC. INSTALL ONE VALVE PER BOX ONLY.
- CONTRACTOR IS RESPONSIBLE FOR BACKFLOW UNIT TO BE TESTED AND CERTIFIED BY AN APPROVED TESTER.
- CONTRACTOR SHALL BE RESPONSIBLE FOR THE INSTALLATION OF ALL MATERIAL APPEARING ON PLAN.
- CONCRETE THRUST BLOCKS SHALL BE PROVIDED ON ALL MAINLINE PIPING. THEY ARE TO BE LOCATED AT ALL ABRUPT CHANGES IN PIPELINE GRADE, CHANGES TO HORIZONTAL ALIGNMENT, REDUCTION IN PIPE SIZES, END OF LINE AND IN-LINE VALVES TO ABSORB ANY AXIAL THRUST OF THE PIPE. THE PIPE MANUFACTURER'S RECOMMENDATIONS FOR THRUST BLOCKS MUST BE FORMED AGAINST UNDISTURBED EARTH.
- ALL MAIN LINE PIPES SHALL BE PRESSURE TESTED PER STANDARD IRRIGATION SPECIFICATIONS WITH THE VALVES INSTALLED. THE CONTRACTOR SHALL PROVIDE ALL EQUIPMENT NEEDED. IF ANY LEAKS DEVELOP, THE REPAIRS ARE TO BE MADE AND TEST REPEATED UNTIL THE SYSTEM IS PROVEN WATERTIGHT. THE CONTRACTOR IS TO CENTER LOAD THE PIPE AND LEAVE ALL JOINTS EXPOSED FOR INSPECTION. THE PRESSURE TEST SHALL BE OBSERVED AND APPROVED BY THE INSPECTOR. WHEN THE PIPE IS PROVEN WATERTIGHT AND ONLY THEN MAY THE LINE BE BACKFILLED.
- THE CONTRACTOR SHALL PROVIDE AND KEEP AN UP-TO-DATE "RECORD DRAWING" SHOWING ALL CHANGES TO THE ORIGINAL DRAWINGS AND EXACT LOCATIONS OF FACILITIES INSTALLED. BEFORE FINAL INSPECTION, THE CONTRACTOR SHALL FURNISH "RECORD DRAWINGS" TO THE PROJECT INSPECTOR.
- ALL NON-GALVANIZED PIPE AND FITTING SHALL BE PRIMED AND PAINTED WITH ONE COAT PRIMER AND TWO COATS COLOR WITH APPROVED TYPE RUST INHIBITIVE PRIMER AND PAINT. COLOR SHALL BE DETERMINED BY THE LANDSCAPE ARCHITECT.
- CONTRACTOR SHALL PROVIDE TO THE DISTRICT THE FOLLOWING EQUIPMENT / MATERIALS AS PART OF HIS WORK:
 - TWELVE (12) 125-06-SS-R ROTORS
 - TWELVE (12) 120-06-SS-R ROTORS
 - TWELVE (12) HUNTER PRO3-04-PR30-R POP-UP SPRAY BODIES
 - TWELVE (12) EACH HUNTER 15 PRO SERIES NOZZLE: 15F, 12H & 12D
 - TWELVE (12) EACH HUNTER 12 PRO SERIES NOZZLE: 12F, 12H & 12D
 - ONE (1) RAINBIRD LANDSCAPE IRRIGATION MAINTENANCE REMOTE
- THE CONTRACTOR SHALL PROVIDE ONE CONTROLLER CHART FOR EACH CONTROLLER INSTALLED. THE CHART SHALL SHOW THE AREA IRRIGATED BY THE CONTROLLER AND SHALL BE THE MAXIMUM SIZE THE CONTROLLER DOOR WILL ALLOW. THE CHART MAY BE REDUCED DRAWING OF THE RECORD DRAWINGS. THE CHART SHALL BE COLORED WITH A DIFFERENT COLOR FOR EACH STATION. THE CHART SHALL BE LAMINATED OR COVERED IN A WATERTIGHT ENVELOPE.
- THE CONTRACTOR SHALL PROVIDE OPERATION AND MAINTENANCE MANUALS. REFER TO SPECIFICATION SECTION 32 94 32 FOR INFORMATION REQUIREMENTS.
- THE CONTRACTOR SHALL PROVIDE & INSTALL TWO (2) AIR RELEASE VALVES PER DETAIL 'K03050' IN THE BID. INSTALLATION LOCATIONS SHALL BE DETERMINED IN THE FIELD AT HIGH AREAS OF MAINLINE AND DEAD END RUNS.
- THE CONTRACTOR SHALL PROVIDE AN IRRIGATION SCHEDULE AS PART OF THE CONTRACT WORK. THE SCHEDULE SHALL COMPLY WITH THE STATE OF CALIFORNIA MODEL WATER EFFICIENT LANDSCAPE ORDINANCE.
- THE CONTRACTOR SHALL OPERATE THE IRRIGATION SYSTEM TO RUN A MINIMUM OF 110 GPM WHEN THE IRRIGATION BOOSTER PUMP IS REQUIRED TO PROVIDE SUSTAINED OPERATING PRESSURE. PROVIDE IRRIGATION WATER SCHEDULING TO RUN A MIN OF 110 GPM WHEN PUMP IS OPERATING.
- THE CONTRACTOR SHALL BE SOLELY RESPONSIBLE FOR PROVIDING A COMPLETE, FUNCTIONING IRRIGATION SYSTEM AS DIRECTED BY THE OWNER. CONTRACTOR SHALL FURNISH ALL APPURTENANT ITEMS, MATERIALS, LABOR, EQUIPMENT NECESSARY TO PROVIDE A COMPLETELY FUNCTIONAL IRRIGATION SYSTEM WHETHER SOLELY SHOWN OR CALLED FOR ON PLANS & SPECIFICATIONS. IT SHALL BE THE CONTRACTOR'S RESPONSIBILITY TO INCLUDE SUCH ITEMS IN THEIR PRICE FOR THE WORK. NO ADDITIONAL COMPENSATION WILL BE AUTHORIZED FOR WORK DEEMED INCLUDED IN THE CONTRACT BY OWNER.
- THE CONTRACTOR SHALL BE SOLELY RESPONSIBLE FOR: CONTROL WIRE TERMINATION AT CONTROLLER, SCHEDULING WATER TIMES & PROGRAMS FOR THE IRRIGATION CONTROLLERS ON SITE, PROVIDING THE CORRECT AMOUNT OF WATER AFFORDED TO THE PLANT MATERIAL ON THE PROJECT FOR OPTIMUM GROWTH. CONTRACTOR SHALL PROGRAM ALL CONTROLLERS TO UTILIZE THE DESIGN FLOW REQUIRED TO OPERATE THE BOOSTER PUMP OF THE IRRIGATION SYSTEM AT OPTIMAL FLOW FOR DEMAND NEEDED ELIMINATING PUMP OPERATION INTERRUPTIONS. PROGRAMMING SHALL BALANCE THE FLOW BY USING ALL CONTROLLERS ON SITE. THIS REQUIREMENT SHALL RUN FROM START OF CONTRACT UNTIL FINAL ACCEPTANCE OF IRRIGATION SYSTEM. NO ADDITIONAL COMPENSATION SHALL BE AUTHORIZED FOR WORK NEEDED TO PROGRAM, SCHEDULE OR TO SET UP WATERING CYCLES DEEMED INCLUDED IN THE CONTRACT BY THE OWNER. CONTRACTOR SHALL ENSURE FLOW SENSING & MASTER VALVES COMMUNICATE TO CONTROLLERS.
- THE CONTRACTOR SHALL PROVIDE A LANDSCAPE & IRRIGATION MAINTENANCE SCHEDULE AND AN IRRIGATION AUDIT, SURVEY, & IRRIGATION WATER USE ANALYSIS AS PART OF THE CONTRACT WORK. THE MAINTENANCE SCHEDULE, IRRIGATION AUDIT, SURVEY, & IRRIGATION WATER USE ANALYSIS SHALL COMPLY WITH THE STATE OF CALIFORNIA MODEL WATER EFFICIENT LANDSCAPE ORDINANCE.
- THE CONTRACTOR SHALL PROVIDE AN IRRIGATION SCHEDULE AS PART OF THE CONTRACT WORK. THE SCHEDULE SHALL COMPLY WITH THE STATE OF CALIFORNIA MODEL WATER EFFICIENT LANDSCAPE ORDINANCE.
- THE CONTRACTOR SHALL OPERATE THE IRRIGATION SYSTEM TO RUN A MINIMUM OF 110 GPM WHEN THE IRRIGATION BOOSTER PUMP IS REQUIRED TO PROVIDE SUSTAINED OPERATING PRESSURE. PROVIDE IRRIGATION WATER SCHEDULING TO RUN A MIN OF 110 GPM WHEN PUMP IS OPERATING.

VALVE KEY

CONTROLLER STATION ID

GALLONS PER MINUTE

VALVE SIZE

IRRIGATION SLEEVE LEGEND

KEY	DESCRIPTION
①	(1) 8" PVC MAINLINE SLEEVE & (1) 3" PVC WIRE SLEEVE
②	(1) 3" PVC LATERAL SLEEVE
③	(1) 4" PVC LATERAL SLEEVE
④	(1) 6" PVC LATERAL SLEEVE
⑤	(1) 10" PVC MAINLINE SLEEVE & (1) 3" PVC WIRE SLEEVE

GENERAL NOTES

1. LATERAL LINES SHALL BE SCHEDULE 40 PVC.

2. ADJUST ALL IRRIGATION HEADS TO ELIMINATE OVERSPRAY ON ADJACENT HARD SURFACE AREAS. PROVIDE ADJUSTABLE ARC NOZZLE FOR IRRIGATION HEADS WHERE OVERSPRAY IS EXCESSIVE. PROVIDE CHECK VALVES WHERE NEEDED TO PREVENT LOW HEAD DRAINAGE.

3. PIPING, VALVES, ETC. SHOWN WITHIN PAVED AREAS ARE FOR DESIGN CLARIFICATION ONLY AND SHALL BE INSTALLED IN PLANTING AREAS WHERE POSSIBLE.

4. IRRIGATION SYSTEM DESIGN: 300 G.P.M. @ 80 PSI AT POINT OF CONNECTION DOWNSTREAM FROM IRRIGATION BOOSTER PUMP. 53 PSI PROVIDED AT STREET CONNECTION. 47 PSI BOOST PRESSURE BY PUMP.

5. DO NOT WILLFULLY INSTALL THE IRRIGATION SYSTEM AS SHOWN ON THE DRAWINGS WHEN IT IS OBVIOUS IN THE AREA DIMENSIONS EXIST THAT MIGHT NOT HAVE BEEN CONSIDERED IN THE ENGINEERING. SUCH OBSTRUCTIONS OR DIFFERENCES SHOULD BE BROUGHT TO THE ATTENTION OF THE LANDSCAPE ARCHITECT IN THE EVENT THIS NOTIFICATION IS NOT PERFORMED, THE CONTRACTOR SHALL ASSUME FULL RESPONSIBILITY FOR ANY REVISIONS NECESSARY AT NO EXPENSE TO THE OWNER.

6. SPLICING OF 24 VOLT WIRES WILL NOT BE PERMITTED EXCEPT IN VALVE BOXES. LEAVE A 24" COIL OF EXCESS WIRE AT EACH SPLICE. LABEL ALL WIRES W/ WATERPROOF MARKERS AT ALL SPLICES. VALVE MANIFOLDS AND CONTROLLER.

7. INSTALL VALVE BOXES 12" FROM AND PERPENDICULAR TO WALKS, CURBS, LAWN, BUILDINGS OR LANDSCAPE FEATURES. AT MULTIPLE VALVE BOX GROUPS, EACH BOX SHALL BE AN EQUAL DISTANCE FROM THE WALK, CURB, LAWN, ETC. AND EACH BOX SHALL BE 4" APART. SHORT SIDE OF THE VALVE BOX SHALL BE PARALLEL TO WALK, CURB, LAWN ETC. INSTALL ONE VALVE PER BOX ONLY.

8. CONTRACTOR IS RESPONSIBLE FOR BACKFLOW UNIT TO BE TESTED AND CERTIFIED BY AN APPROVED TESTER.

9. CONTRACTOR SHALL BE RESPONSIBLE FOR THE INSTALLATION OF ALL MATERIAL APPEARING ON PLAN.

10. CONCRETE THRUST BLOCKS SHALL BE PROVIDED ON ALL MAINLINE PIPING. THEY ARE TO BE LOCATED AT ALL ABRUPT CHANGES IN PIPELINE GRADE, CHANGES TO HORIZONTAL ALIGNMENT, REDUCTION IN PIPE SIZES, END OF LINE AND IN-LINE VALVES TO ABSORB ANY AXIAL THRUST OF THE PIPE. THE PIPE MANUFACTURER'S RECOMMENDATIONS FOR THRUST BLOCKS MUST BE FORMED AGAINST UNDISTURBED EARTH.

11. ALL MAIN LINE PIPES SHALL BE PRESSURE TESTED PER STANDARD IRRIGATION SPECIFICATIONS WITH THE VALVES INSTALLED. THE CONTRACTOR SHALL PROVIDE ALL EQUIPMENT NEEDED. IF ANY LEAKS DEVELOP, THE REPAIRS ARE TO BE MADE AND TEST REPEATED UNTIL THE SYSTEM IS PROVEN WATERTIGHT. THE CONTRACTOR IS TO CENTER LOAD THE PIPE AND LEAVE ALL JOINTS EXPOSED FOR INSPECTION. THE PRESSURE TEST SHALL BE OBSERVED AND APPROVED BY THE INSPECTOR. WHEN THE PIPE IS PROVEN WATERTIGHT AND ONLY THEN MAY THE LINE BE BACKFILLED.

12. THE CONTRACTOR SHALL PROVIDE AND KEEP AN UP-TO-DATE "RECORD DRAWING" SHOWING ALL CHANGES TO THE ORIGINAL DRAWINGS AND EXACT LOCATIONS OF FACILITIES INSTALLED. BEFORE FINAL INSPECTION, THE CONTRACTOR SHALL FURNISH "RECORD DRAWINGS" TO THE PROJECT INSPECTOR.

13. ALL NON-GALVANIZED PIPE AND FITTING SHALL BE PRIMED AND PAINTED WITH ONE COAT PRIMER AND TWO COATS COLOR WITH APPROVED TYPE RUST INHIBITIVE PRIMER AND PAINT. COLOR SHALL BE DETERMINED BY THE LANDSCAPE ARCHITECT.

14. CONTRACTOR SHALL PROVIDE TO THE DISTRICT THE FOLLOWING EQUIPMENT / MATERIALS AS PART OF HIS WORK:

SIX (6) COMPLETE ASSEMBLIES OF RAINBIRD 44 QUICK COUPLING KEY WITH HOSE ELBOW.

TWO (2) GATE VALVE KEY FOR 2" OPERATING NUT.

IRRIGATION REPLACEMENT EQUIPMENT:

A. TWELVE (12) 125-06-SS-R ROTORS

B. TWELVE (12) 120-06-SS-R ROTORS

C. TWELVE (12) HUNTER PRO3-04-PR30-R POP-UP SPRAY BODIES

D. TWELVE (12) EACH HUNTER 15 PRO SERIES NOZZLE: 15F, 12H & 12D

E. TWELVE (12) EACH HUNTER 12 PRO SERIES NOZZLE: 12F, 12H & 12D

F. ONE (1) RAINBIRD LANDSCAPE IRRIGATION MAINTENANCE REMOTE

15. THE CONTRACTOR SHALL PROVIDE ONE CONTROLLER CHART FOR EACH CONTROLLER INSTALLED. THE CHART SHALL SHOW THE AREA IRRIGATED BY THE CONTROLLER AND SHALL BE THE MAXIMUM SIZE THE CONTROLLER DOOR WILL ALLOW. THE CHART MAY BE REDUCED DRAWING OF THE RECORD DRAWINGS. THE CHART SHALL BE COLORED WITH A DIFFERENT COLOR FOR EACH STATION. THE CHART SHALL BE LAMINATED OR COVERED IN A WATERTIGHT ENVELOPE.

16. THE CONTRACTOR SHALL PROVIDE OPERATION AND MAINTENANCE MANUALS. REFER TO SPECIFICATION SECTION 32 94 32 FOR INFORMATION REQUIREMENTS.

17. THE CONTRACTOR SHALL PROVIDE & INSTALL TWO (2) AIR RELEASE VALVES PER DETAIL 'K03050' IN THE BID. INSTALLATION LOCATIONS SHALL BE DETERMINED IN THE FIELD AT HIGH AREAS OF MAINLINE AND DEAD END RUNS.

18. THE CONTRACTOR SHALL BE SOLELY RESPONSIBLE FOR PROVIDING A COMPLETE, FUNCTIONING IRRIGATION SYSTEM AS DIRECTED BY THE OWNER. CONTRACTOR SHALL FURNISH ALL APPURTENANT ITEMS, MATERIALS, LABOR, EQUIPMENT NECESSARY TO PROVIDE A COMPLETELY FUNCTIONAL IRRIGATION SYSTEM WHETHER SOLELY SHOWN OR CALLED FOR ON PLANS & SPECIFICATIONS. IT SHALL BE THE CONTRACTOR'S RESPONSIBILITY TO INCLUDE SUCH ITEMS IN THEIR PRICE FOR THE WORK. NO ADDITIONAL COMPENSATION WILL BE AUTHORIZED FOR WORK DEEMED INCLUDED IN THE CONTRACT BY OWNER.

19. THE CONTRACTOR SHALL BE SOLELY RESPONSIBLE FOR: CONTROL WIRE TERMINATION AT CONTROLLER, SCHEDULING WATER TIMES & PROGRAMS FOR THE IRRIGATION CONTROLLERS ON SITE, PROVIDING THE CORRECT AMOUNT OF WATER AFFORDED TO THE PLANT MATERIAL ON THE PROJECT FOR OPTIMUM GROWTH. CONTRACTOR SHALL PROGRAM ALL CONTROLLERS TO UTILIZE THE DESIGN FLOW REQUIRED TO OPERATE THE BOOSTER PUMP OF THE IRRIGATION SYSTEM AT OPTIMAL FLOW FOR DEMAND NEEDED ELIMINATING PUMP OPERATION INTERRUPTIONS. PROGRAMMING SHALL BALANCE THE FLOW BY USING ALL CONTROLLERS ON SITE. THIS REQUIREMENT SHALL RUN FROM START OF CONTRACT UNTIL FINAL ACCEPTANCE OF IRRIGATION SYSTEM. NO ADDITIONAL COMPENSATION SHALL BE AUTHORIZED FOR WORK NEEDED TO PROGRAM, SCHEDULE OR TO SET UP WATERING CYCLES DEEMED INCLUDED IN THE CONTRACT BY THE OWNER. CONTRACTOR SHALL ENSURE FLOW SENSING & MASTER VALVES COMMUNICATE TO CONTROLLERS.

20. THE CONTRACTOR SHALL PROVIDE A LANDSCAPE & IRRIGATION MAINTENANCE SCHEDULE AND AN IRRIGATION AUDIT, SURVEY, & IRRIGATION WATER USE ANALYSIS AS PART OF THE CONTRACT WORK. THE MAINTENANCE SCHEDULE, IRRIGATION AUDIT, SURVEY, & IRRIGATION WATER USE ANALYSIS SHALL COMPLY WITH THE STATE OF CALIFORNIA MODEL WATER EFFICIENT LANDSCAPE ORDINANCE.

21. THE CONTRACTOR SHALL PROVIDE AN IRRIGATION SCHEDULE AS PART OF THE CONTRACT WORK. THE SCHEDULE SHALL COMPLY WITH THE STATE OF CALIFORNIA MODEL WATER EFFICIENT LANDSCAPE ORDINANCE.

22. THE CONTRACTOR SHALL OPERATE THE IRRIGATION SYSTEM TO RUN A MINIMUM OF 110 GPM WHEN THE IRRIGATION BOOSTER PUMP IS REQUIRED TO PROVIDE SUSTAINED OPERATING PRESSURE. PROVIDE IRRIGATION WATER SCHEDULING TO RUN A MIN OF 110 GPM WHEN PUMP IS OPERATING.

DSA File No.:
 DSA Application No.: 03-122694
 Agency Approval

ROBERT BORO
 LANDSCAPE ARCHITECTS
 P.O. Box 4734
 Fresno, California 93744
 TEL: (559) 266-4367
 EMAIL: robert@robor.comcast.net

CONSULTANT

PORTERVILLE COLLEGE SPORTS COMPLEX - PHASE 1
 KERN COMMUNITY COLLEGE DISTRICT
 PORTERVILLE, CA

PROJECT

OVERALL IRRIGATION PLAN

DRAWING

ARCHITECTURE
 PLANNING
 INTERIORS
 darden architects
 www.dardenarchitects.com
 6790 N. West Ave. • Fresno, CA 93711 • T. 559.448.8051

ARCHITECT

ADDENDA	DATE
ADDENDA 2	01/10/24


DESIGNED BY	COPYRIGHT
	Darden Architects

SCALE	DRAWN BY
1" = 40'-0"	AD2-LX-01

PROJECT NUMBER	CHECKED BY
2118	SD/L100

DATE	REVIEWED BY
05-10-23	AD2-LX-01


\\STEVE-PC\Boro Archives\2118-2894\addenda 2\boro plan.dwg 1-10-24 09:04:14 AM Justin

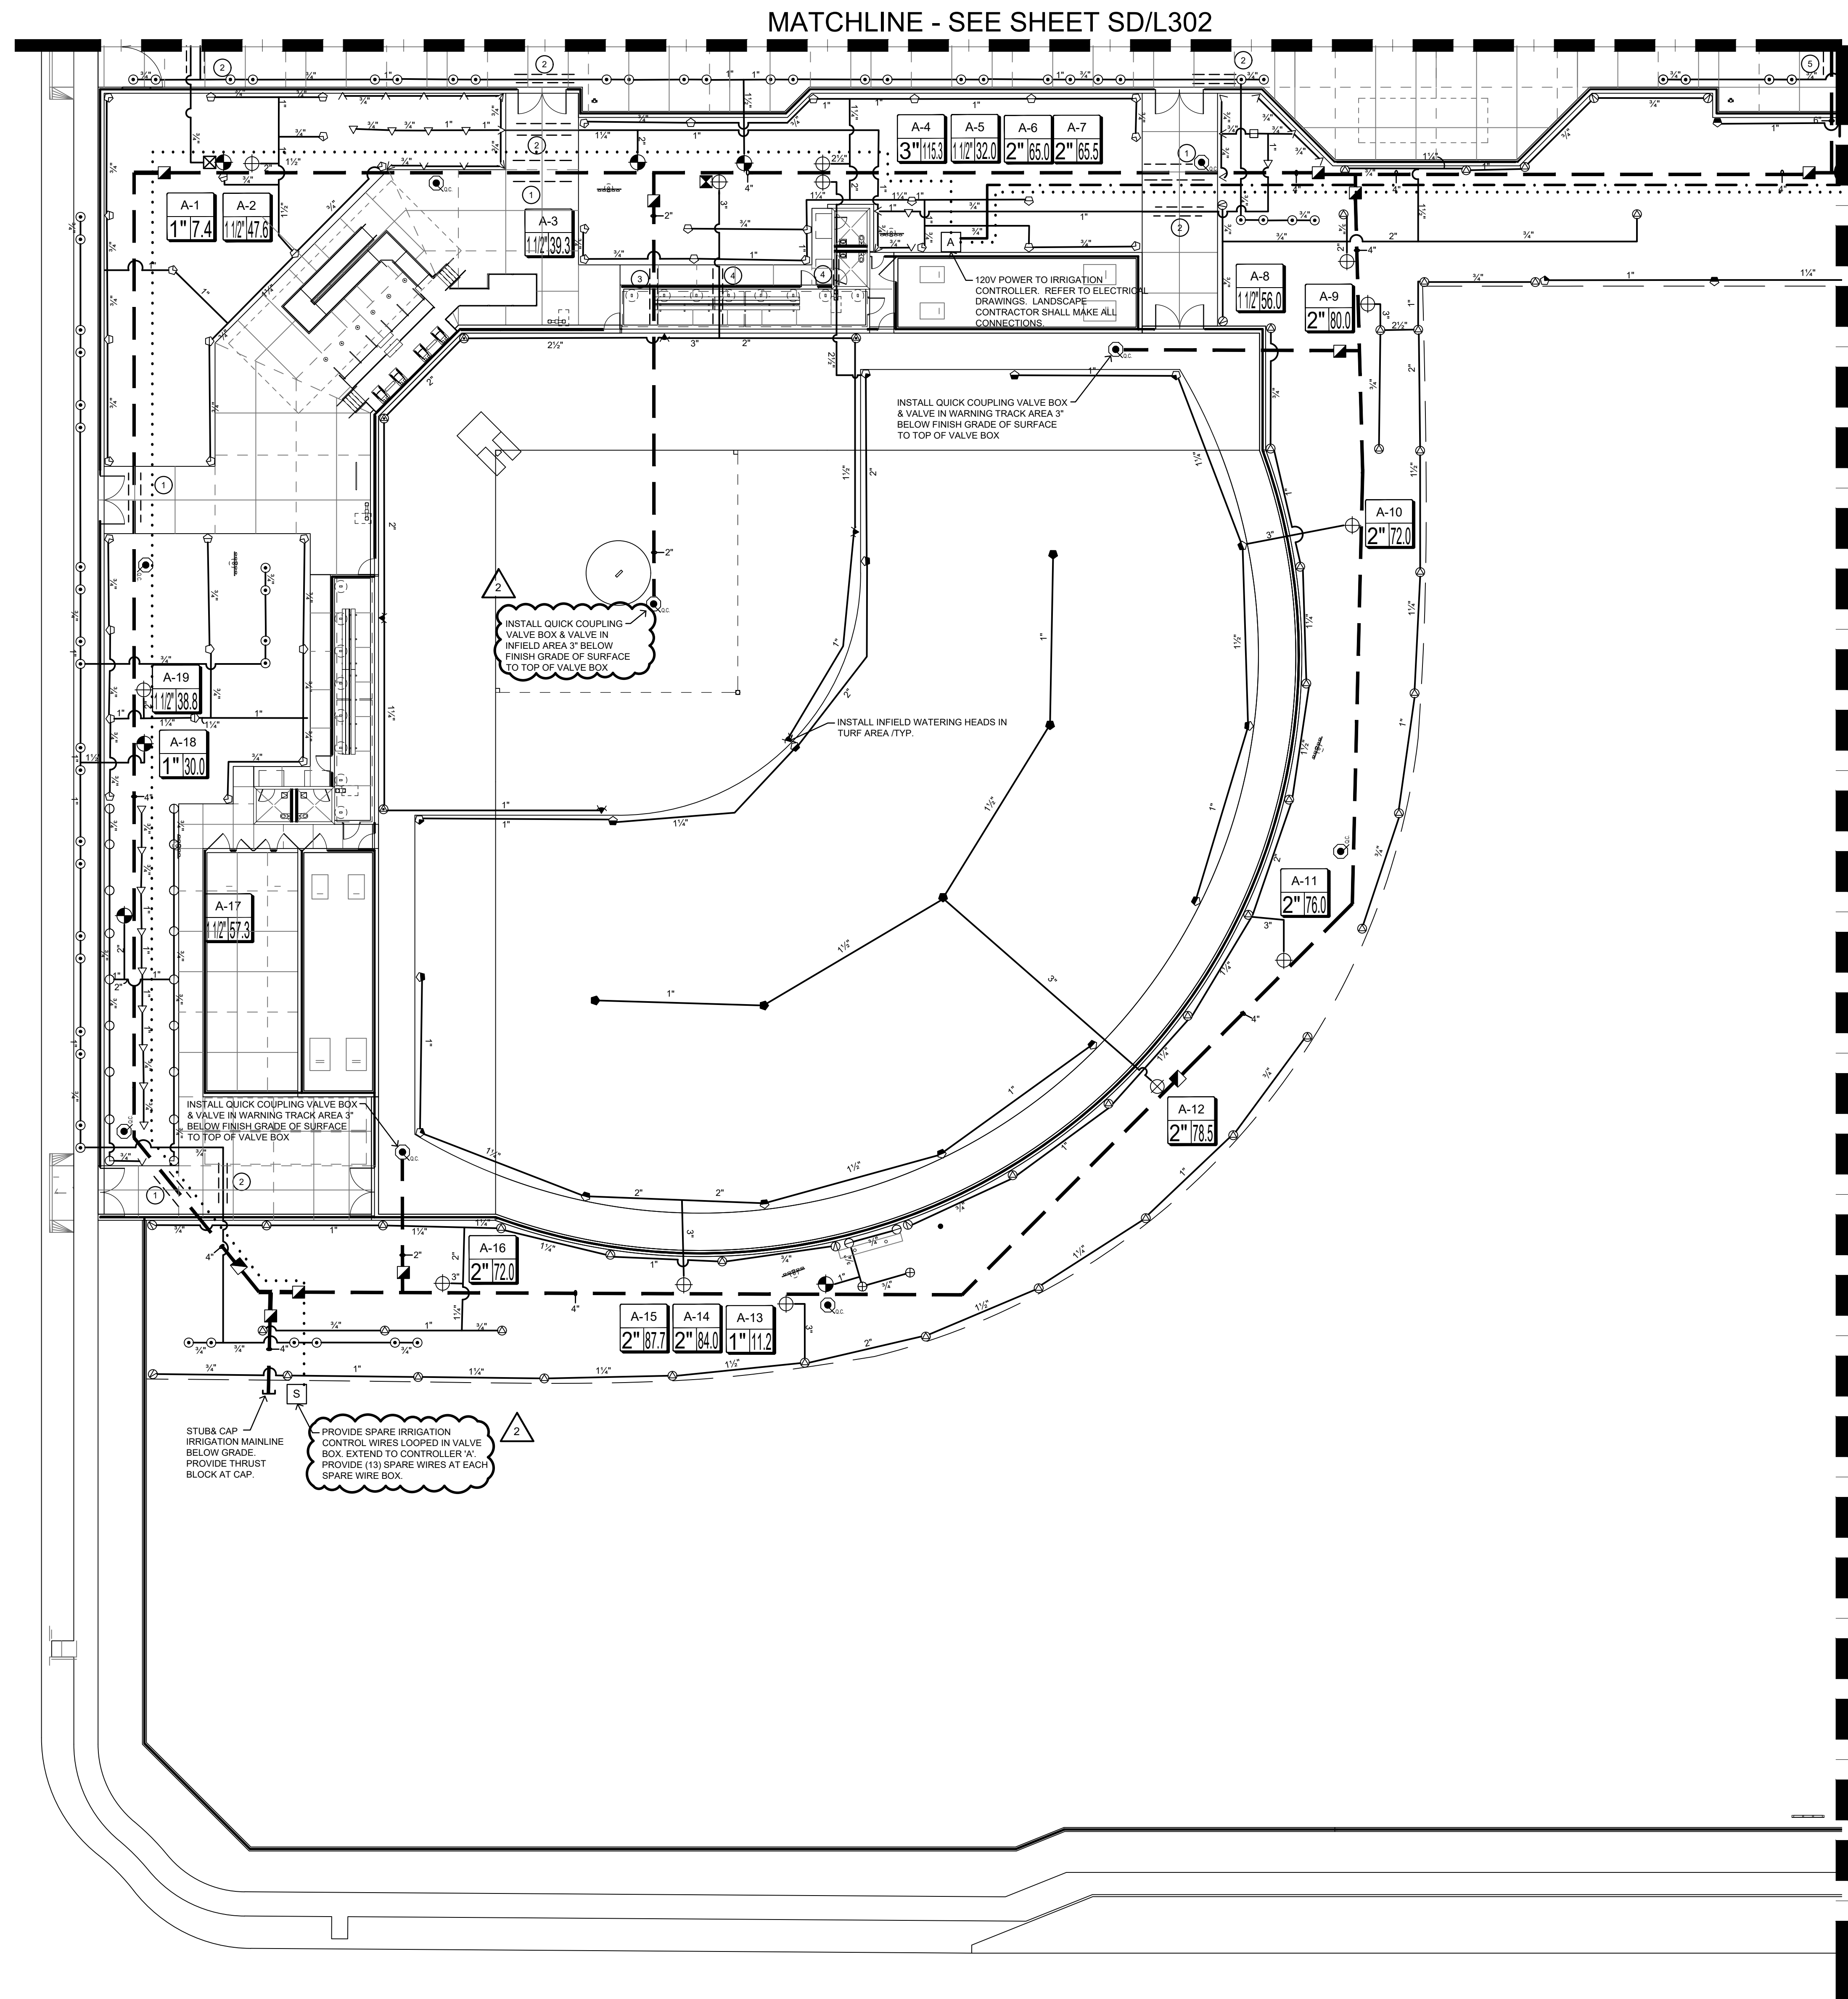

MATCHLINE - SEE SHEET SD/L302

MATCHLINE - SEE SHEET SD/L301

PARTIAL IRRIGATION PLAN
1" = 20'-0"

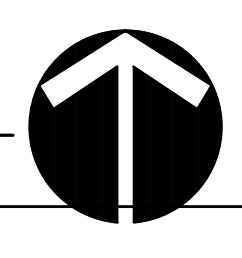

DSA File No.:

DSA Application No.: 03-122694

Agency Approval

General Notes

ROBERT BORO
LANDSCAPE ARCHITECT
P.O. Box 4734
Fresno, California 93744
TEL: (559) 266-4367
EMAIL: robertboro@comcast.net

Consultant

PORTERVILLE COLLEGE SPORTS COMPLEX - PHASE 1
KERN COMMUNITY COLLEGE DISTRICT
PORTERVILLE, CA. Project

PARTIAL IRRIGATION PLAN
Drawing

darden ARCHITECTURE
PLANNING
INTERIORS
www.dardenarchitects.com
6790 N. West Ave. • Fresno, CA 93711 • T. 559.448.8051


Architect

ADDENDA 2	01/10/24


Revision

	Designed By:	Copyright	Darden Architects
Scale: 1" = 20'-0"	Drawn By:	AD2-LX-02	
Project Number: 2118	Checked By:	SD/L300	
Date: 05-10-23	Reviewed By:	AD2-LX-02	

MATCHLINE - SEE SHEET SD/L300

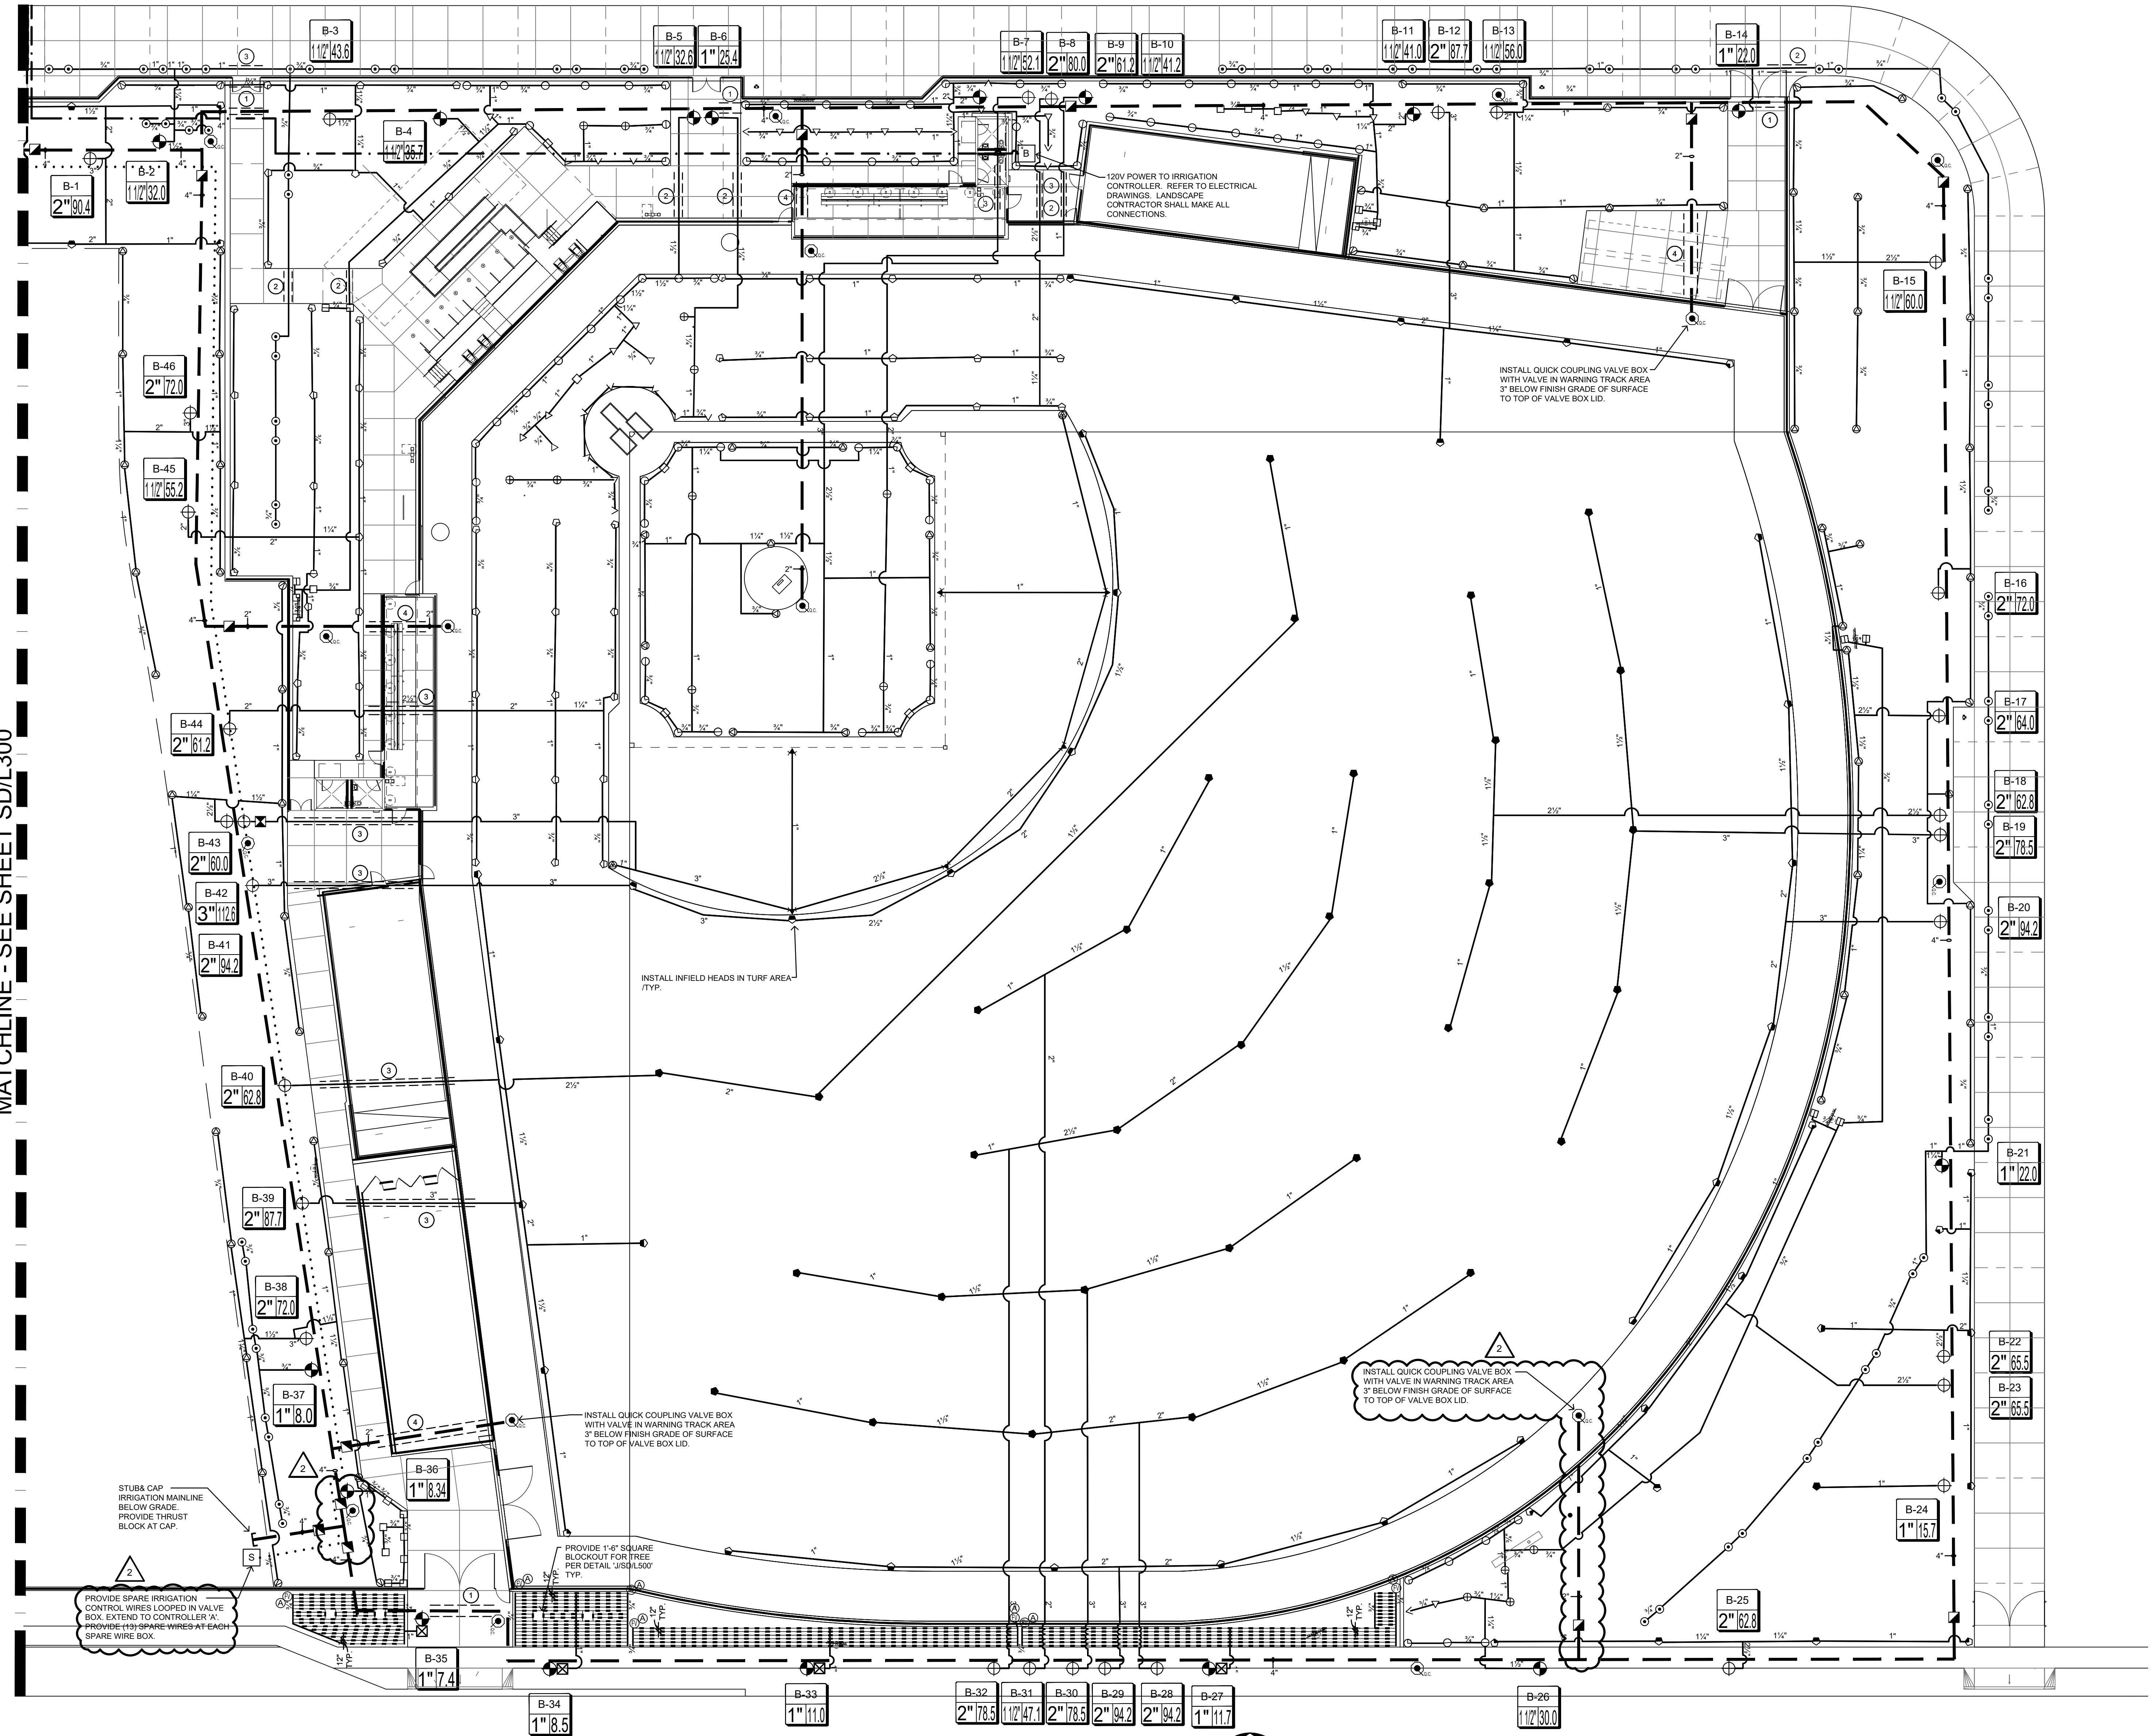

PARTIAL IRRIGATION PLAN
1" = 20'-0"

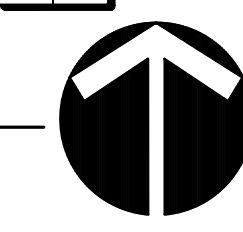

DSA File No.:
DSA Application No.: 03-122694
Agency Approval

Agency Approval

General Notes

ROBERT BORO
LANDSCAPE ARCHITECT
P.O. Box 4734
Fresno, California 93744
TEL: (559) 266-4367
EMAIL: robertboro@comcast.net




Consultant

PORTERVILLE COLLEGE SPORTS COMPLEX - PHASE 1
KERN COMMUNITY COLLEGE DISTRICT
PORTERVILLE, CA. Project

PARTIAL IRRIGATION PLAN
Drawing

darden ARCHITECTURE
PLANNING INTERIORS
architects www.dardenarchitects.com
6790 N. West Ave. • Fresno, CA 93711 • T. 559.448.8051

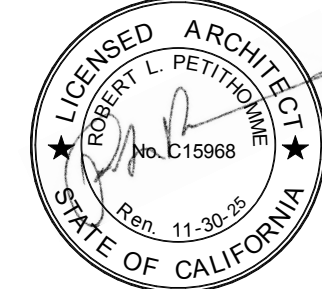


Architect

ADDENDA 2	01/10/24

Revision

Scale: 1" = 20'-0"	Designed By:	Copyright: Darden Architects
Project Number: 2118	Drawn By:	AD2-LX-03
Date: 05-10-23	Checked By:	SD/L301
	Reviewed By:	AD2-LX-03

DSA File No.:
DSA Application No.: 03-122694
Agency Approval

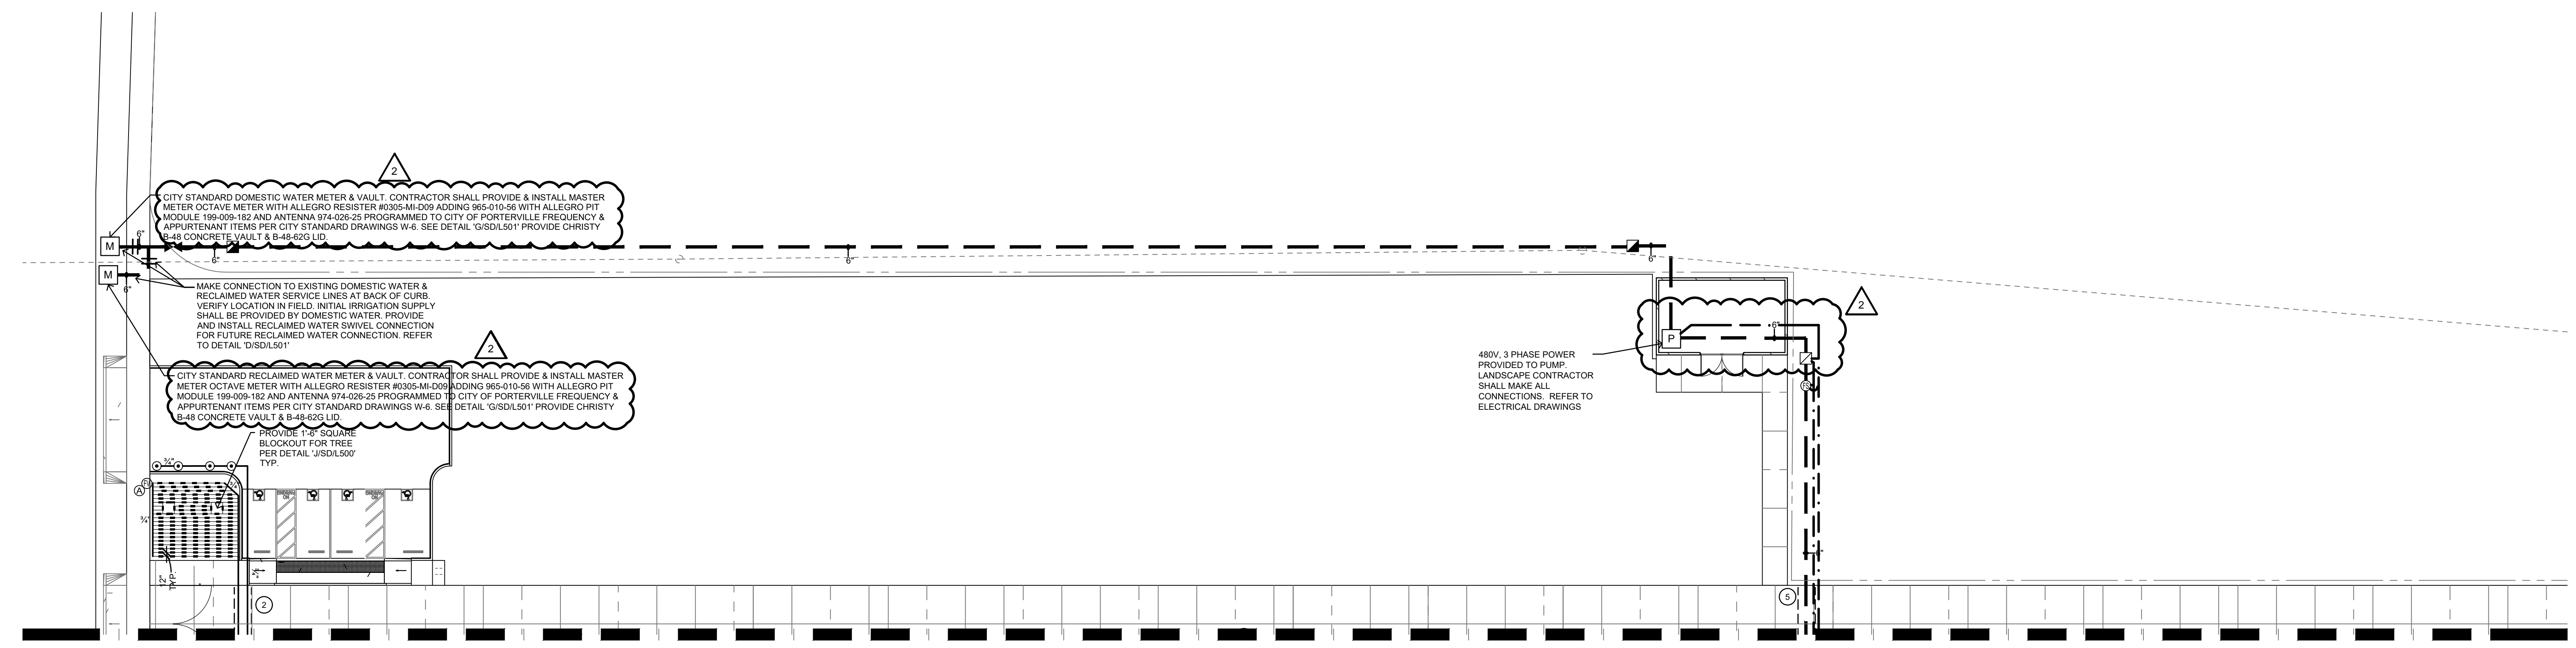

MATCHLINE - SEE SHEET SD/L300

General Notes

ROBERT BORO
LANDSCAPE ARCHITECT
P.O. Box 4734
Fresno, California 93744
TEL: (559) 266-4367
EMAIL: robertboro@comcast.net

Consultant

PORTERVILLE COLLEGE SPORTS COMPLEX - PHASE 1
KERN COMMUNITY COLLEGE DISTRICT
PORTERVILLE, CA. Project

PARTIAL IRRIGATION PLAN
Drawing

darden architects ARCHITECTURE PLANNING INTERIORS
www.dardenarchitects.com
6790 N. West Ave. • Fresno, CA 93711 • T. 559.448.8051







Architect

Revision	Date
ADDENDA 2	01/10/24

Revision

Scale: 1" = 20'-0"	Designed By:	Copyright Darden Architects
Project Number: 2118	Drawn By:	AD2-LX-04
Date: 05-10-23	Checked By:	SD/L302
	Reviewed By:	AD2-LX-04







PARTIAL IRRIGATION PLAN
1" = 20'-0"

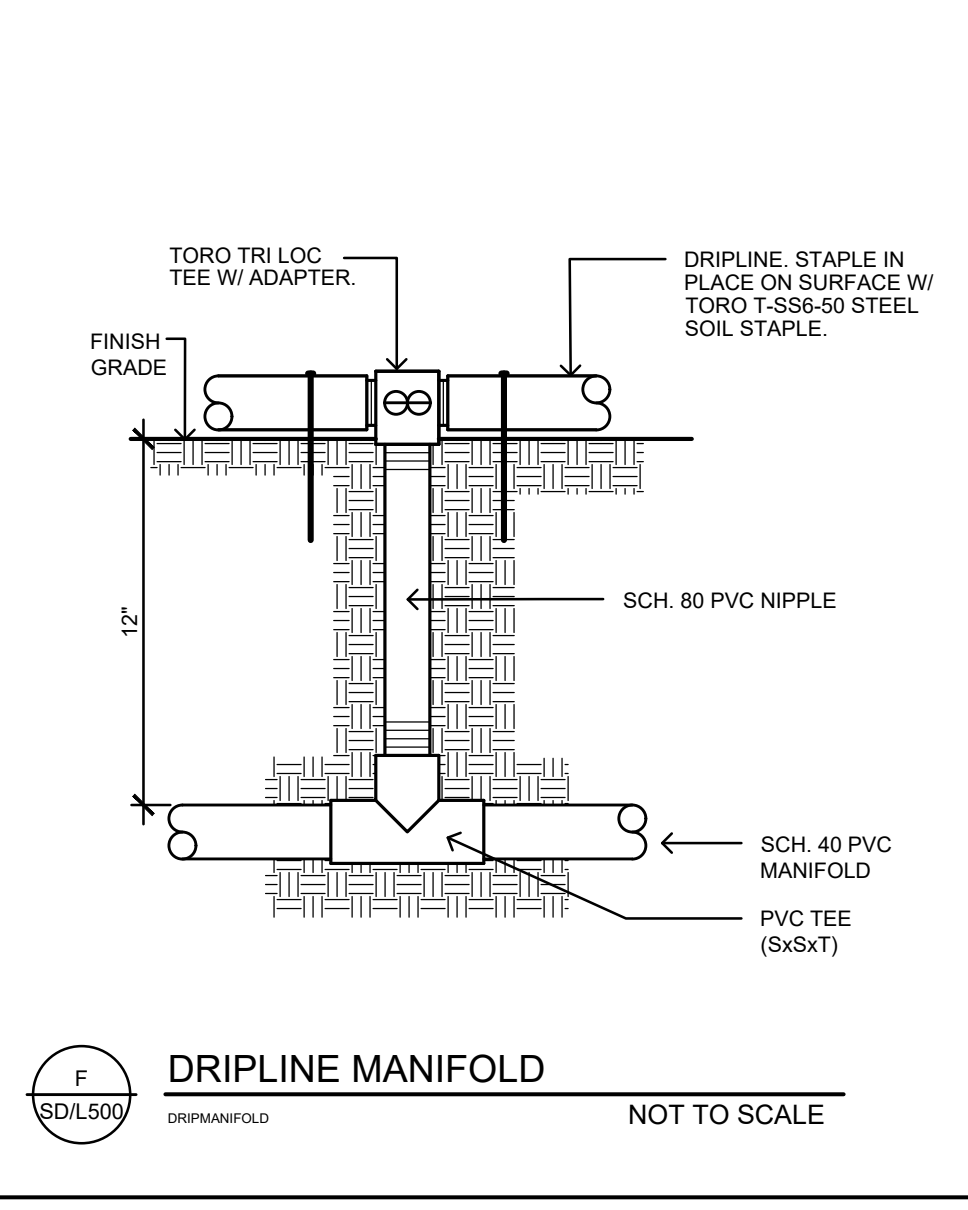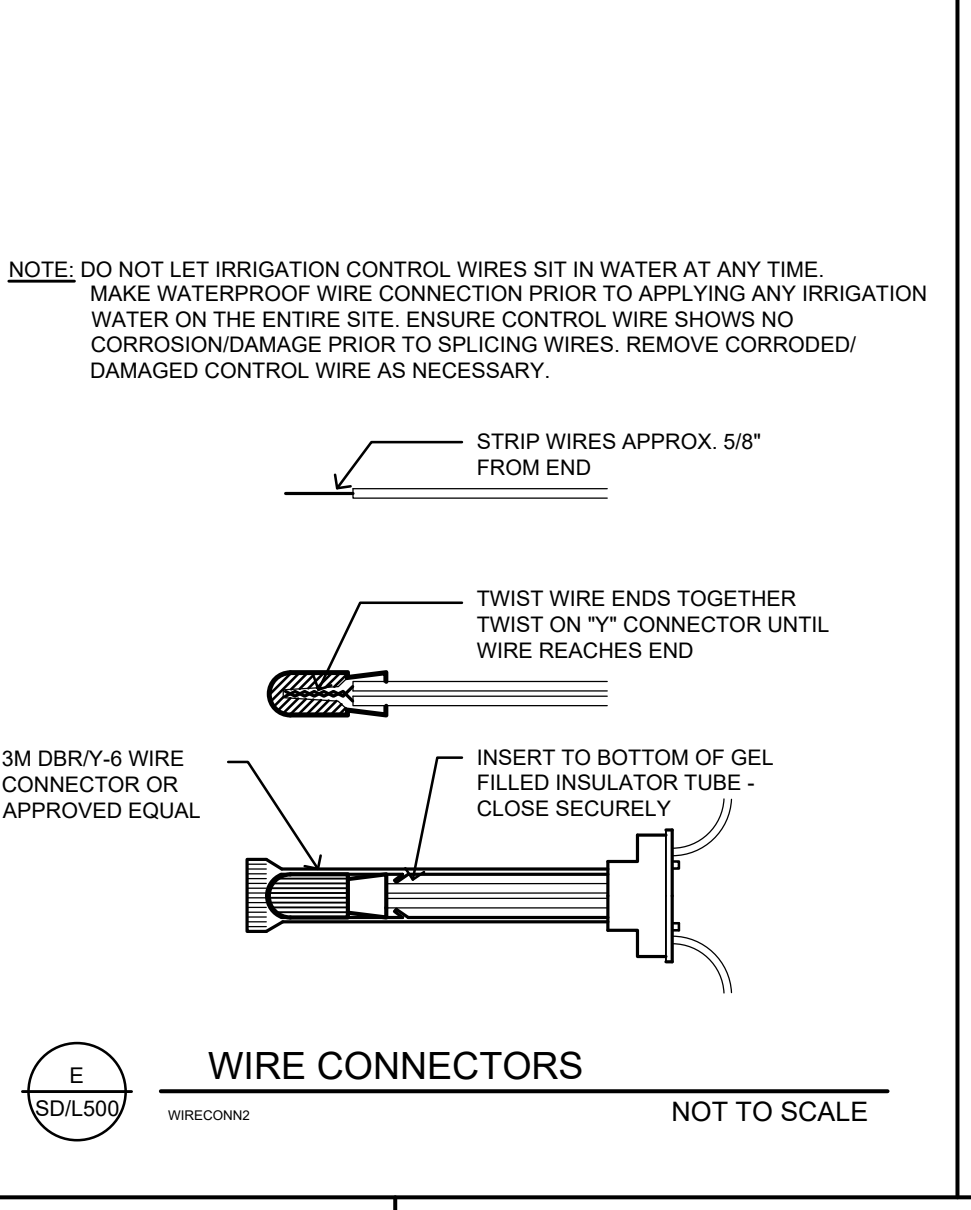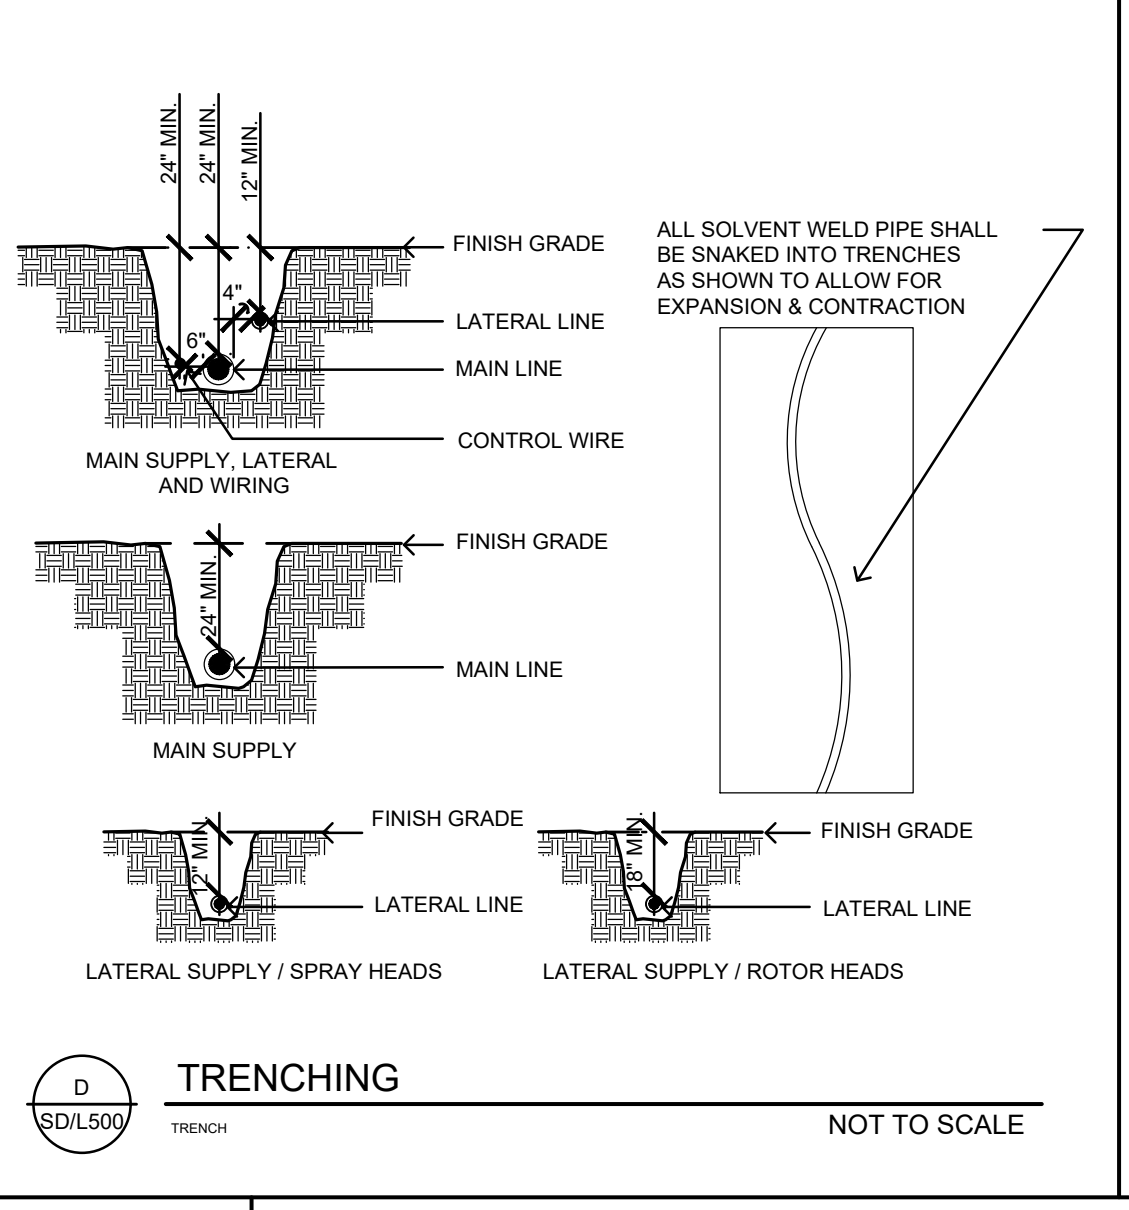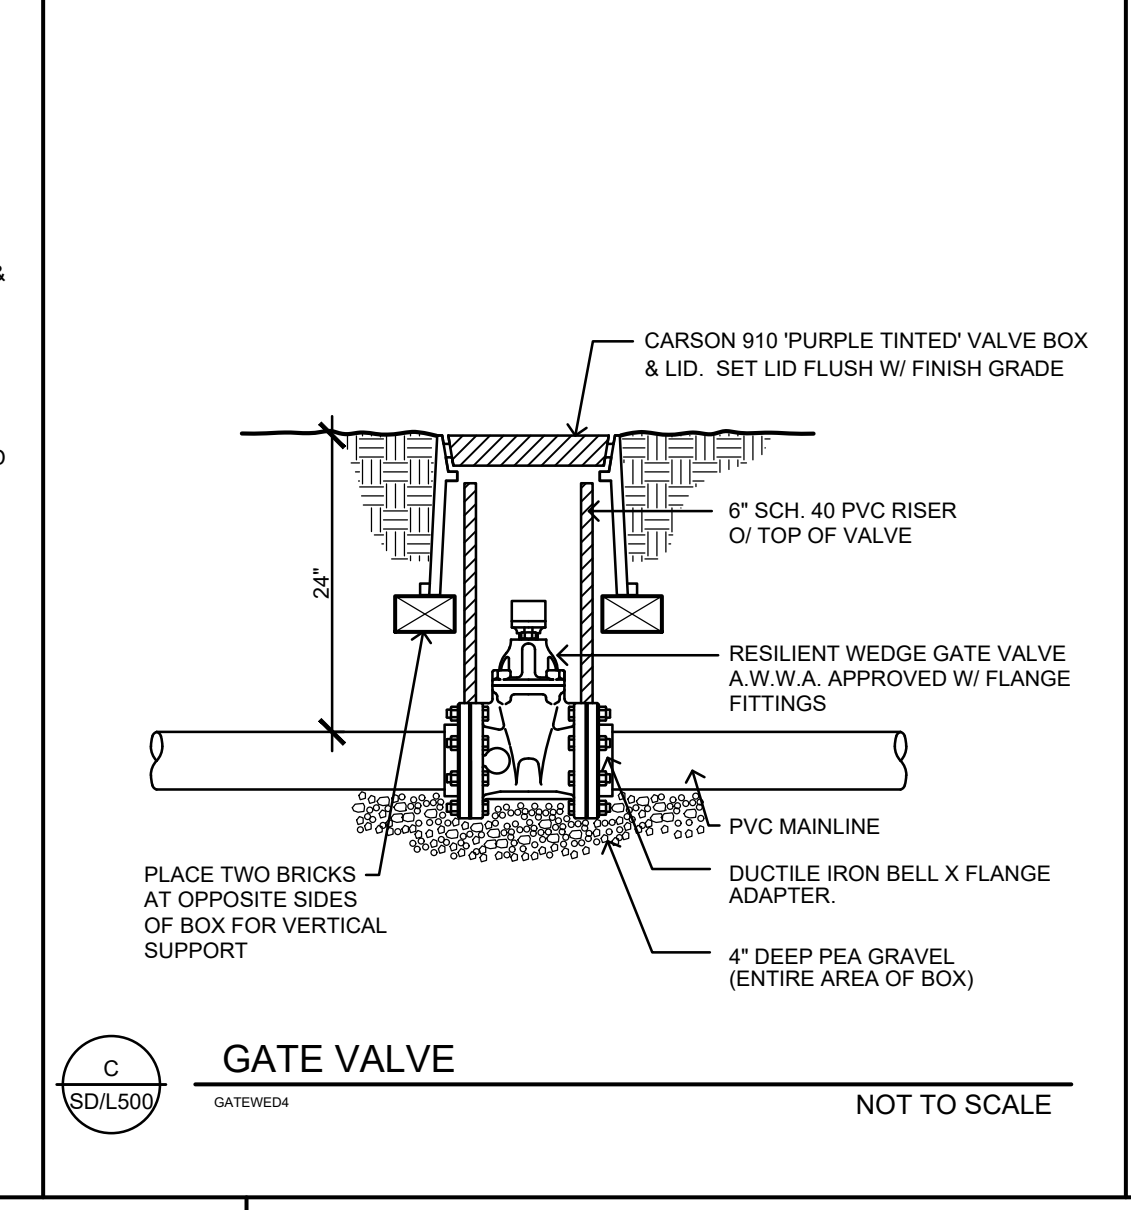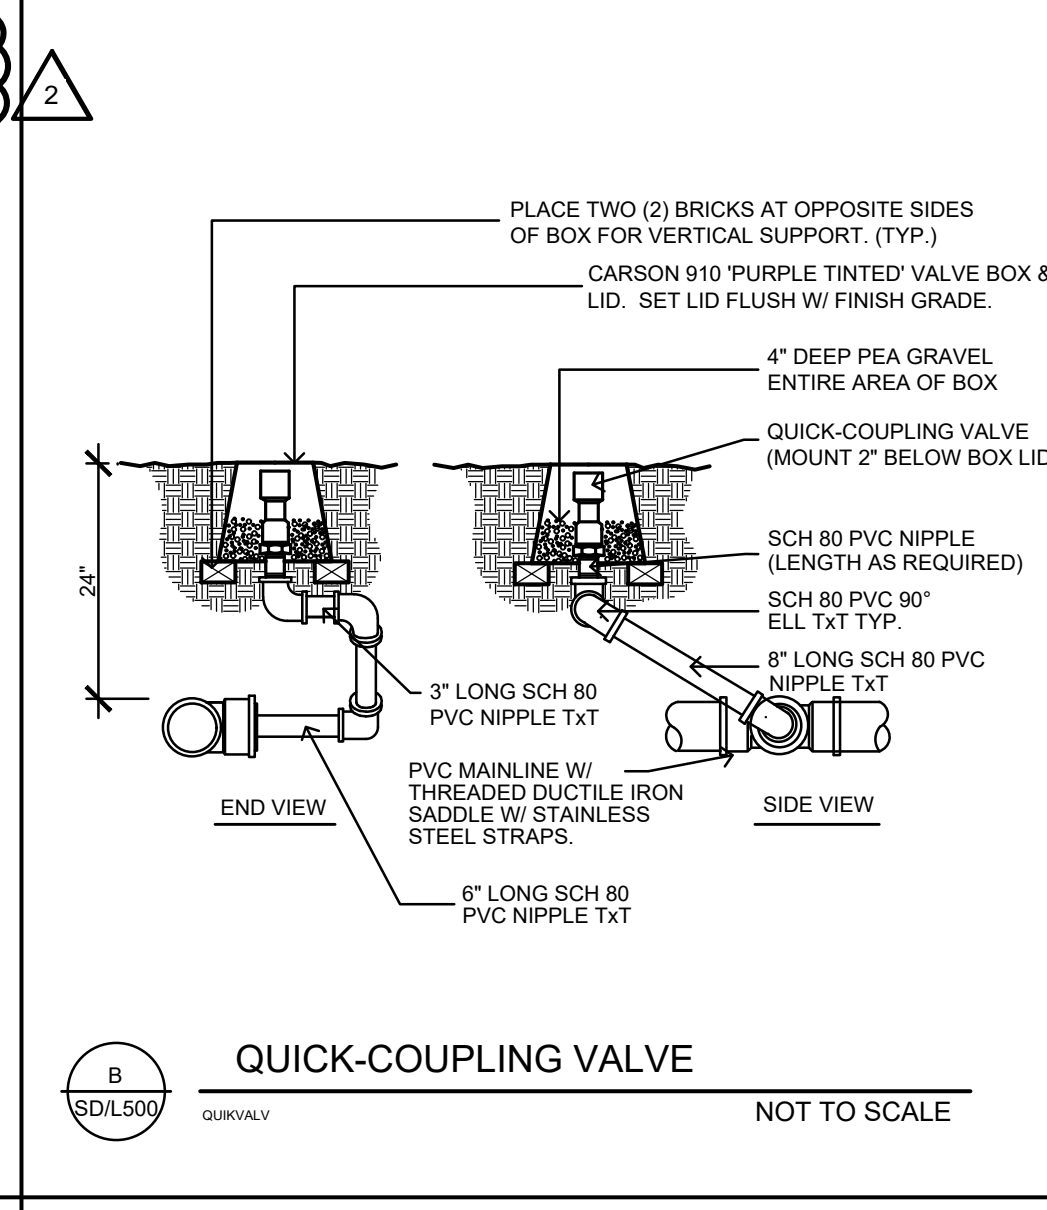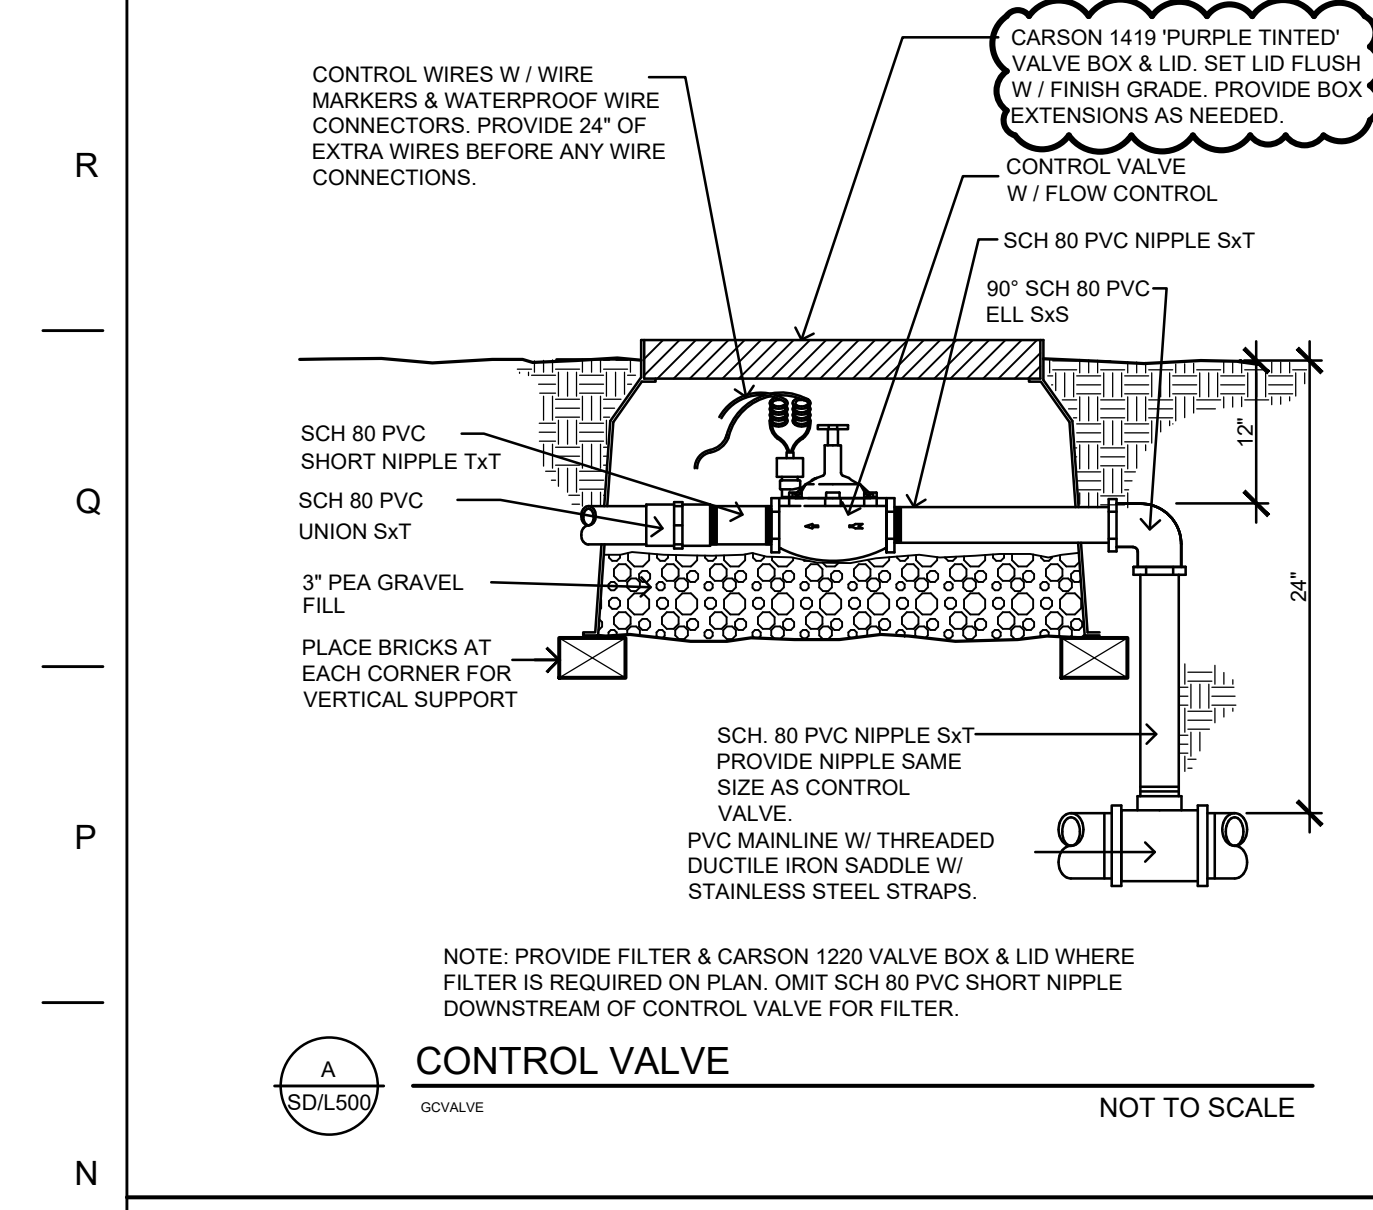







DSA File No.:

DSA Application No.: 03-122694

Agency Approval

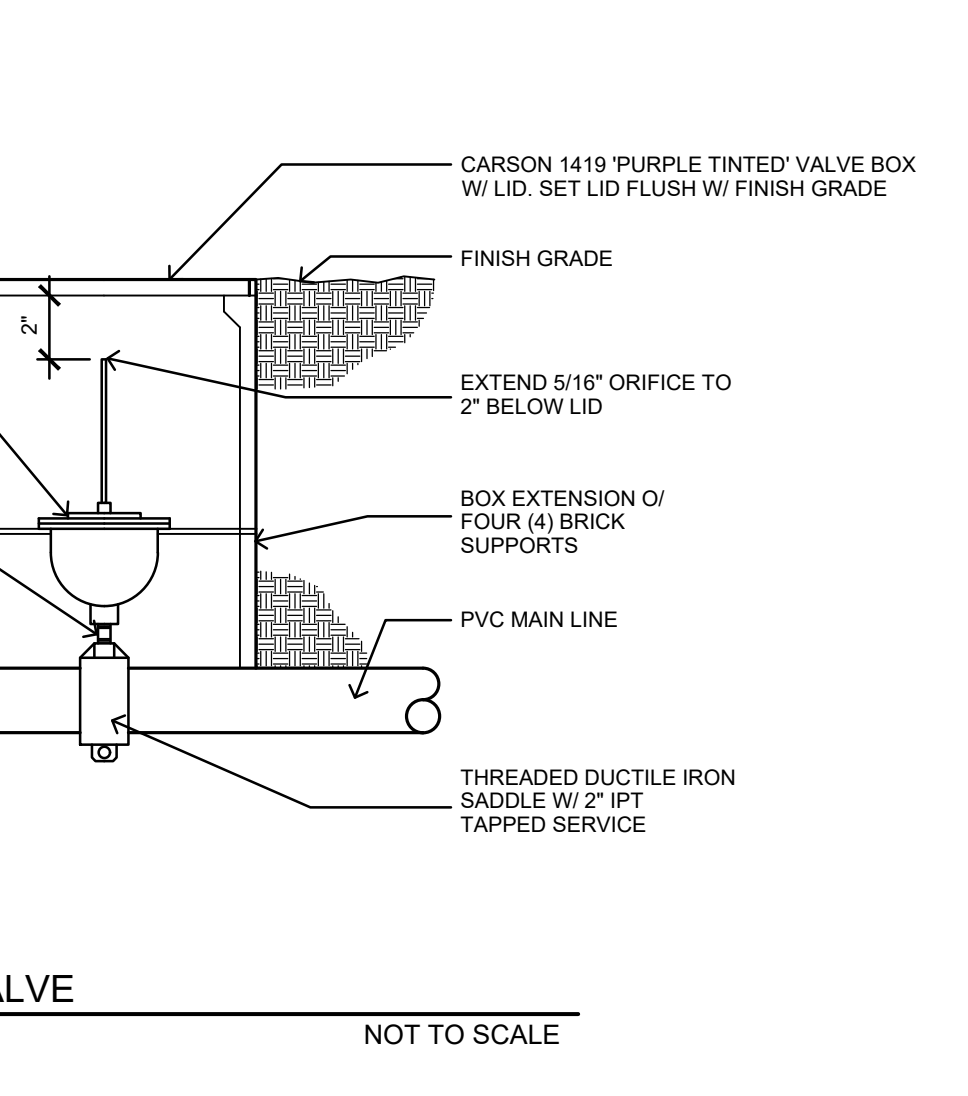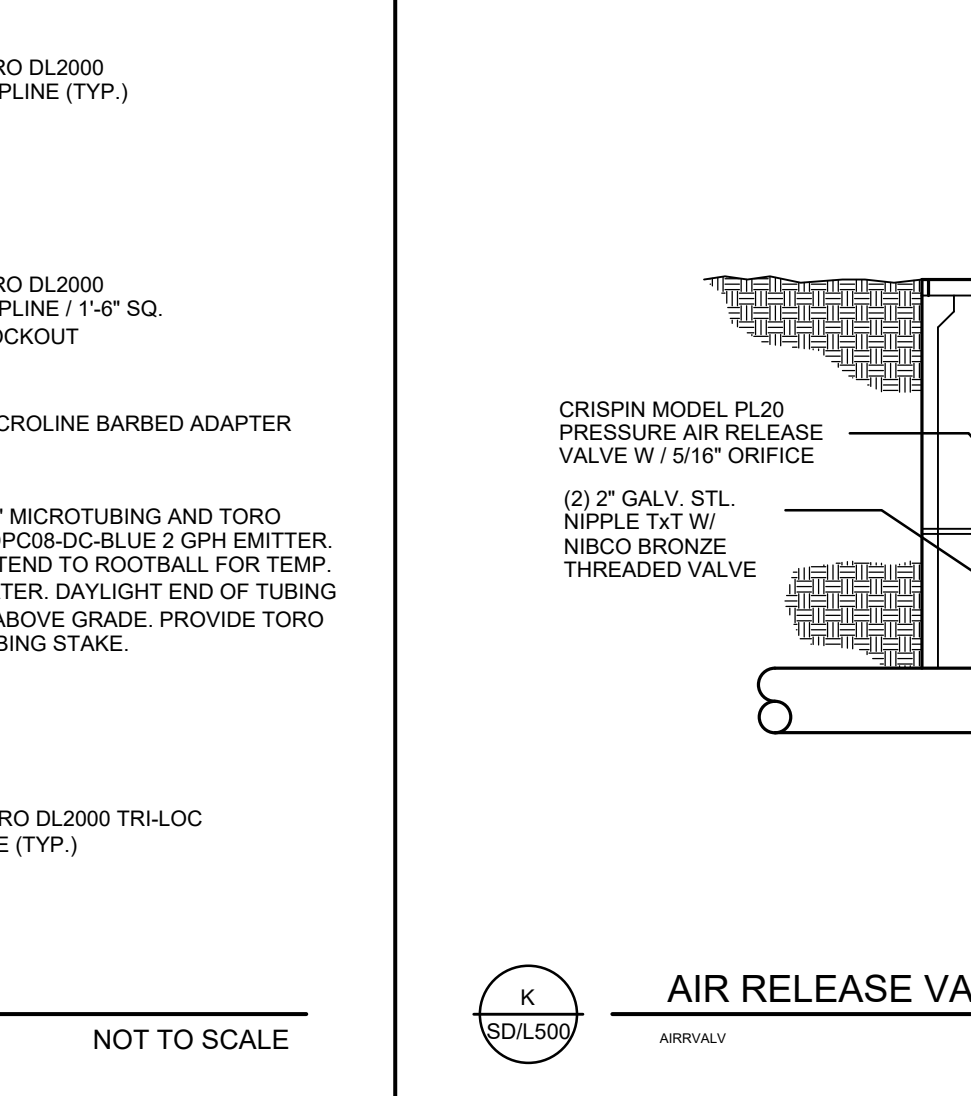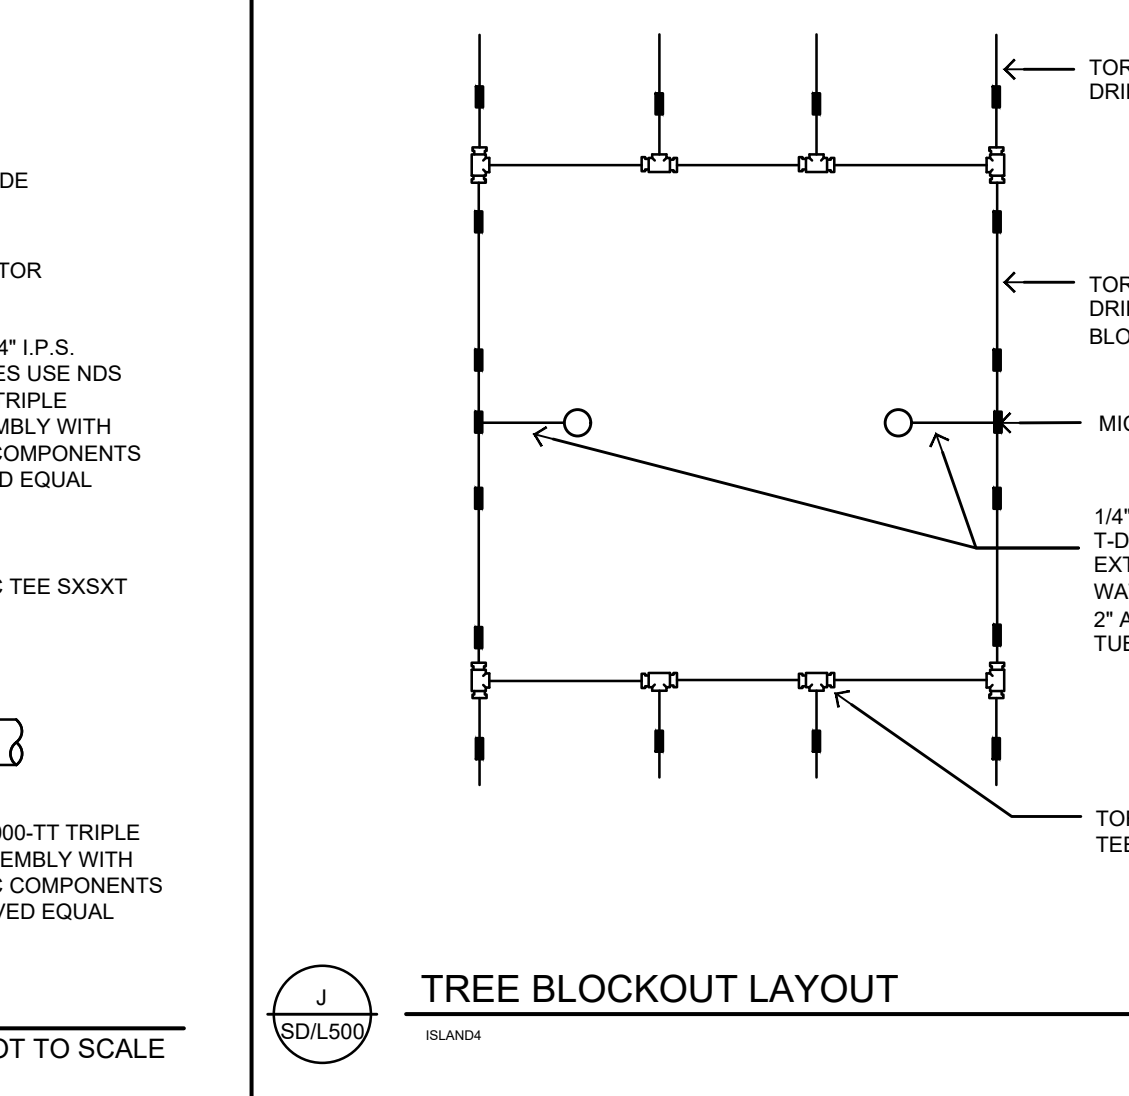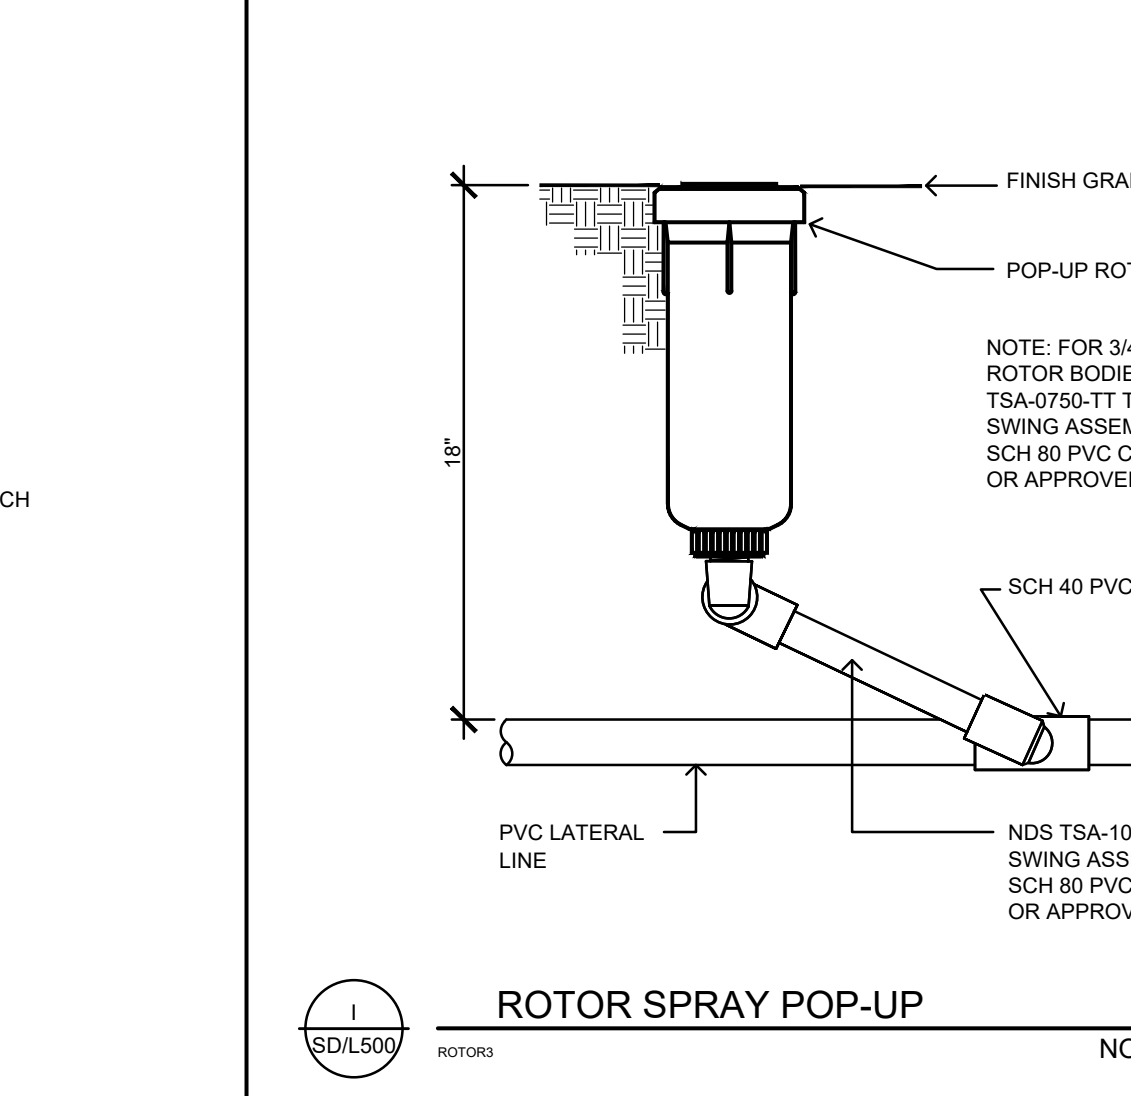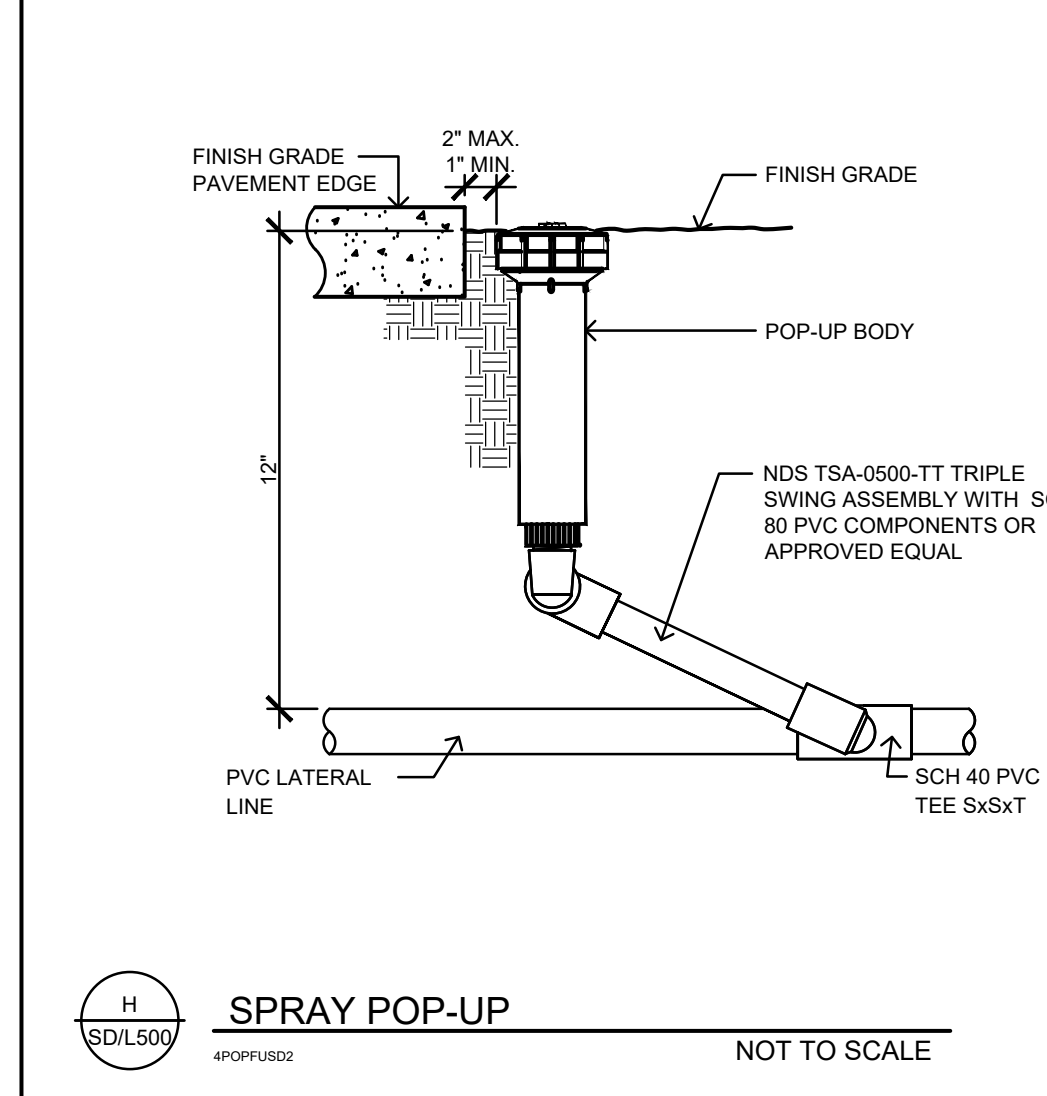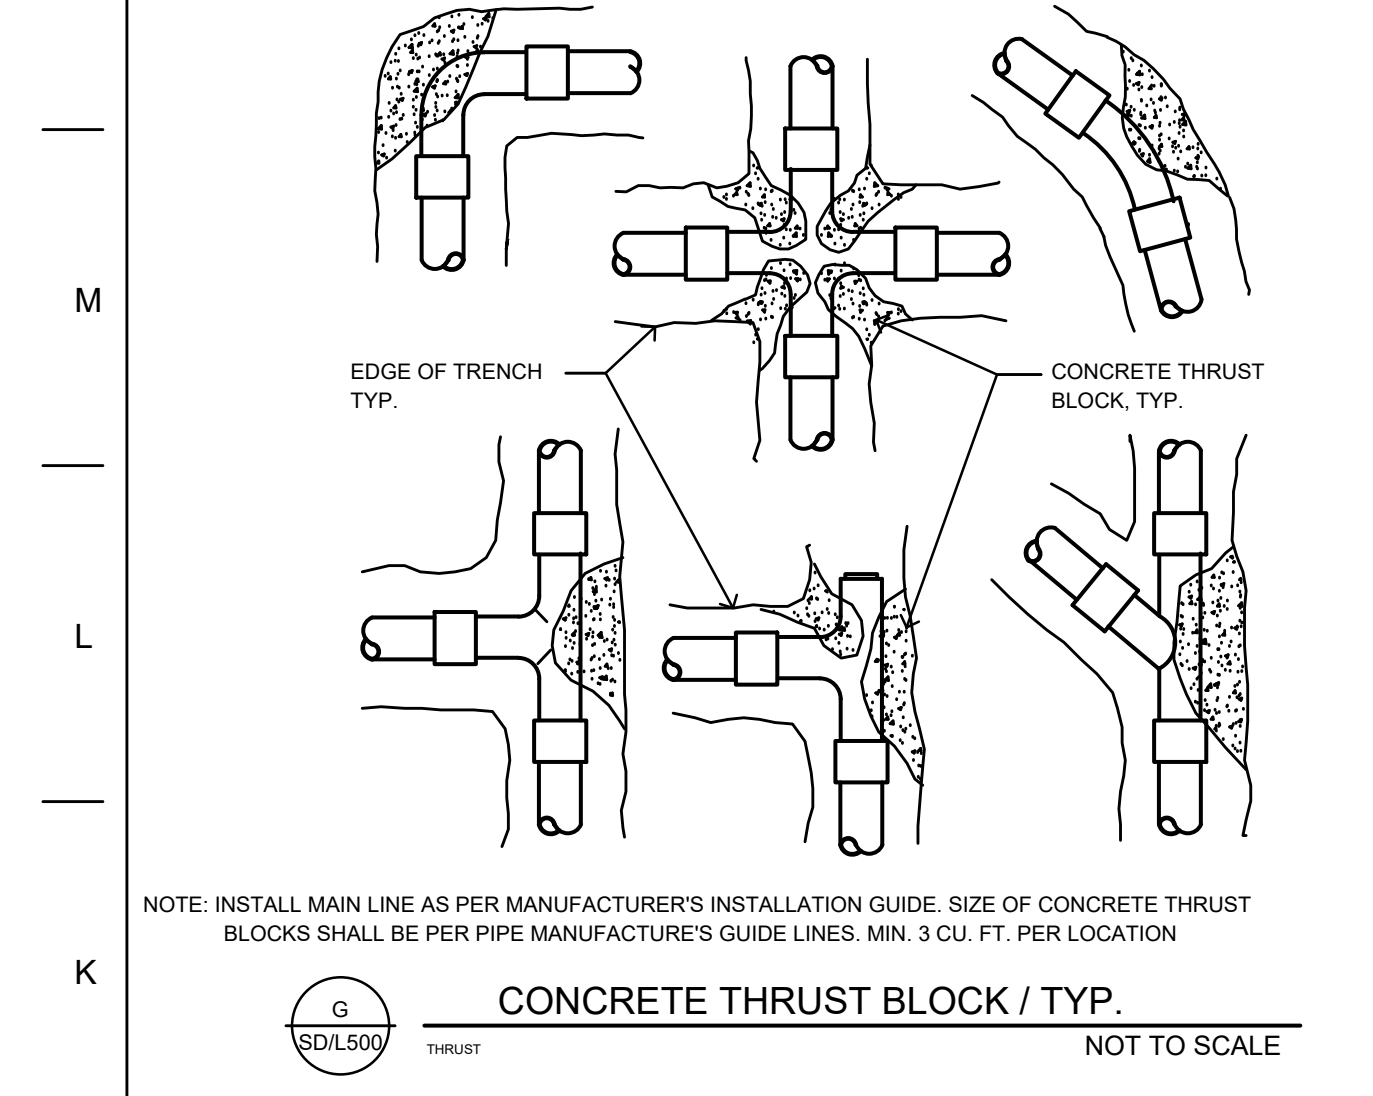







General Notes

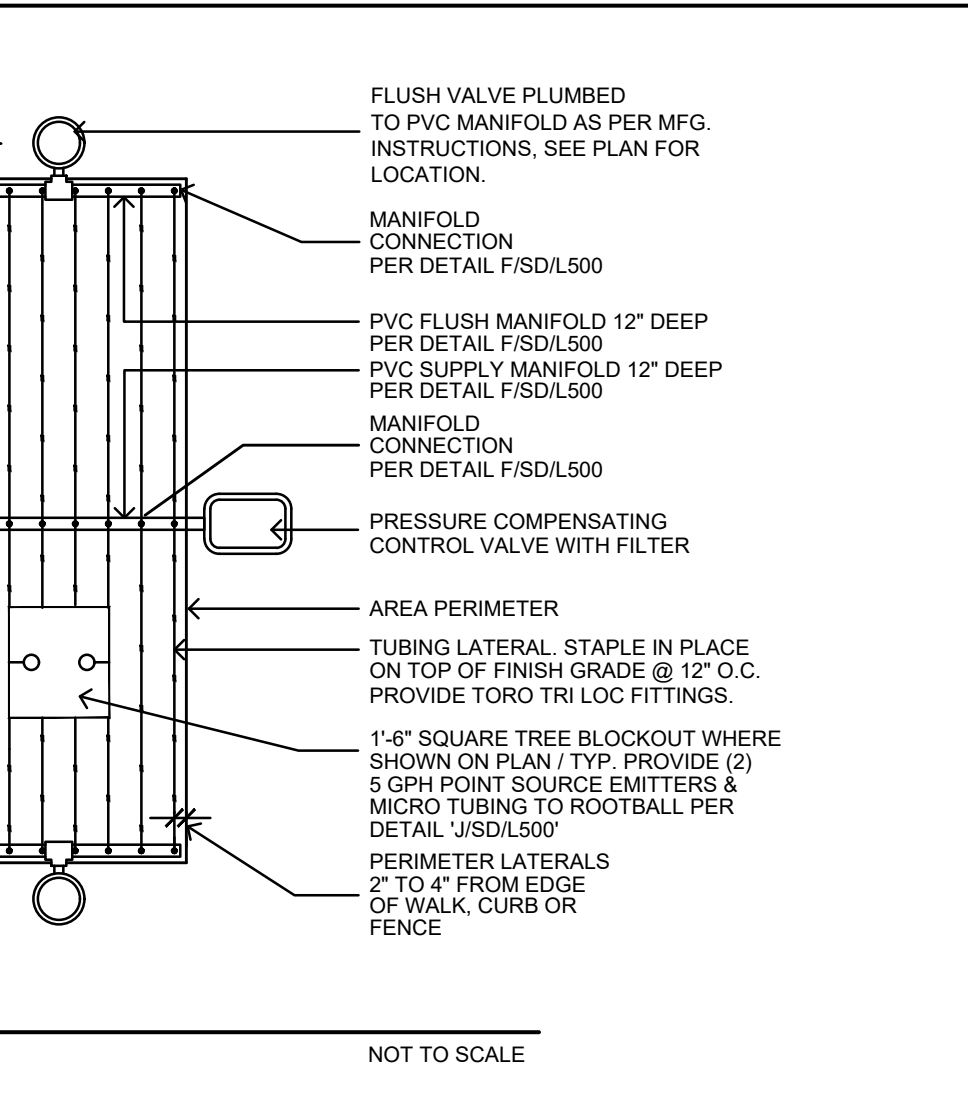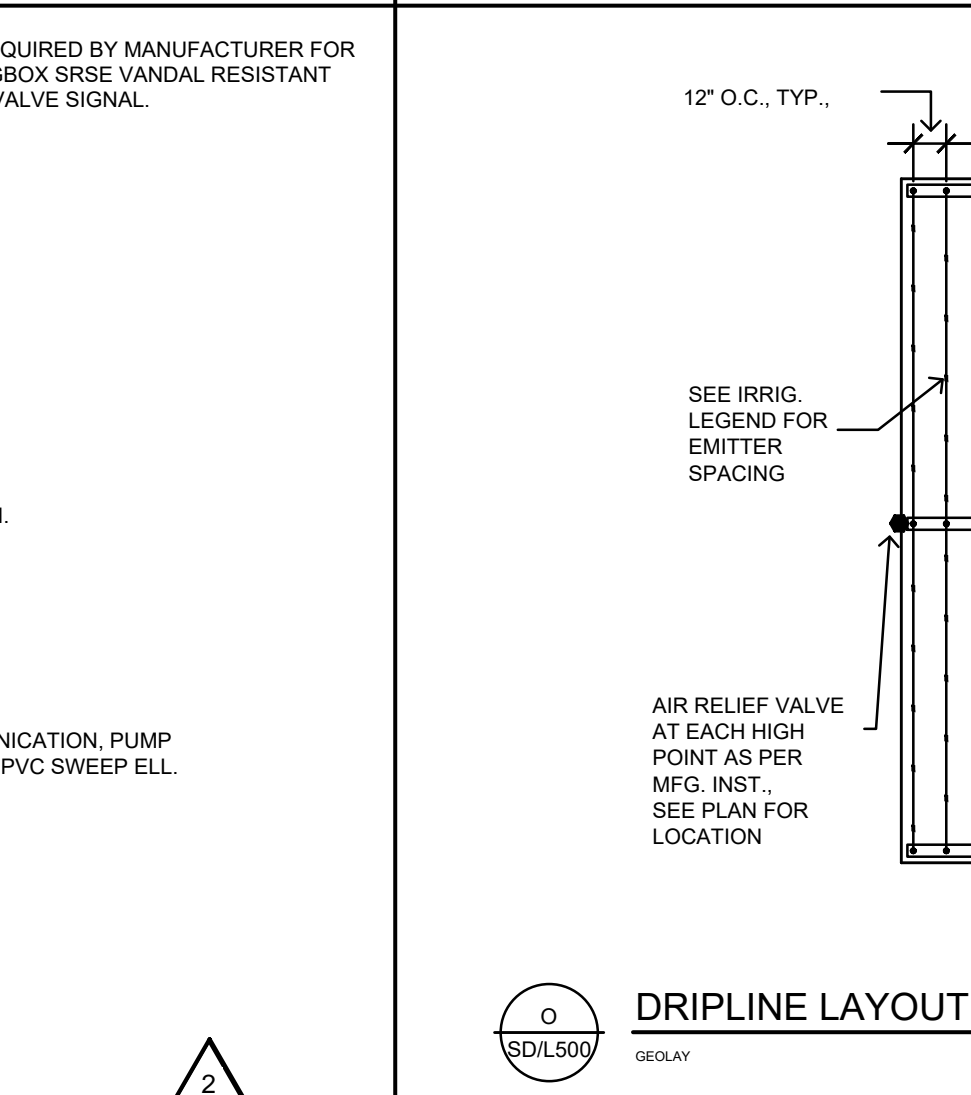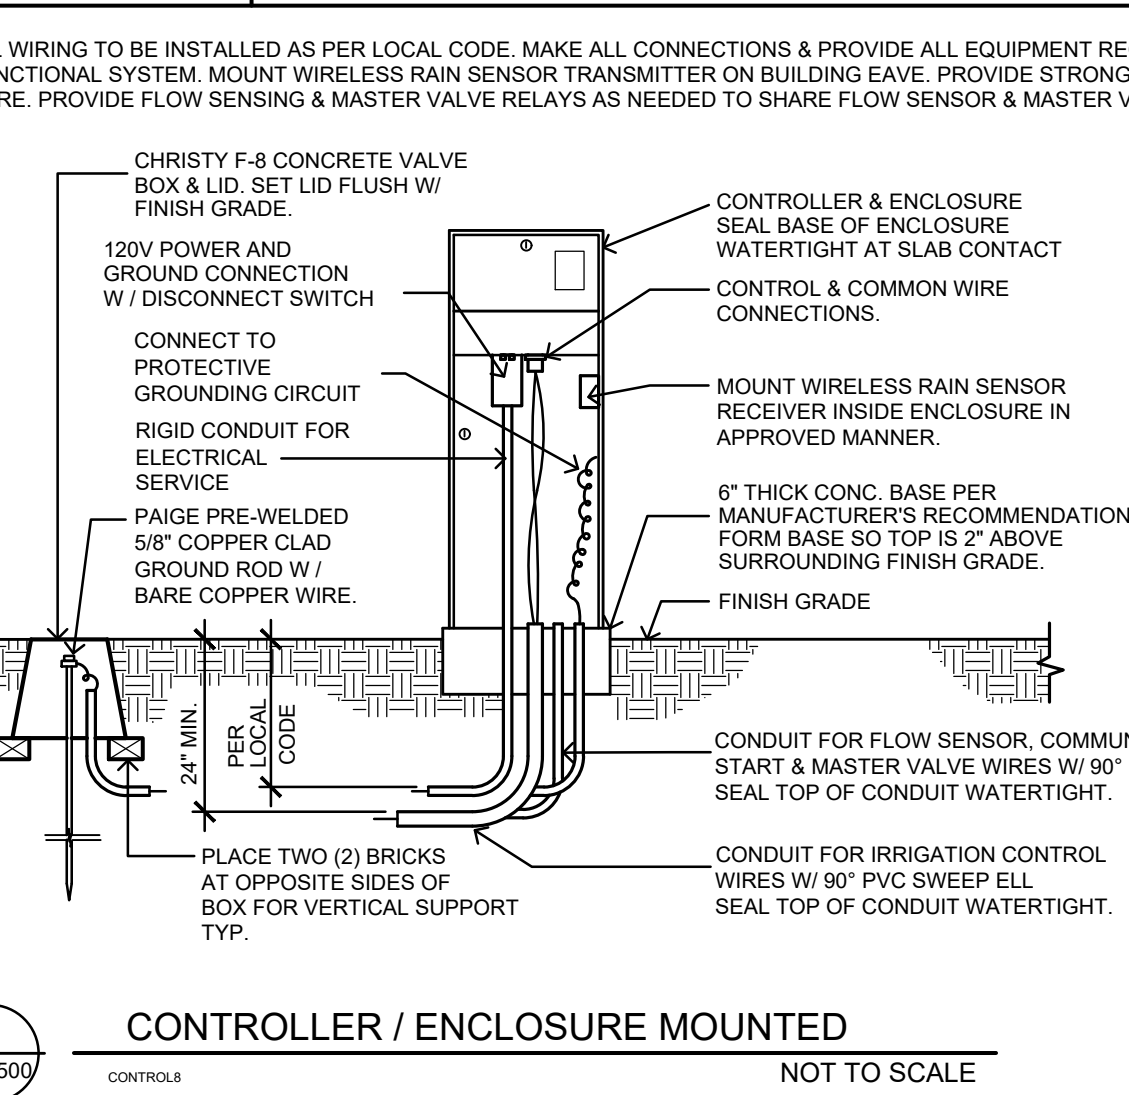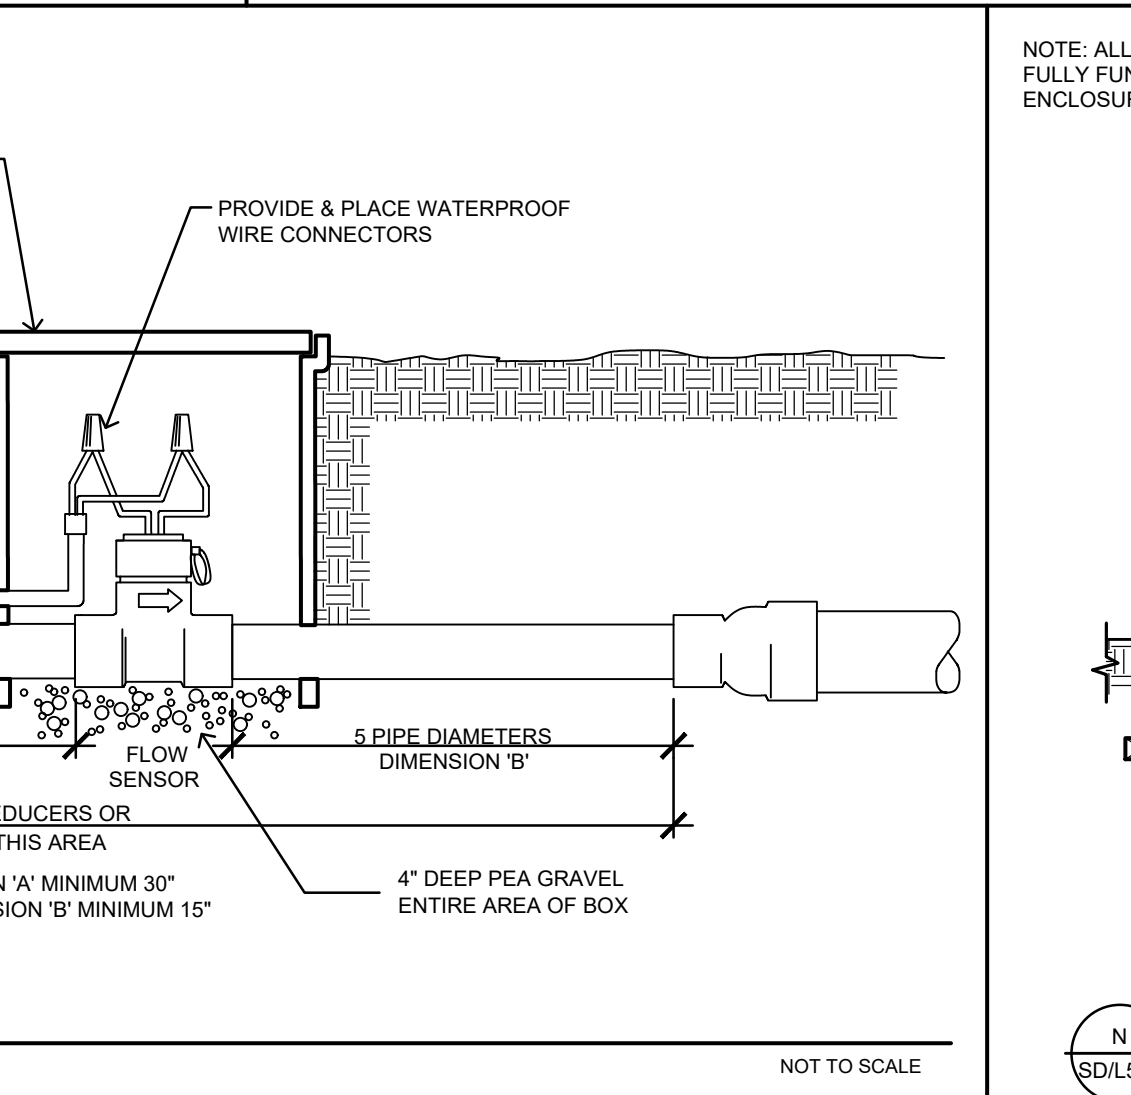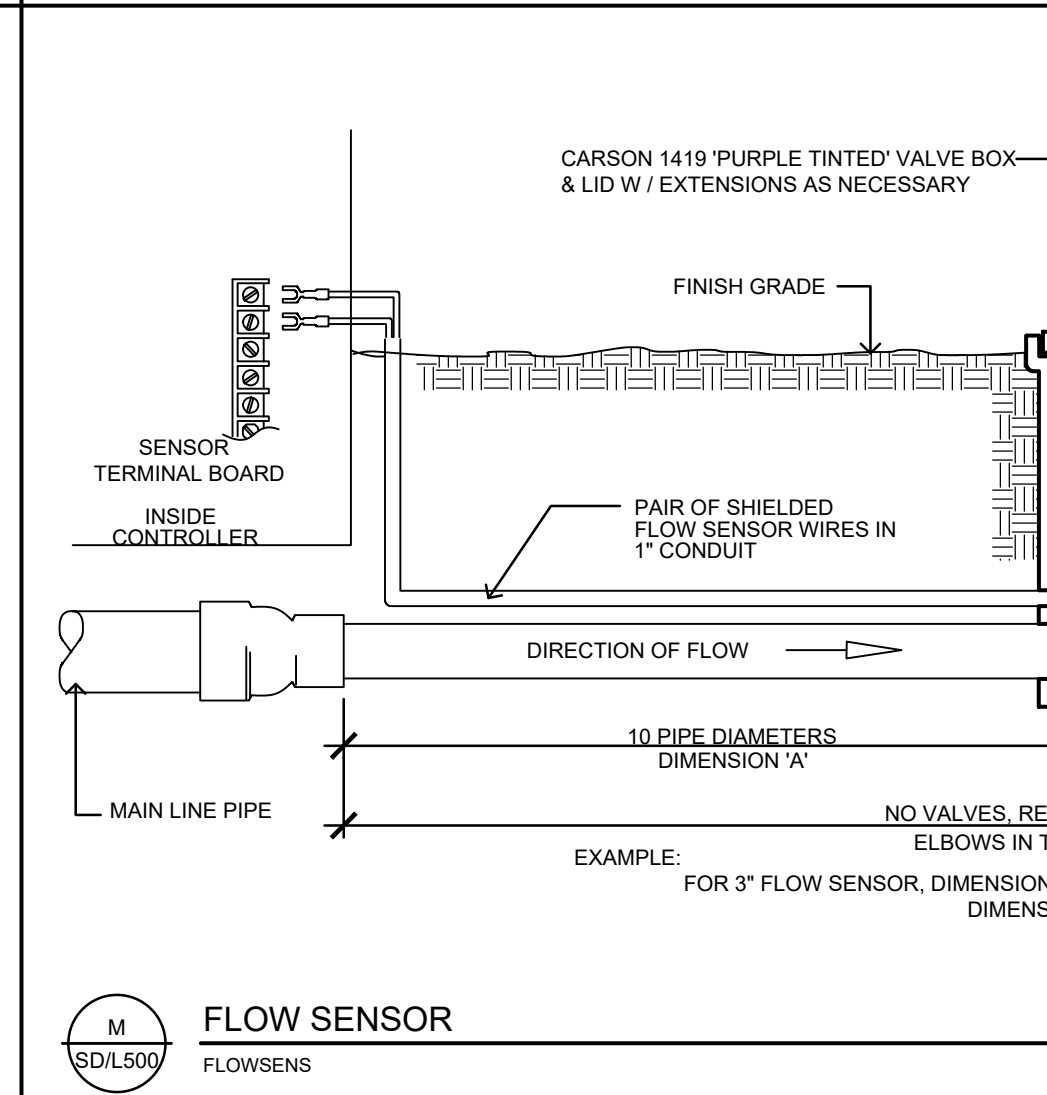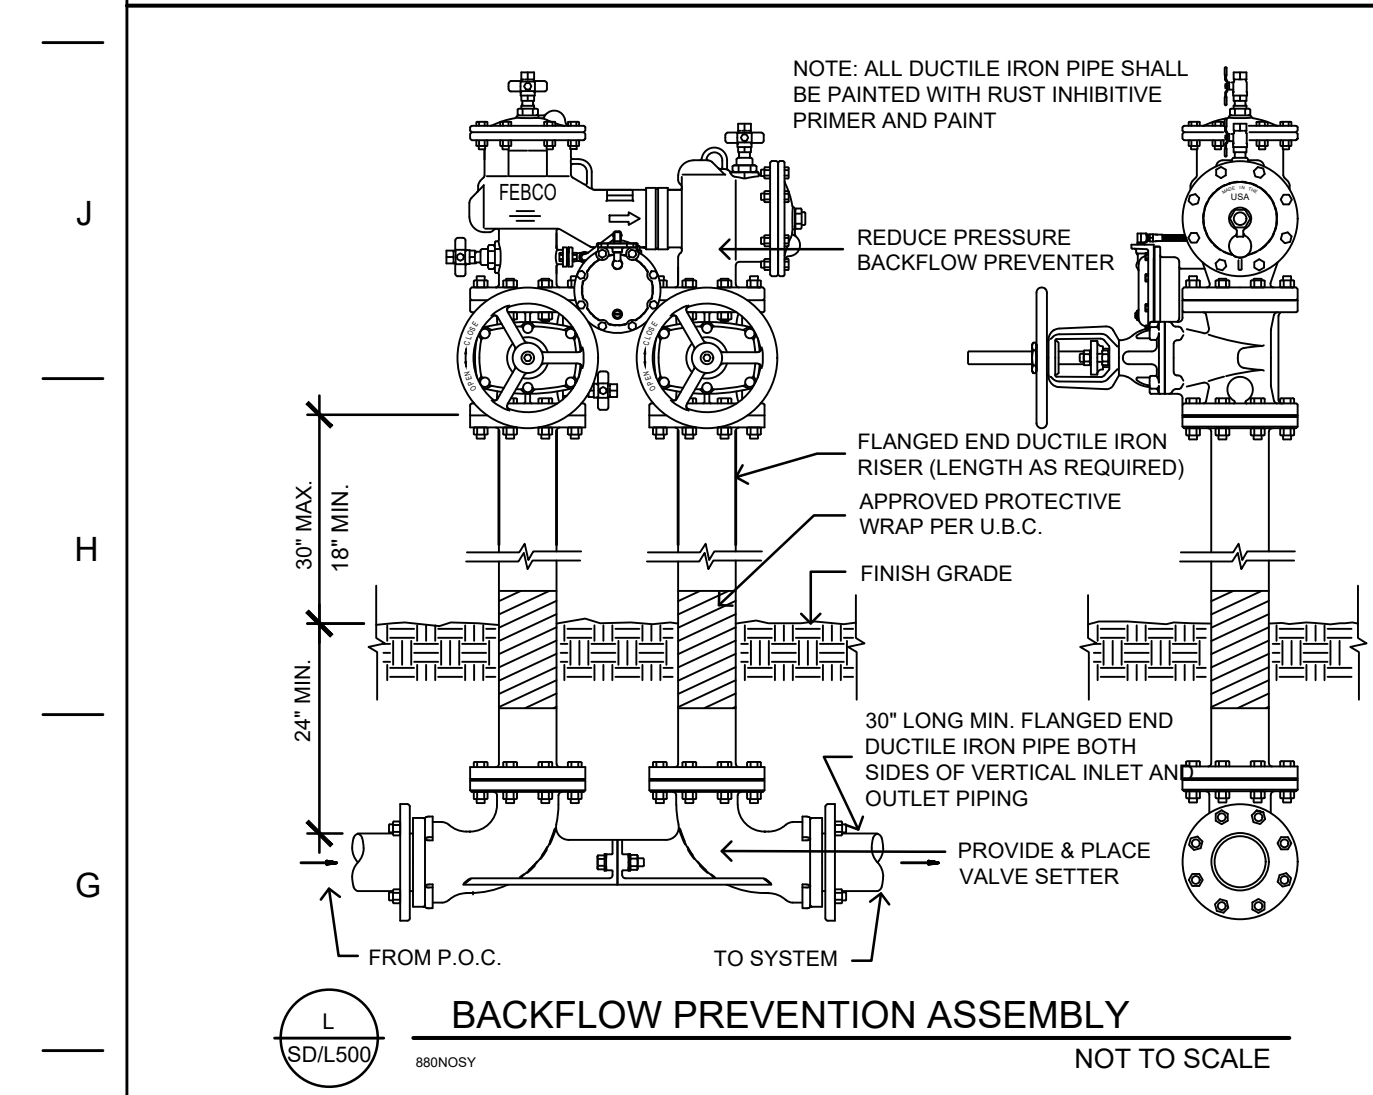

Consultant

PORTERVILLE COLLEGE SPORTS COMPLEX - PHASE 1
KERN COMMUNITY COLLEGE DISTRICT
PORTERVILLE, CA.

Project

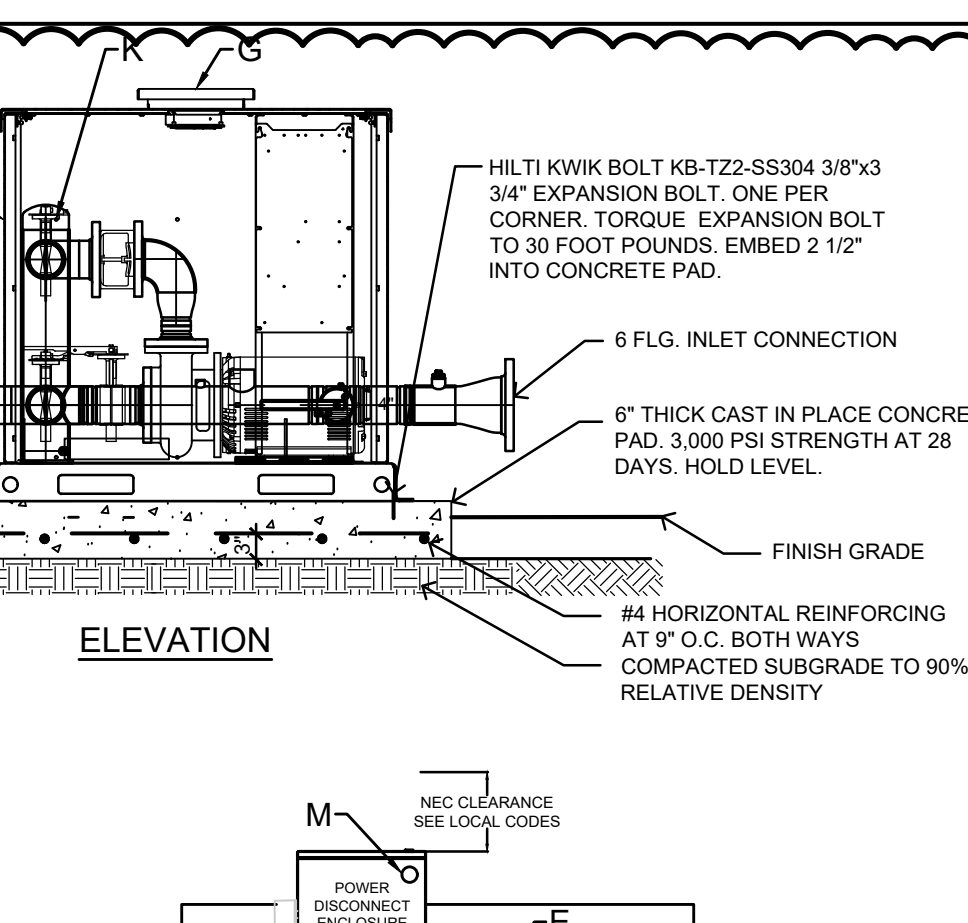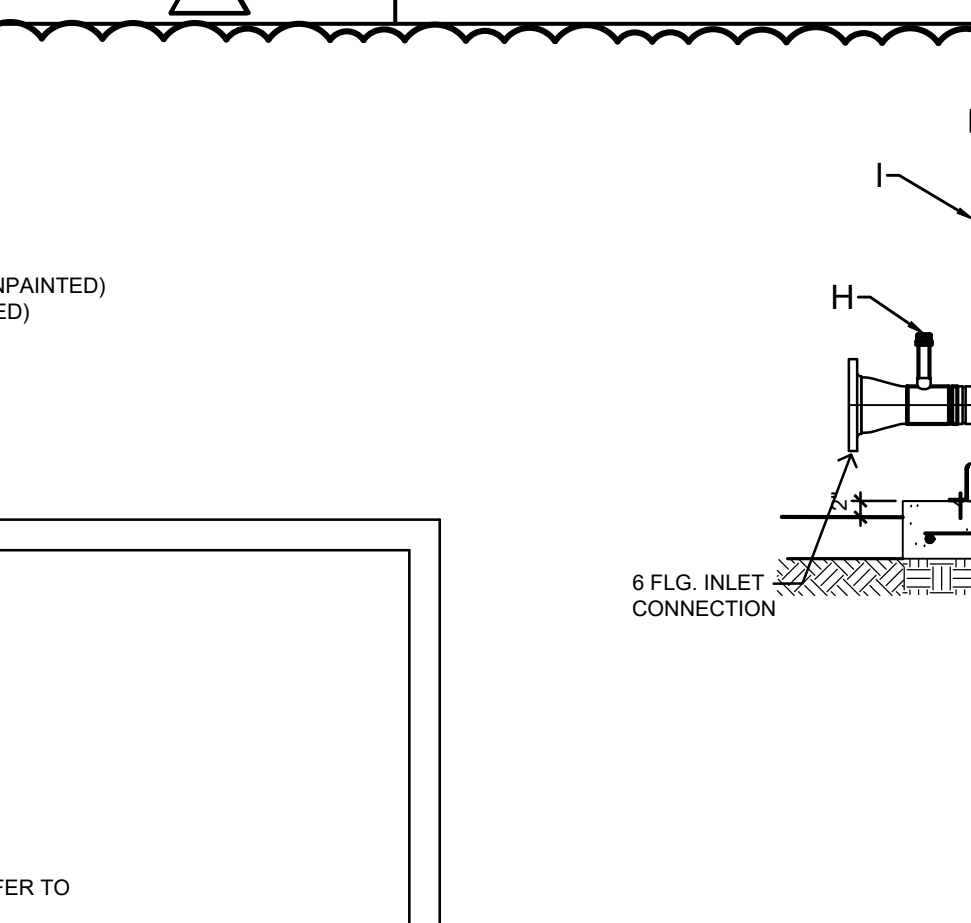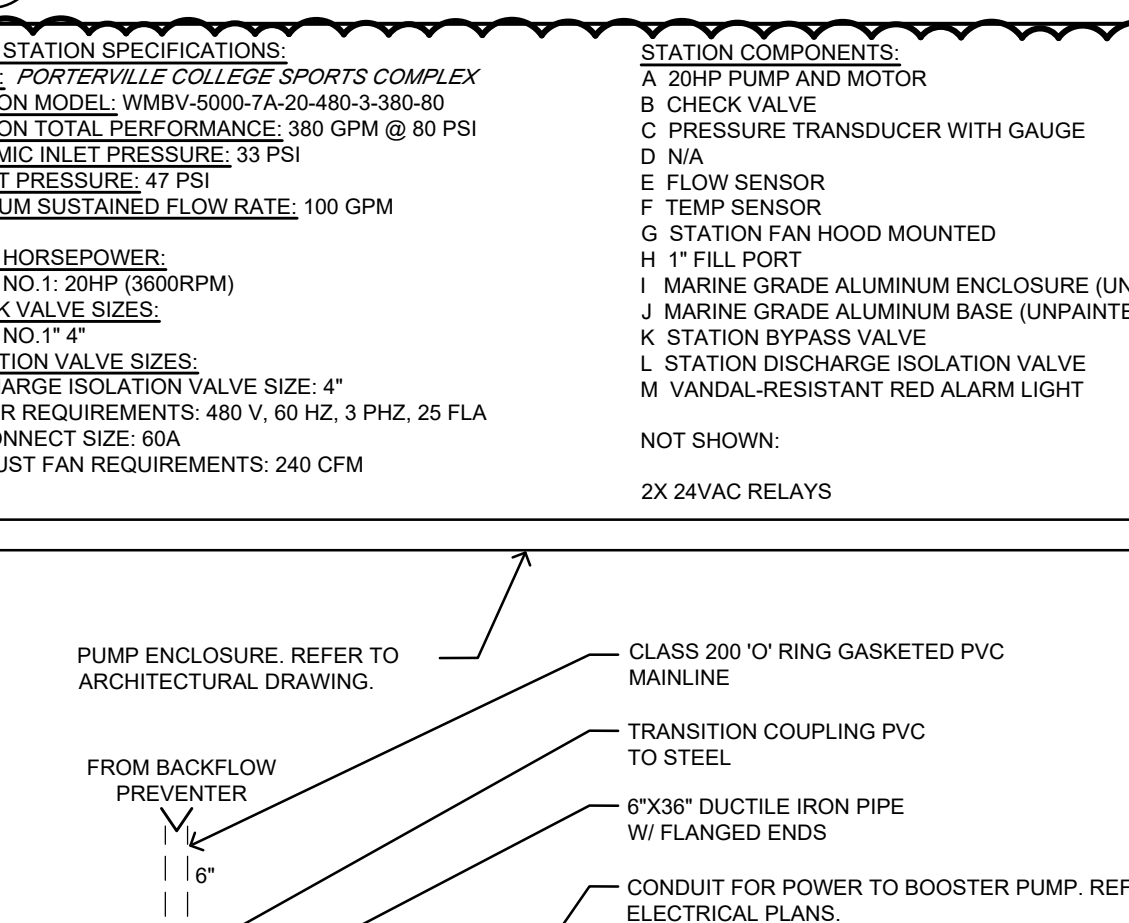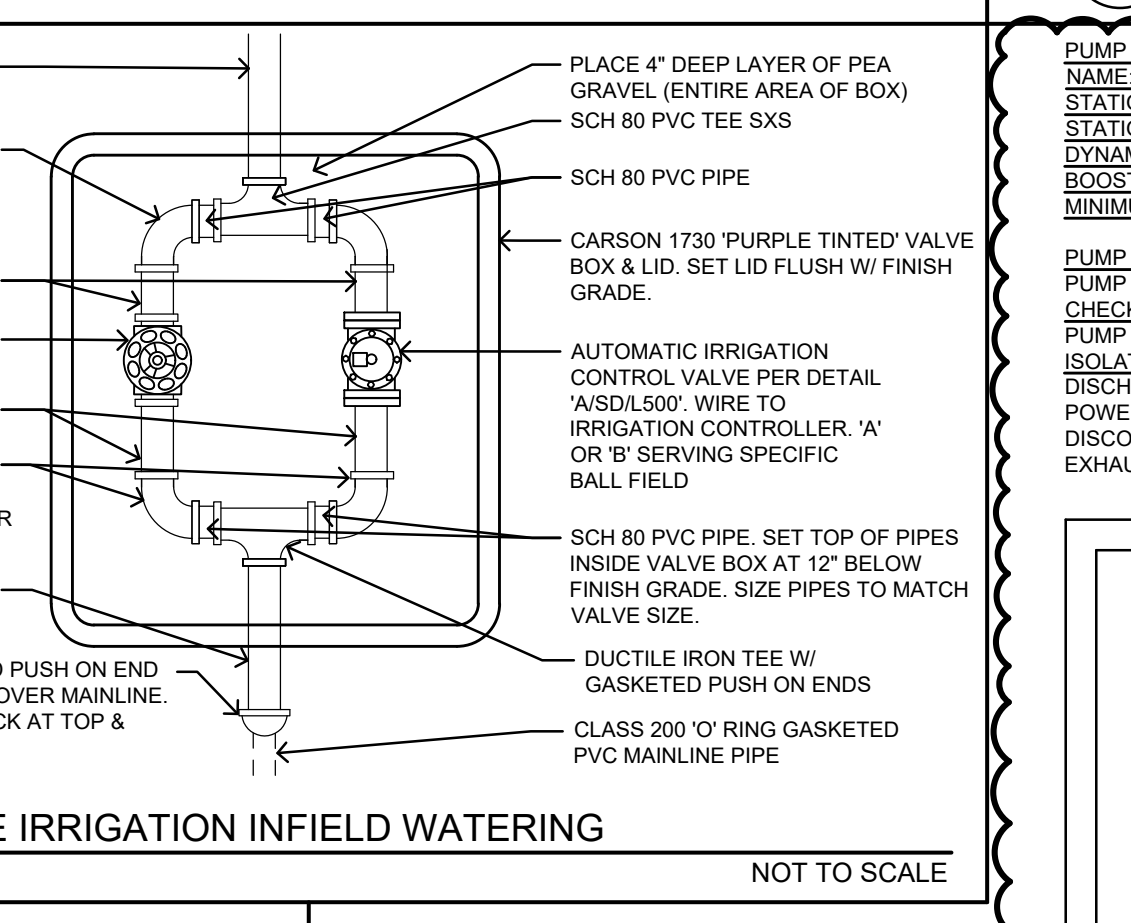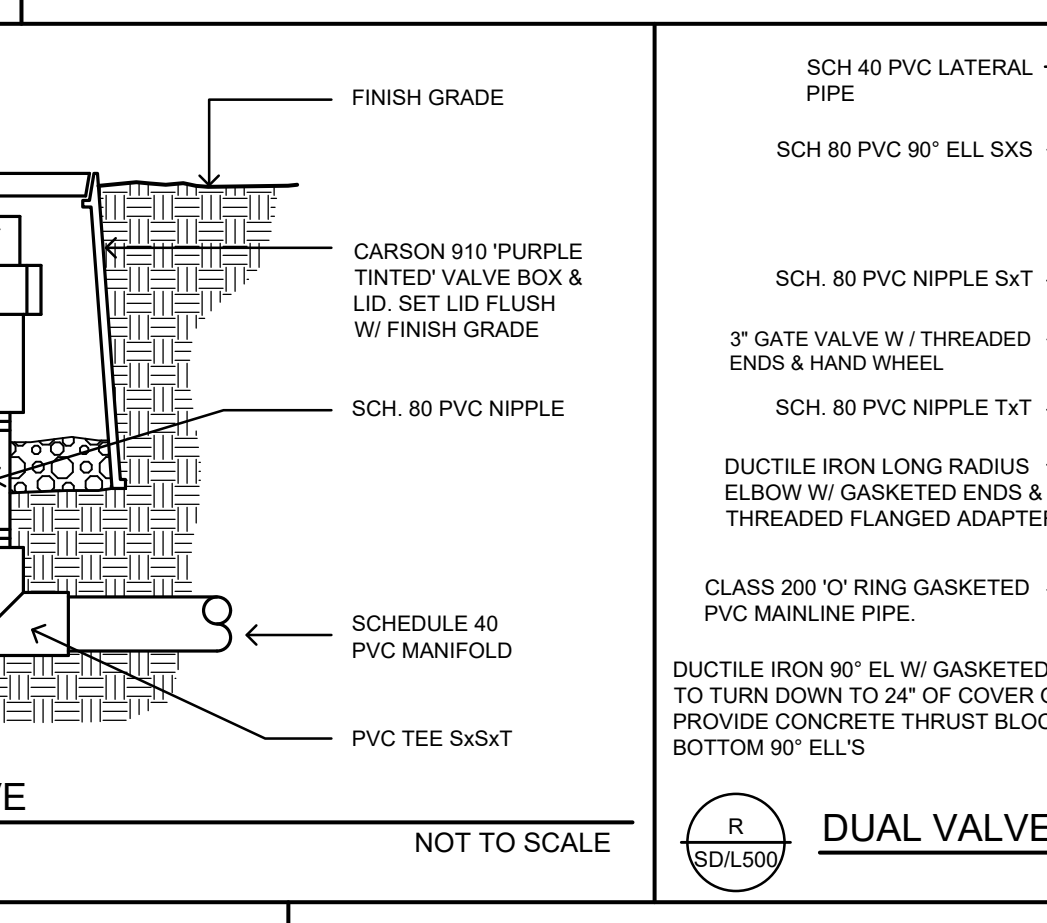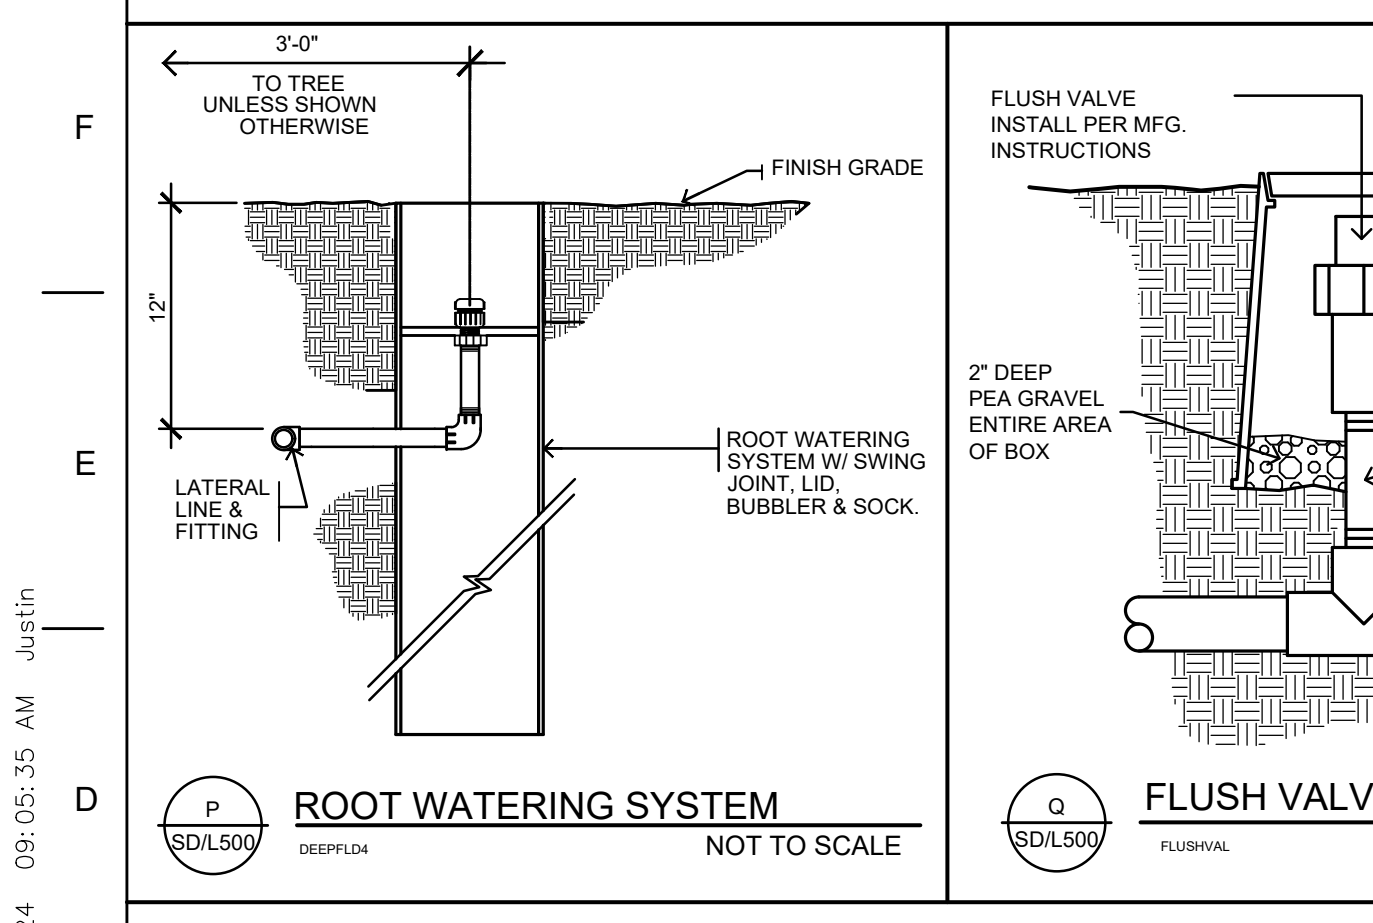

ARCHITECTURE

PLANNING







INTERIORS

architects

www.dardenarchitects.com

6790 N. West Ave. • Fresno, CA 93711 • T. 559.448.8051

Architect

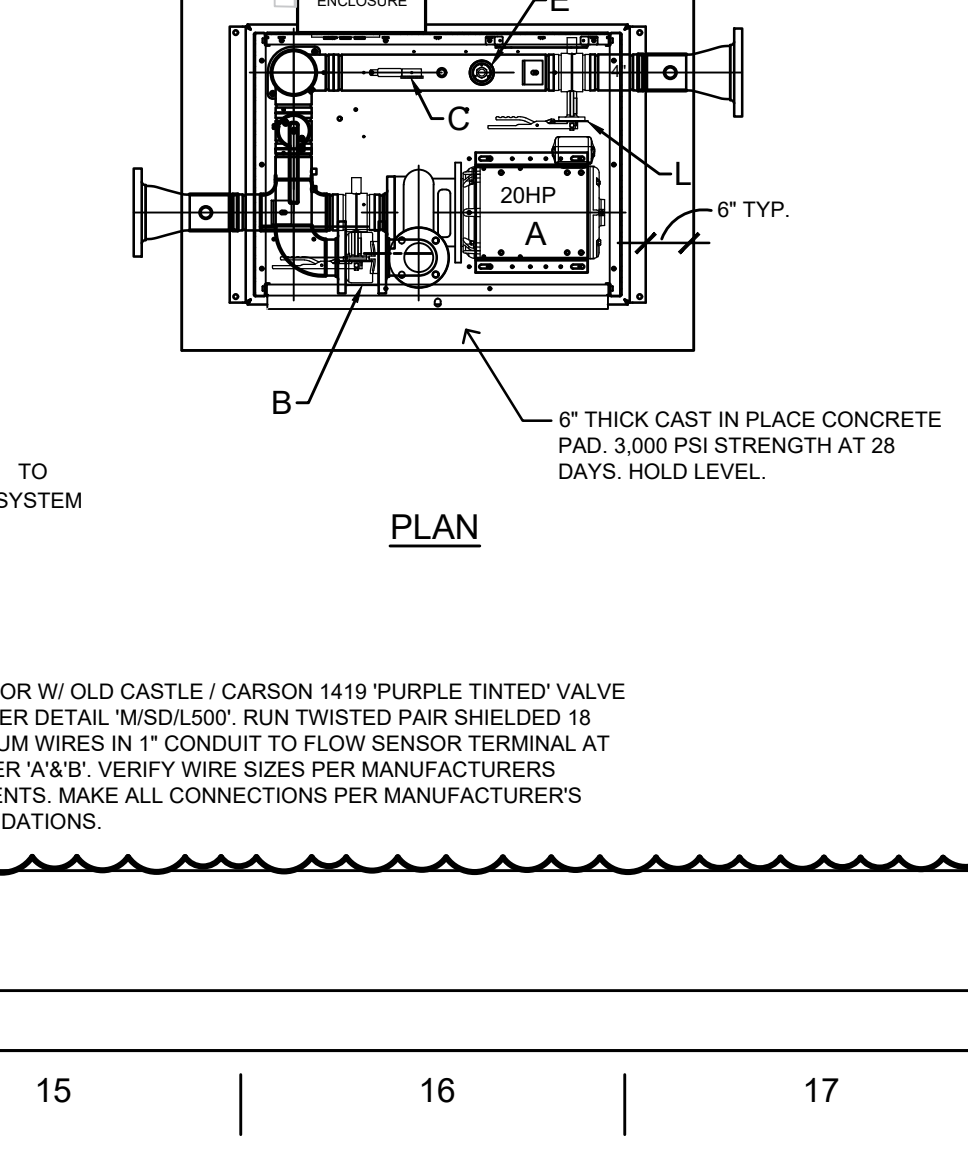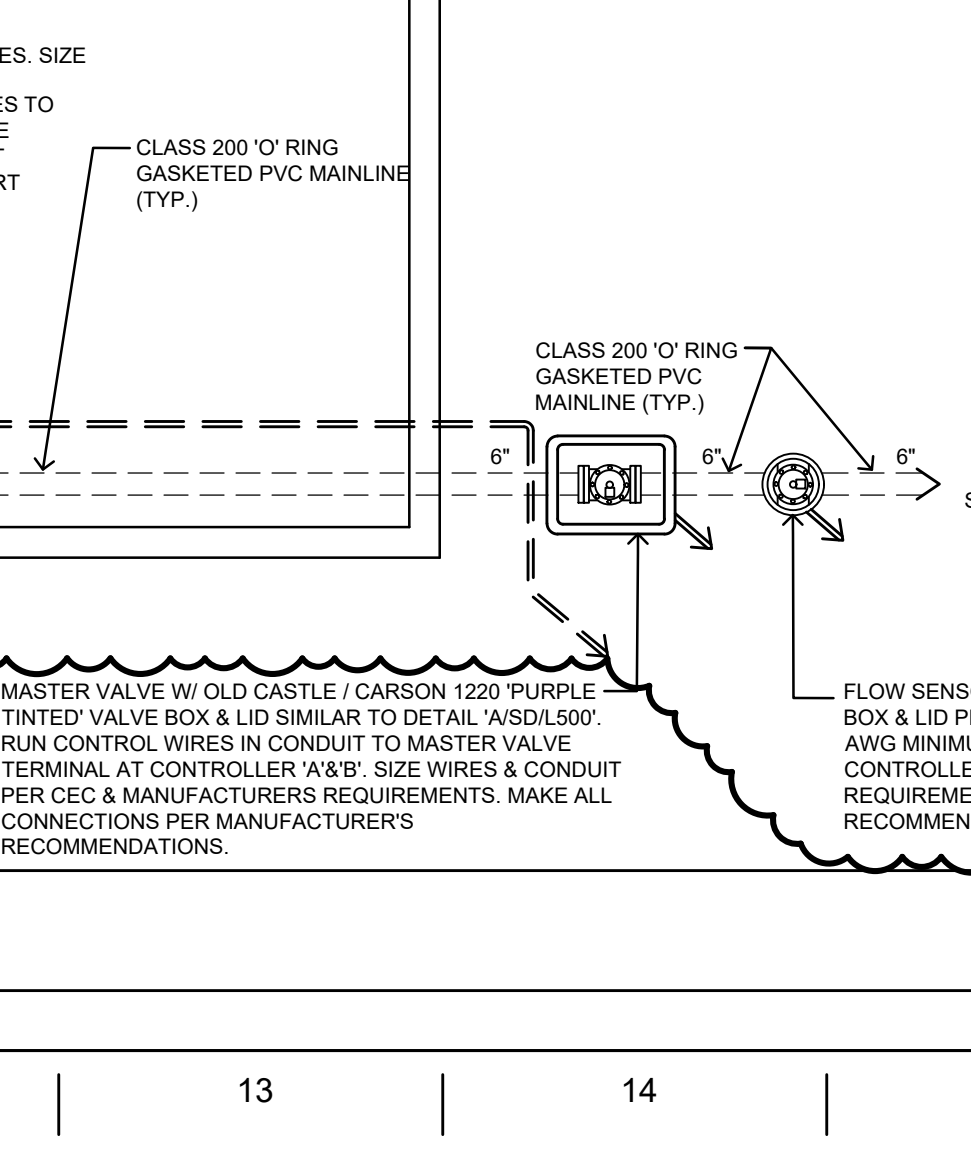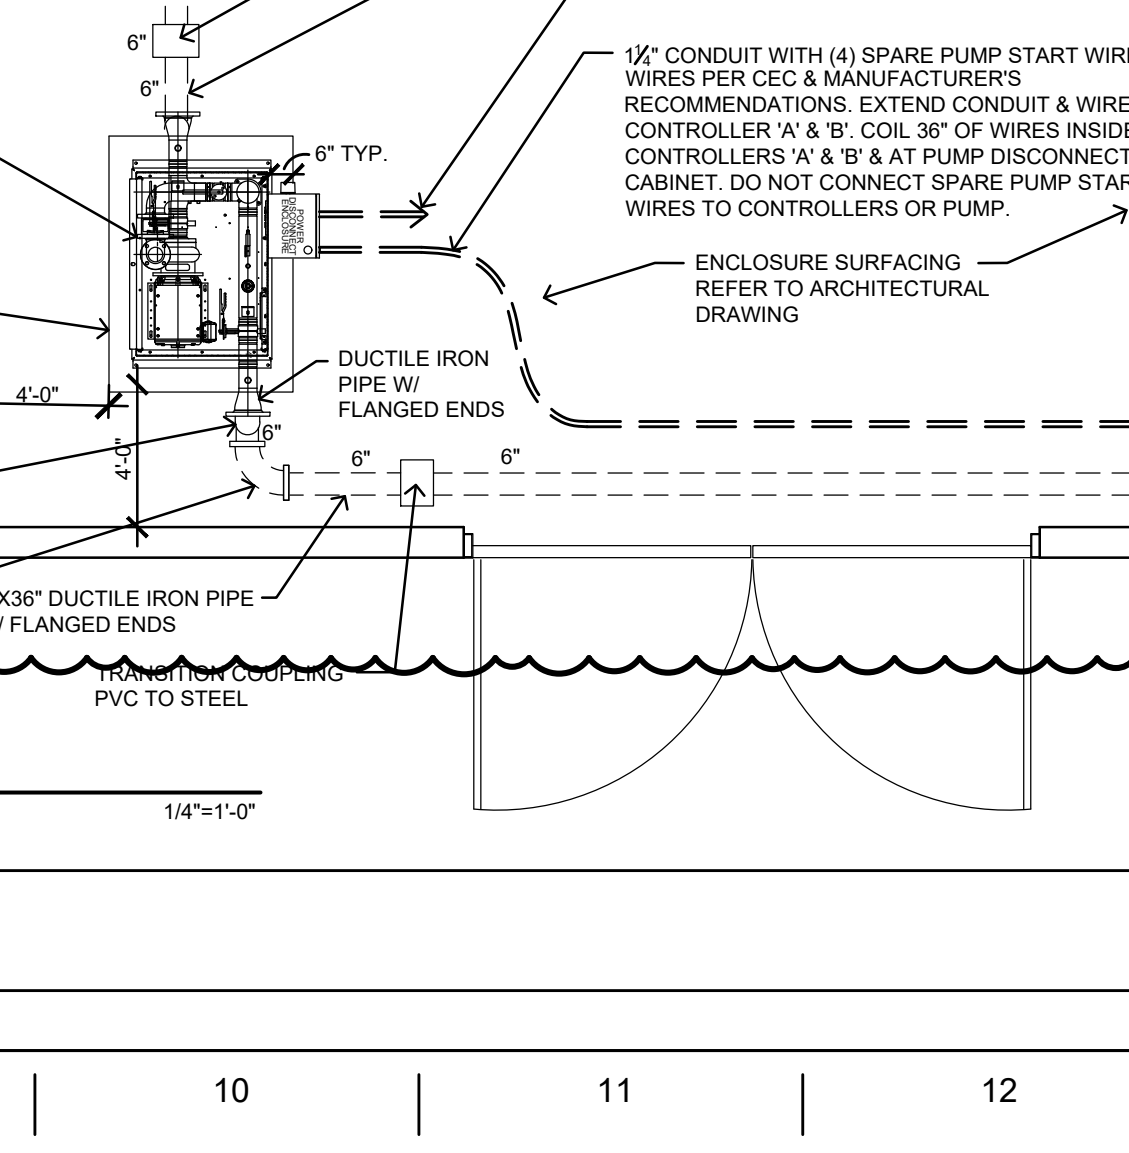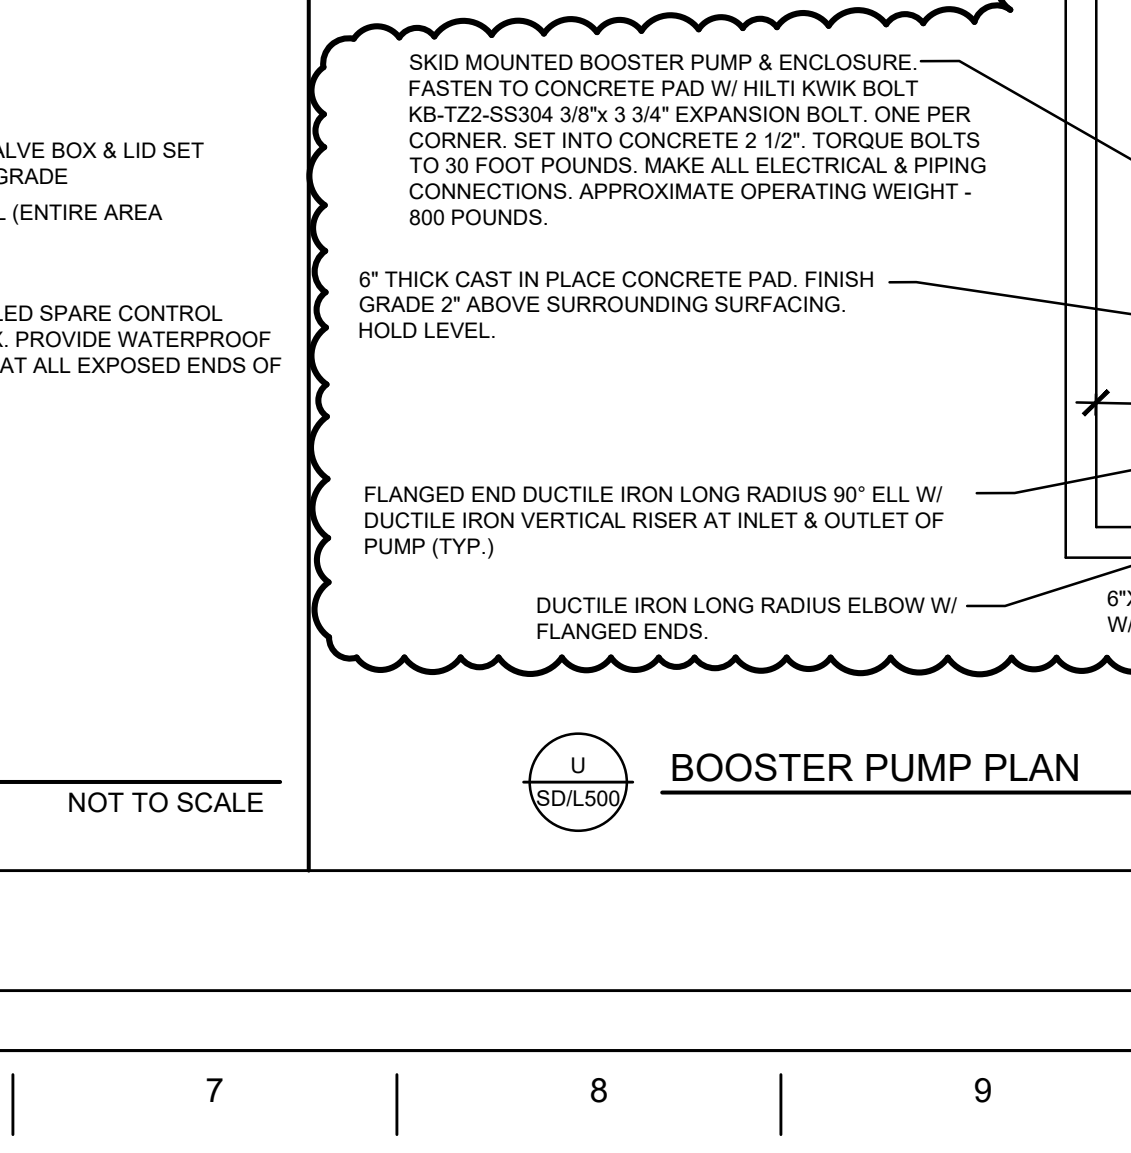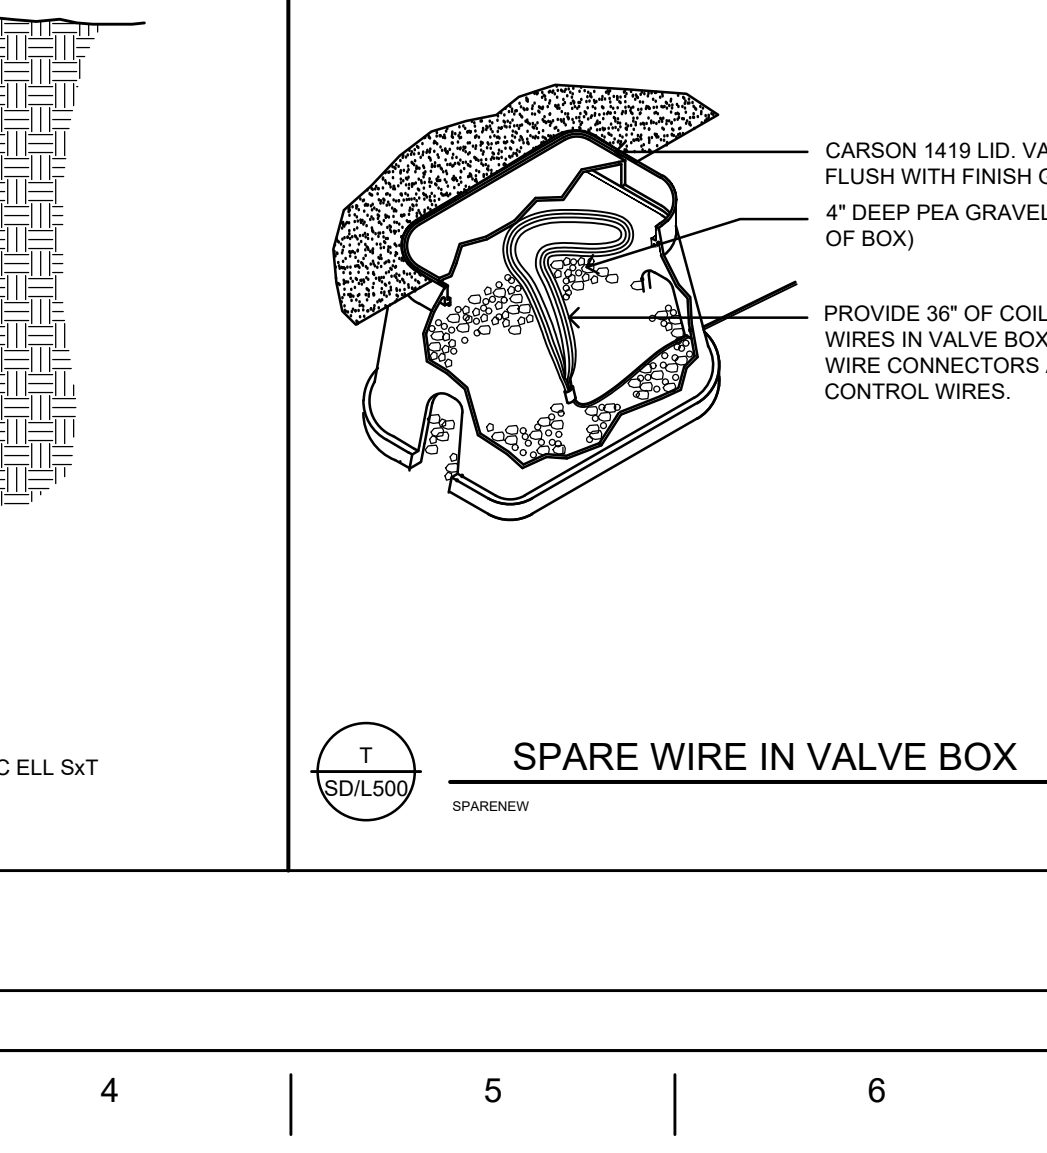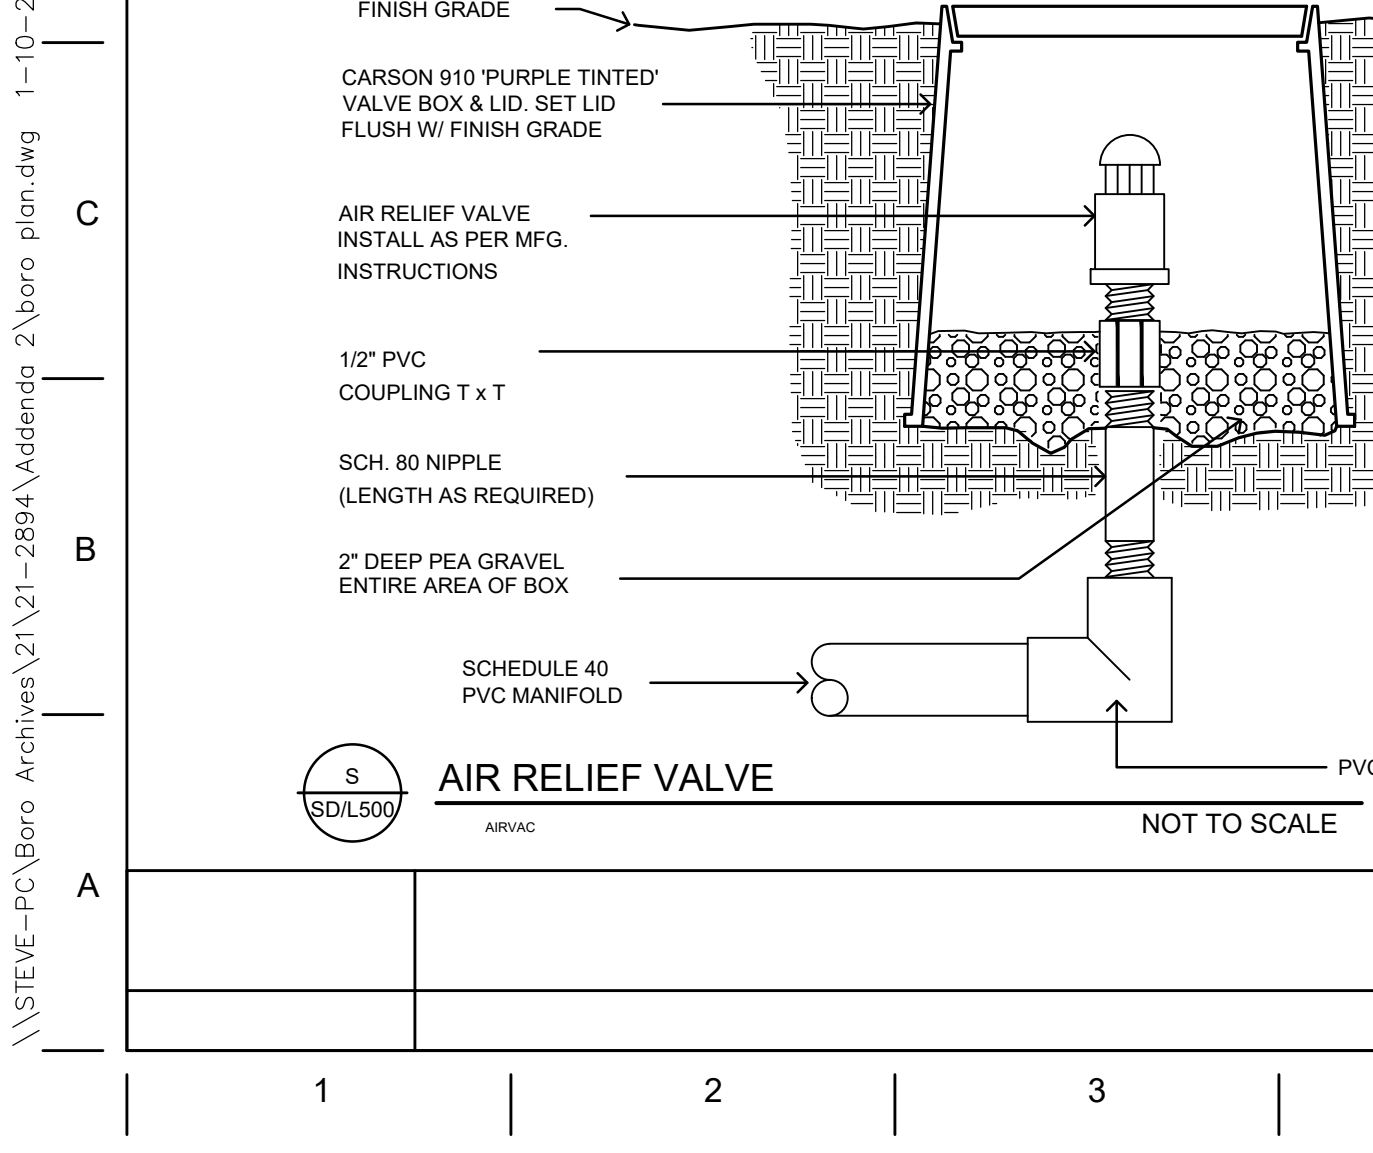

ADDENDA 2

01/10/24

Revision

Designed By: Copyright Darden Architects

Scale: AS NOTED


Drawn By: AD2-LX-05

Project Number: 2118


Checked By: SD/L500

Date: 05-10-23


Reviewed By: AD2-LX-05

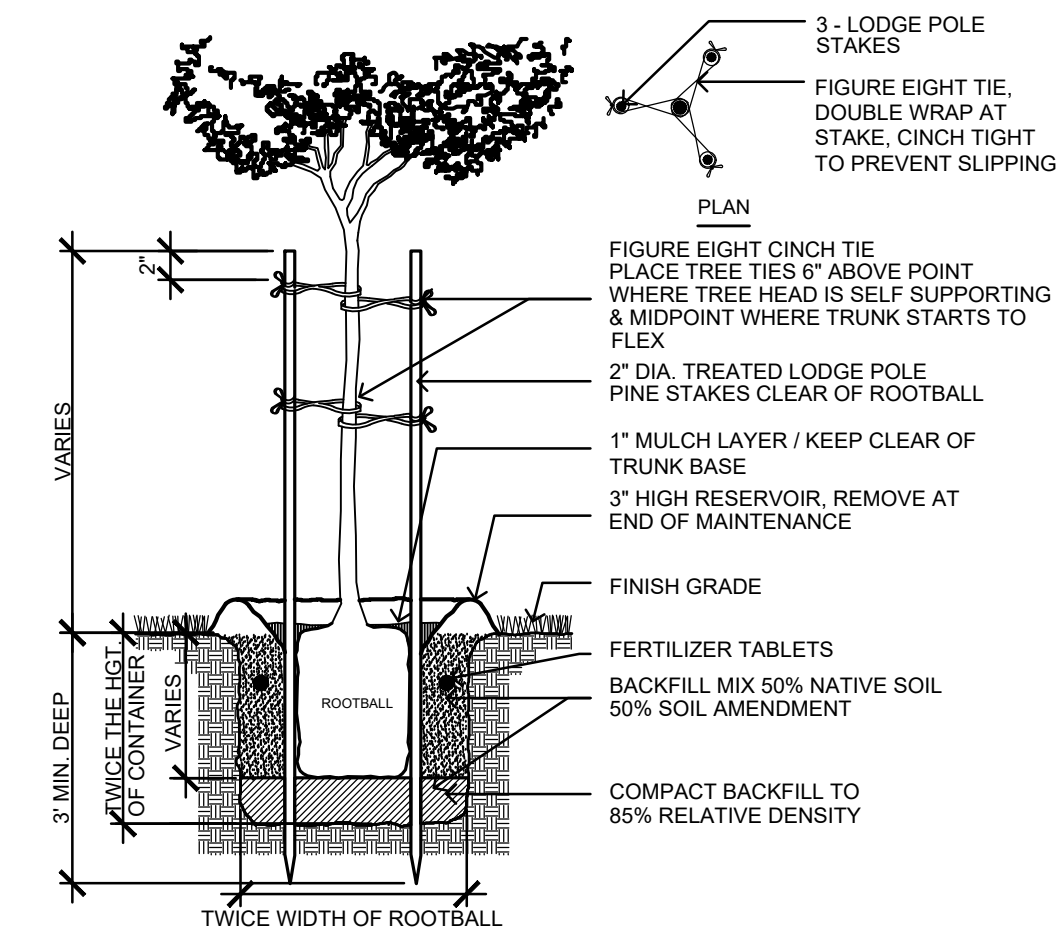


A TREE PLANTING / TRIPLE STAKE
NOT TO SCALE

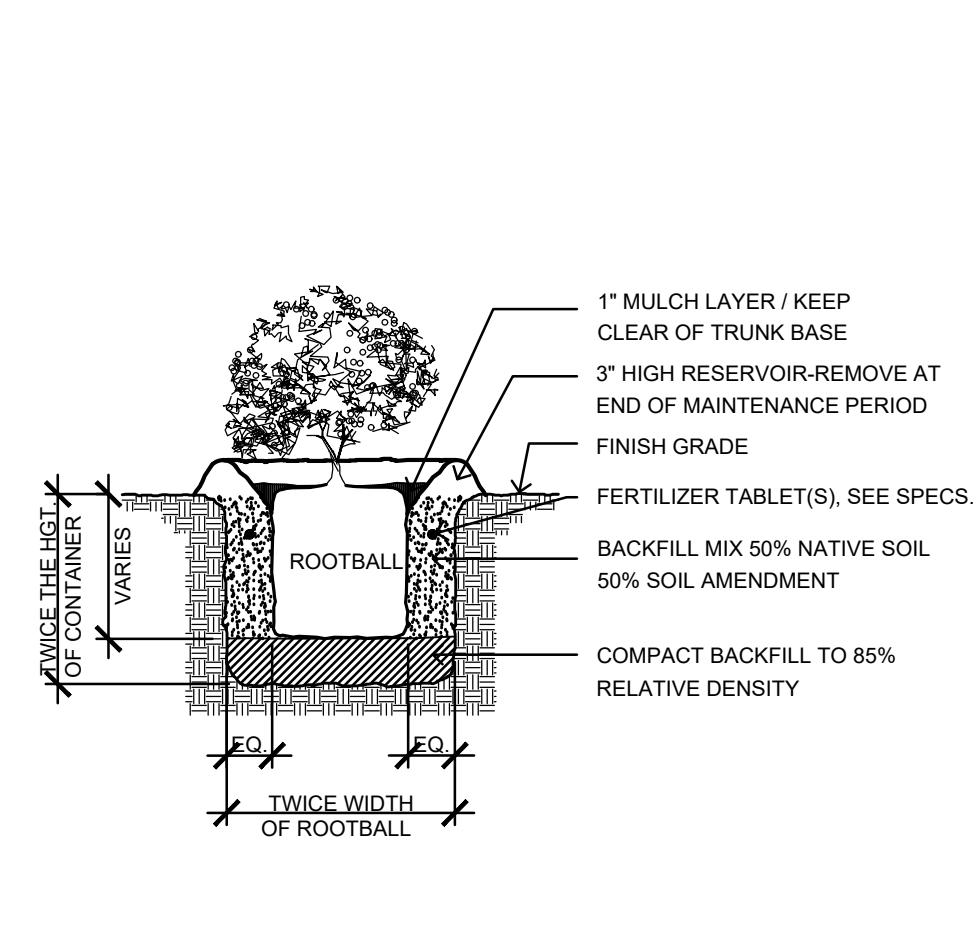


B SHRUB PLANTING
NOT TO SCALE

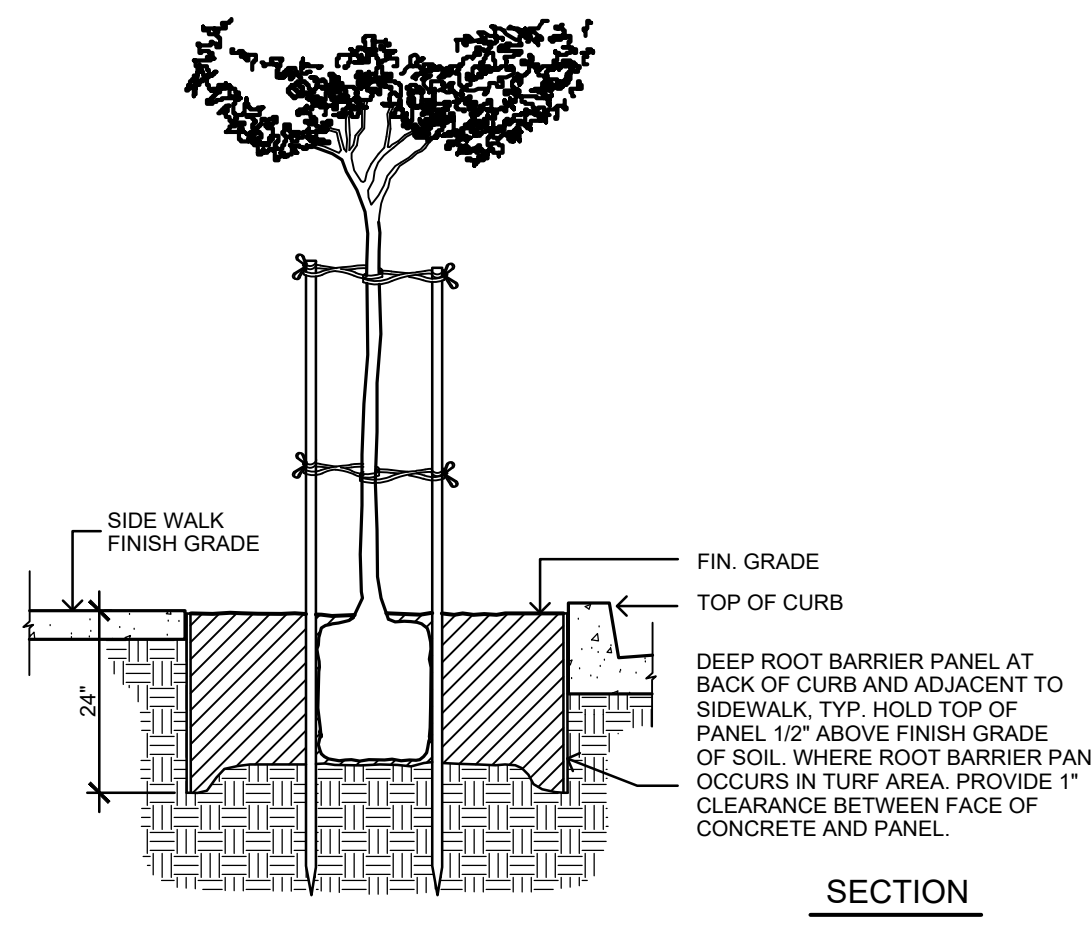


C ROOT BARRIER INSTALLATION
NOT TO SCALE

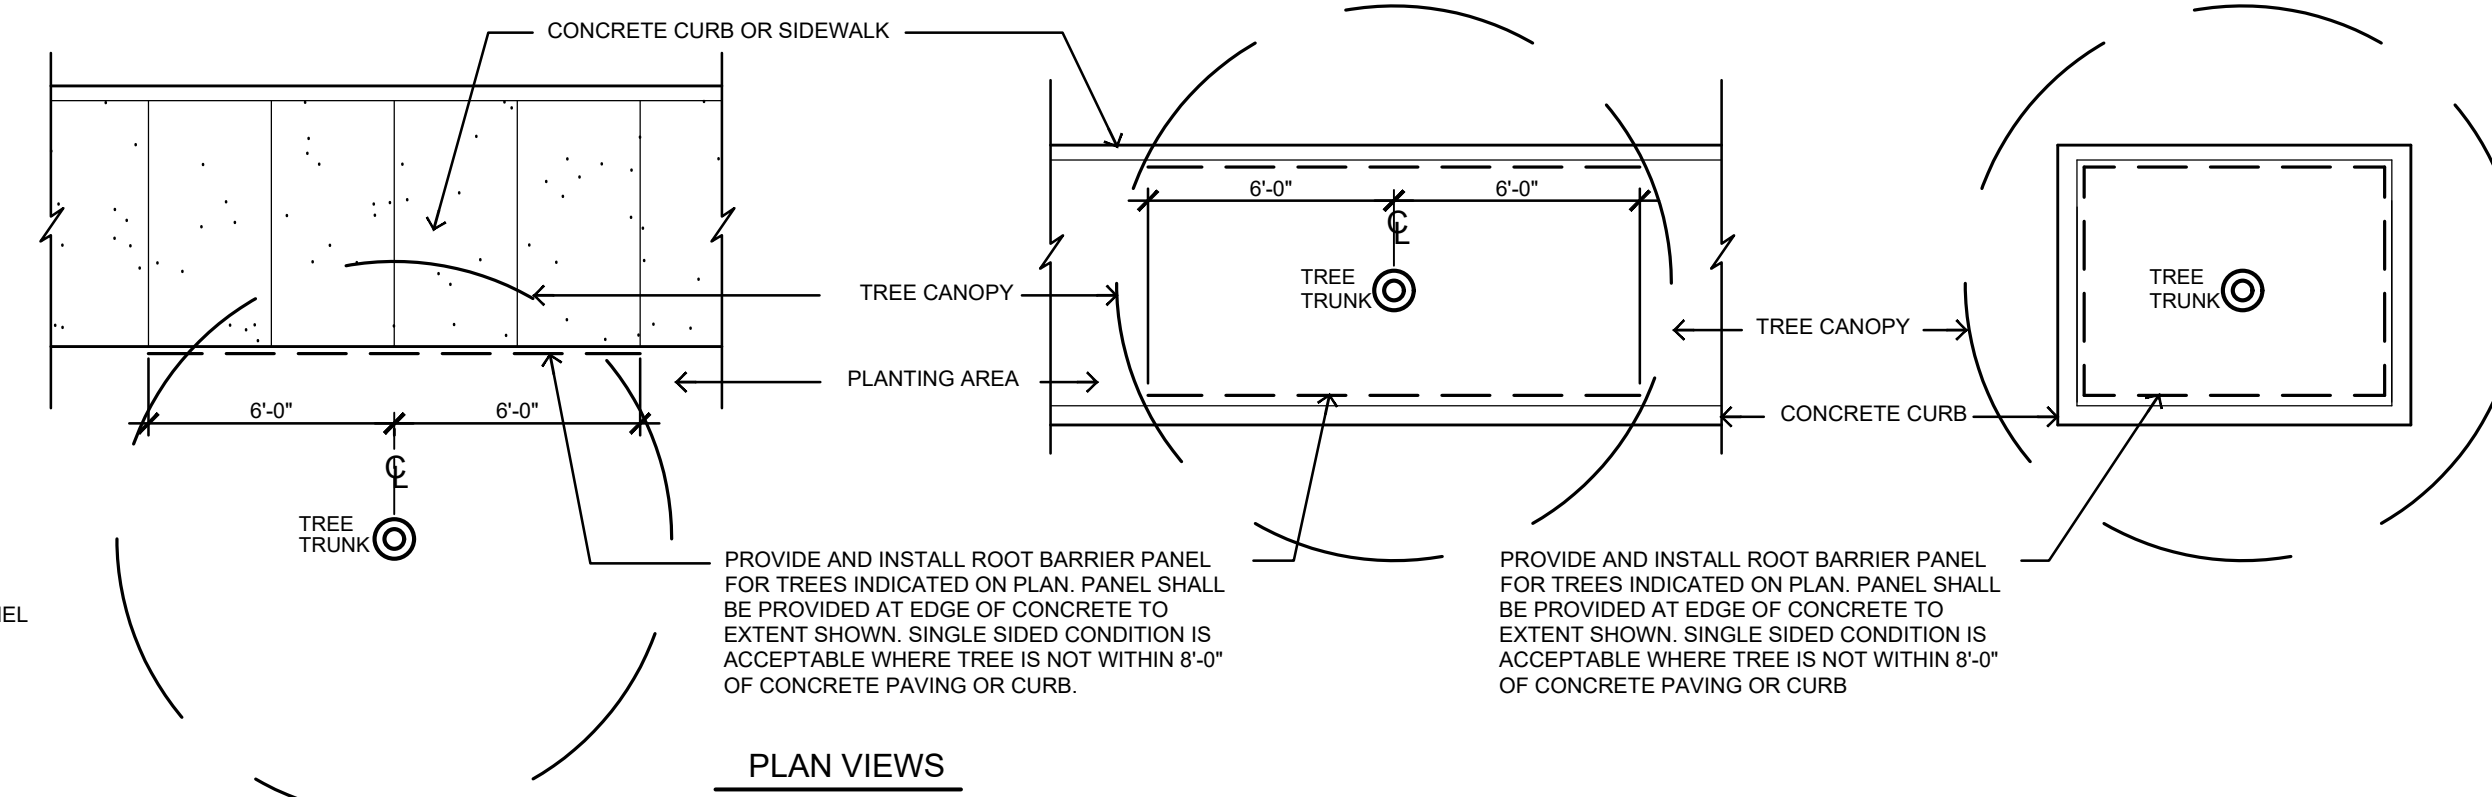


D RECLAIMED IRRIGATION WATER SWIVEL CONNECTION
NOT TO SCALE

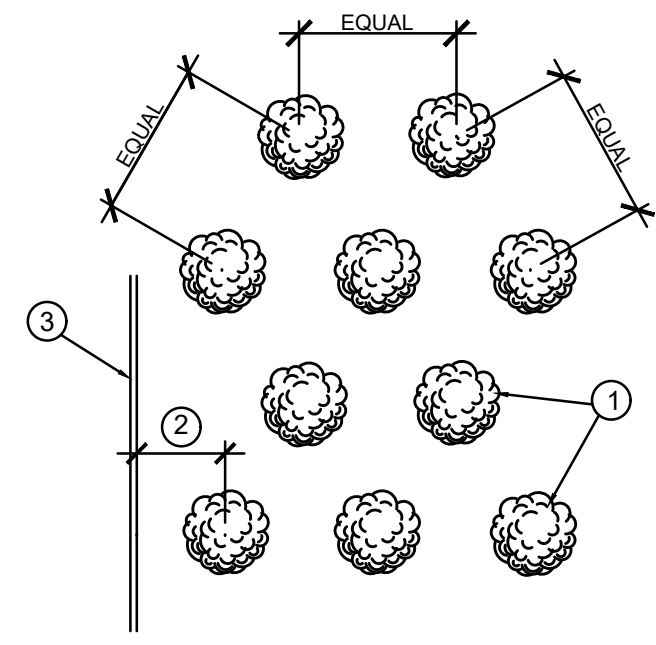

E GROUND COVER PLANTING
NOT TO SCALE

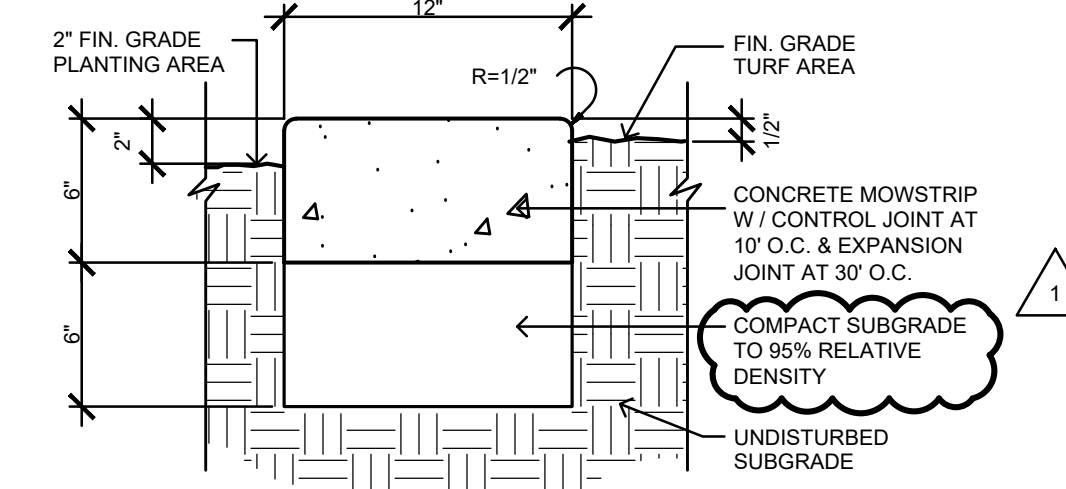

F CONCRETE MOWSTRIP
1 1/2\"/>

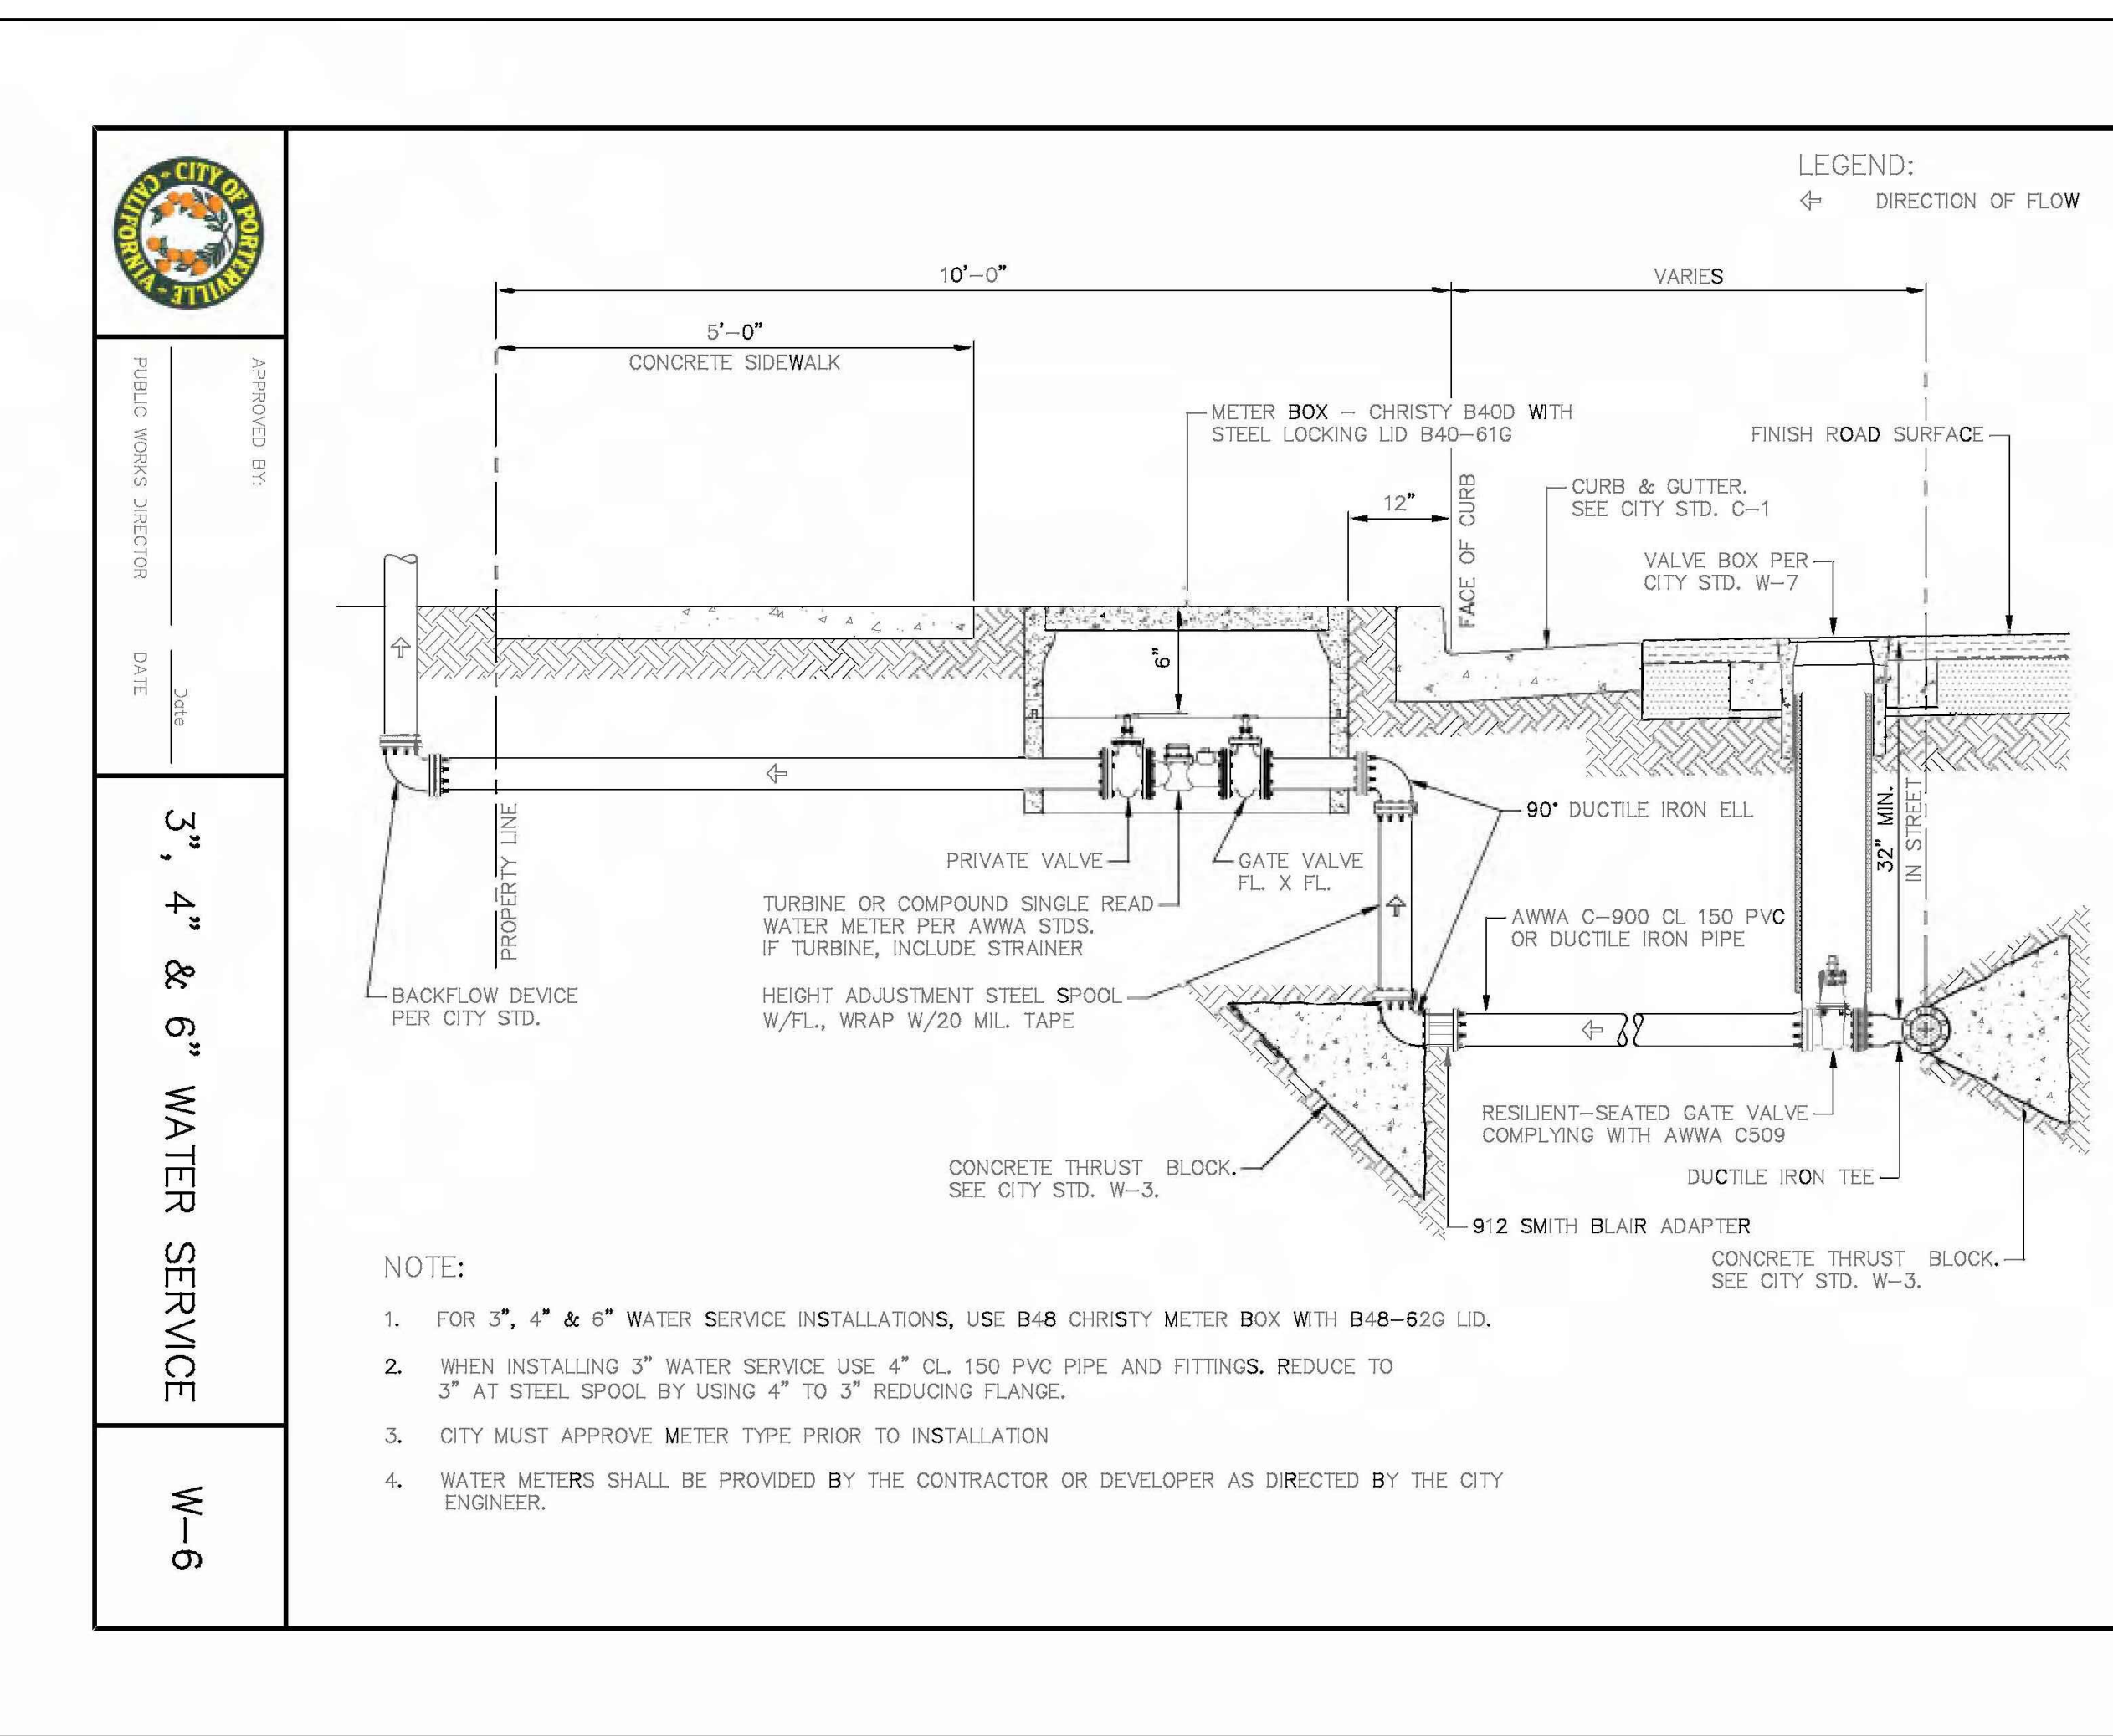

G CITY STANDARD WATER CONNECTION

DSA File No.:
DSA Application No.: 03-122694

Agency Approval

General Notes

ROBERT BORO
LANDSCAPE ARCHITECT
P.O. Box 4734
Fresno, California 93744
TEL: (559) 266-4367
EMAIL: robertboro@comcast.net

Consultant

PORTERVILLE COLLEGE SPORTS COMPLEX - PHASE 1
KERN COMMUNITY COLLEGE DISTRICT
PORTERVILLE, CA. Project

PLANTING DETAILS
Drawing

darden ARCHITECTURE
PLANNING
INTERIORS
architects www.dardenarchitects.com
6790 N. West Ave. • Fresno, CA 93711 • T. 559.448.8051

Architect

ADDENDA 2	01/10/24
Revision	
Scale: AS NOTED	Designed By: Copyright Darden Architects
Project Number: 2118	Drawn By: AD2-LX-06
Date: 05-10-23	Checked By: SD/L501
	Reviewed By: AD2-LX-06

\\STEVE-PC\PC\Boro Archives\21\21-2894\addenda 2\boro plan.dwg 1-10-24 09:05:54 AM Justin